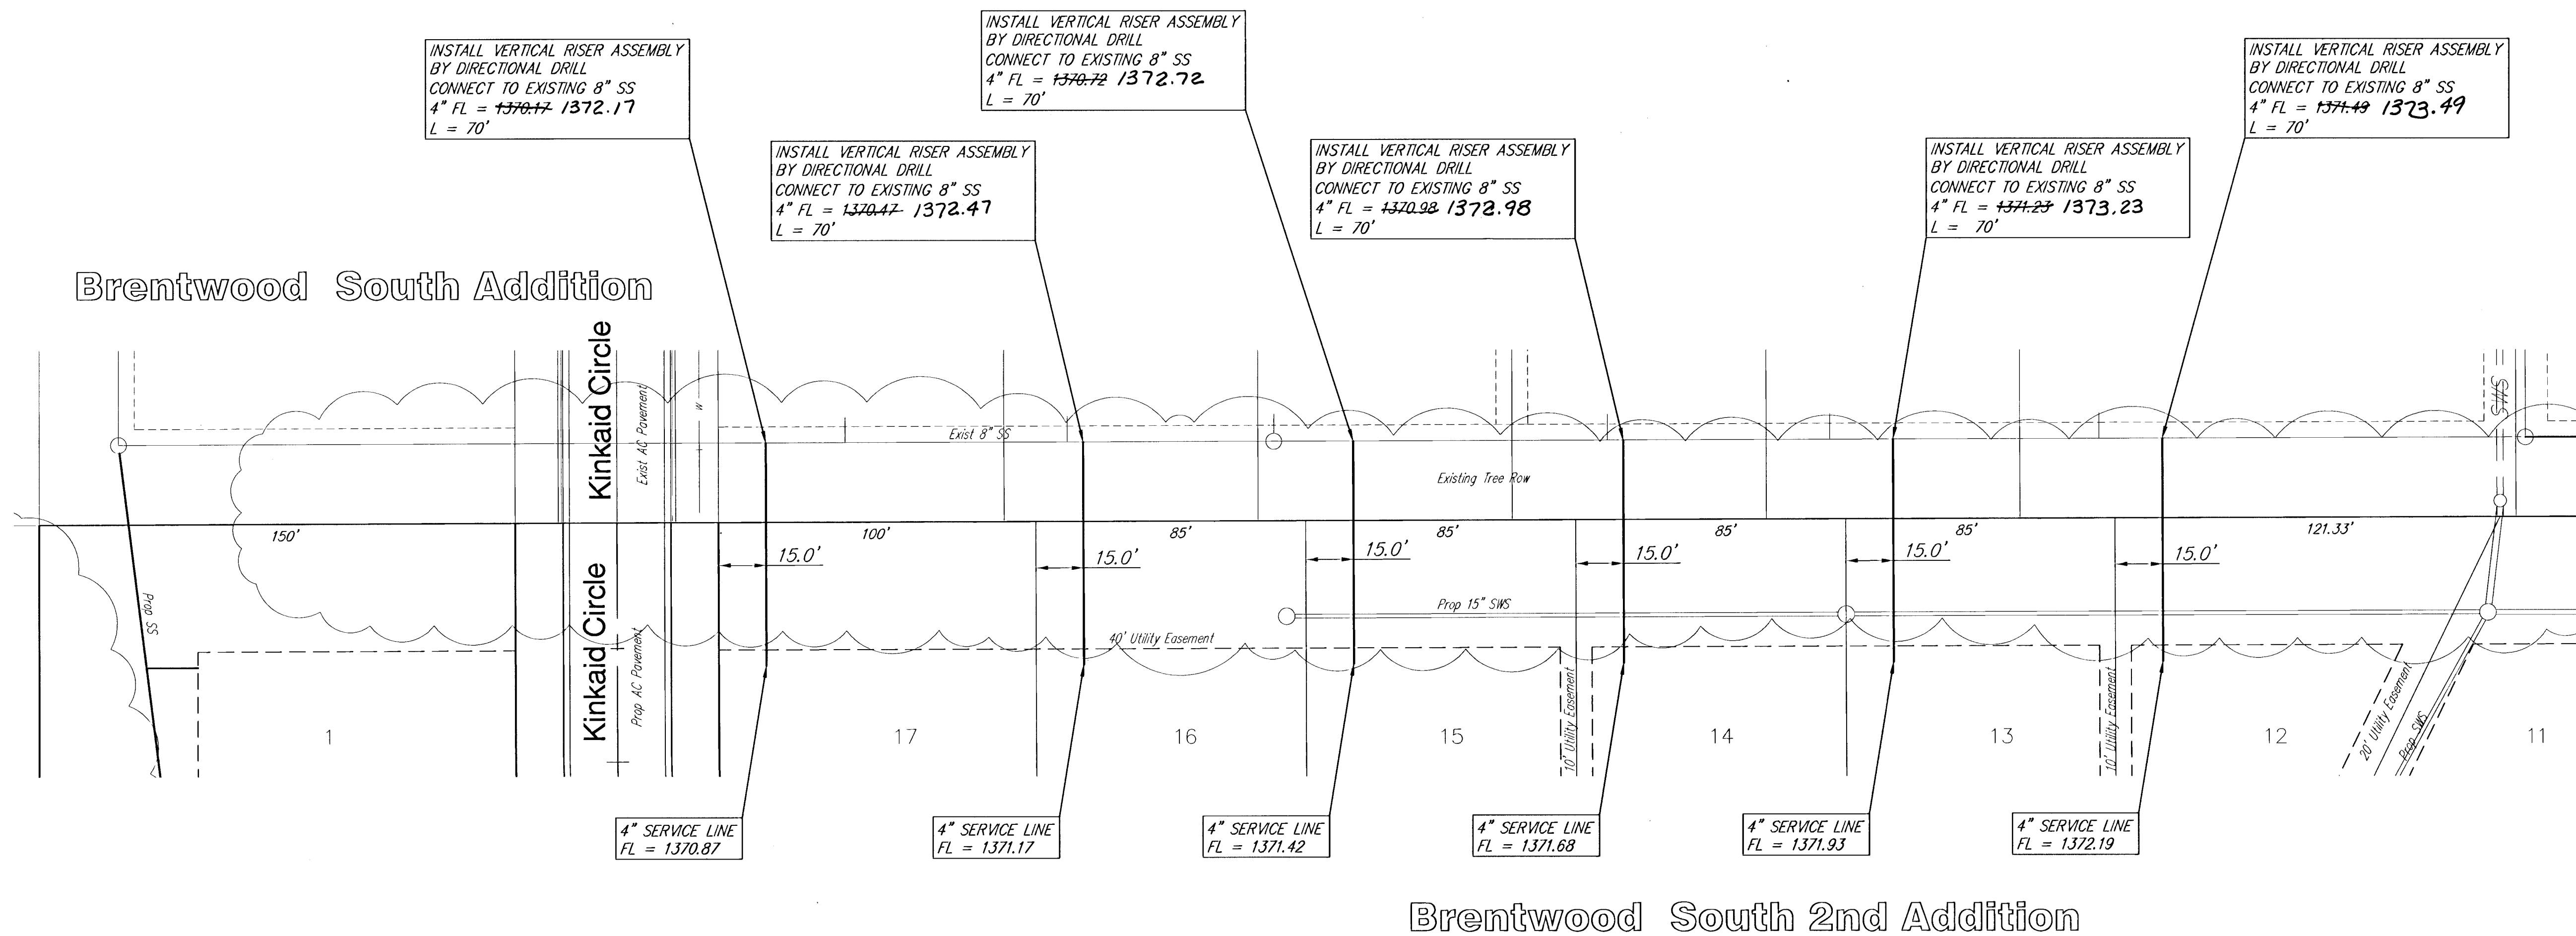
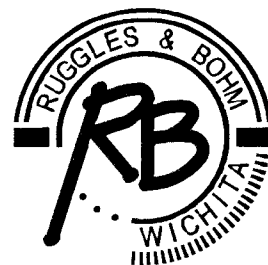


FOR VERTICAL RISER DETAILS SEE SHEET 9.

Brentwood South 2nd Addition Sanitary Sewer WICHITA, KANSAS			
 Ruggles & Bohm, P.A. Engineering, Surveying, Land Planning 924 North Main Wichita, Kansas 67203 www.rbkansas.com	DESIGN CMB	NO. JOB 2006	
	DRAWN EUG		
	REVIEW		
	UTILITY		
DRAWING FILE SS {SS03}	PROJECT NUMBER 468-83802	DATE July 13, 2004	SHEET 4 OF 13