LAT. 4, MAIN 4, NORTHWEST INTERCEPTOR
SANITARY SEWER EXTENSION
LOTS 1-24, BLOCK 1; LOTS 1-6, 18-19 BLOCK 2; LOTS 1-20, BLOCK 3
CHERYL'S HOLLOW ADDITION
PROJECT NO. 468-83937
O.C.A. NO. 744100

GENERAL NOTES

Contractor will be required to provide a minimum advance notice of twenty-four (24) hours to utility companies prior to starting any excavation as follows:

Kansas One-Call	*687-2470*

The Contractor must notify the following in case of an emergency:

Cox Communications	*262-0661*
Kansas Gas Service	*383-8600*
Westar	*383-8600*
Peoples Natural Gas Company	*1-800-303-0357*
Southwestern Bell Telephone Company	*1-800-286-8313*
City of Wichita Water Department	*262-6000*
City of Wichita Sewer Maintenance	*262-6000*

Underground utility service lines and overhead utility pole lines are to be adjusted as necessary by others prior to construction unless the plans specifically call for their adjustment by the Contractor or unless the plans specifically identify a utility to be adjusted by its owner during construction. Existing utilities and their location, as shown on the plans, represent the best information obtainable for design. Location information has been obtained from the various utility companies and is either from company record drawings or company-provided field locations. The Contractor will be required to work around existing utilities within the right-of-way which do not conflict with proposed construction.

Rubble from the removal of miscellaneous structures and excess excavation which is to be wasted shall be disposed of on sites to be provided by the Contractor. These sites shall be approved by the Engineer as to suitability, appearance and site location. Locations that, in the opinion of the Engineer, will leave an unsightly appearance will not be approved.


All disposal sites must be approved by the Kansas Department of Health and Environment. Material either stockpiled or disposed of in a flood plain would require a Kansas State Board of Agriculture permit. Any material dumped in waters of the United States or wetlands is subject to U.S. Corps permitting regulations. Any material buried or stockpiled beyond approved of Engineers construction limits would require additional archeological investigations unless buried in a previously approved borrow location.

The Engineer shall take field ties to all quarter section corners. The Contractor shall set a City survey monument in the required location where such quarter section corners fall within the limits of pavement construction. Survey monuments will be furnished by the City. The Engineer will accurately located and install the iron at the quarter section corner. This work will not be paid for directly, but shall be considered subsidiary to the other pay items of work in the contract.

The Contractor shall notify pipeline companies at least 24 hours in advance of any work being performed across and/or adjacent to pipelines.

The Contractor shall give all property owners and/or tenants of developed property directly abutting the construction of this project a minimum of ten (10) days advance notice prior to start of construction.

The Contractor shall seed, fertilize and mulch all disturbed areas upon completion of construction. Incidental to the bid item for "Site Clearing and Restoration".

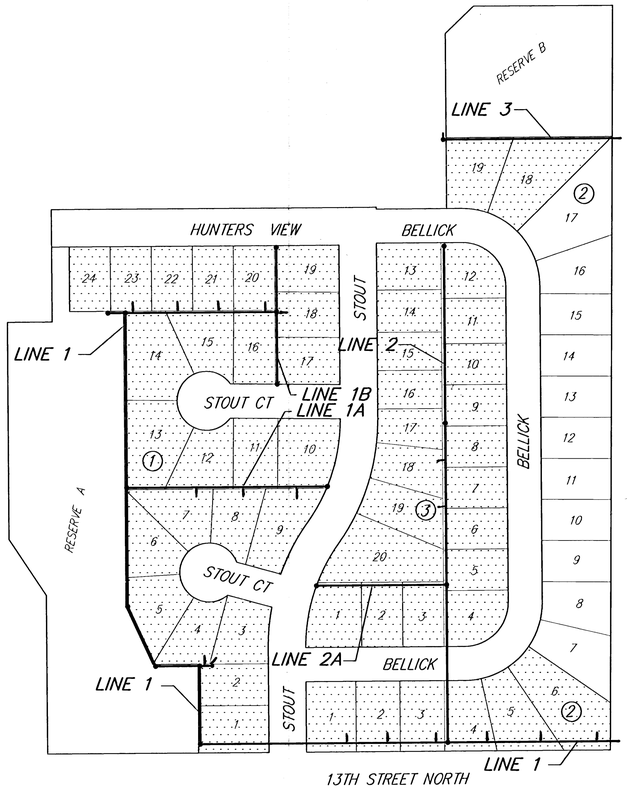


BENCH MARKS

BENCHMARK #1 *C.O.W. DISC 0.5 MILES SOUTH OF 13TH STREET NORTH CL OF 135TH STREET WEST ELEV. 1347.11*

BENCHMARK #2 *C.O.W. DISC 13TH STREET AND 135TH STREET WEST E. SIDE CONC BASE HLP 30' S & 35' W OF CL ELEV. 1355.65*

INDEX OF SHEETS

1. *TITLE SHEET*
2-3. *LINE 1 PLAN/PROFILE*
4. *LINE 1A & 1B PLAN/PROFILE*
5. *LINE 2 PLAN/PROFILE*
6. *LINE 2A & 3 PLAN/PROFILE*
7. *EASEMENT GRADING PLAN*
8. *MANHOLE RING AND COVER DETAILS*
9. *TYPE 'P' MANHOLE DETAIL*
10. *VERTICAL RISER DETAIL*
11. *FINAL PLAT*

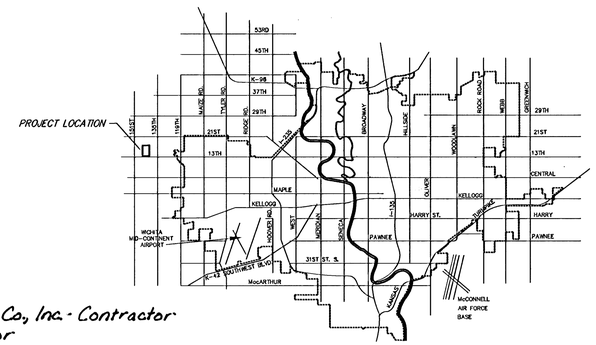

Duling Construction Co., Inc. - Contractor
Ward, City - Inspector
Released 12/10/05
As-Built
Risers + Stubs
.pdf by JOL 3/9/06

VICINITY MAP

IMPROVEMENT DISTRICT

KENNETH W. LEE
16373
5-4-05
KANSAS
PROFESSIONAL ENGINEER

CITY OF WICHITA, KANSAS
JAMES ARMOUR, P.E. - CITY ENGINEER

Ruggles & Bohm, P.A.
Engineering, Surveying, Land Planning
924 North Main (316) 264-8008
Wichita, Kansas 67203 (316) 264-4621 fax
www.rbkansas.com E-mail: info@rbkansas.com

2666E