

## SEWER SERVICE TABLE

| NUMBER | TYPE | SERVING LOT NO. | SERVING BLOCK NO. | SERVING LINE NO. | STATION \ DIRECTION | FOR INFORMATION ONLY: APPROXIMATE LENGTH 4" PIPE VERTICAL | HORIZONTAL |
|---|---|---|---|---|---|---|---|
| 1 | 8"x4" Saddle | 5 | 2 | 1 | 0+50, N ~~48.90~~ | 14' | ~~15'~~ 14.7 |
| 2 | 8"x4" Saddle | 5 | 2 | 1 | 1+50, N 50.2 | 14' | 15' |
| 3 | 8"x4" Saddle | 4 | 2 | 1 | 2+32, N 30.9 | 14' | ~~15'~~ 15.2 |
| 4 | 8"x4" Saddle | 3 | 2 | 1 | 3+20, N 18.29 | 14' | ~~15'~~ 14.8 |
| 5 | 8"x4" Saddle | 2 | 2 | 1 | 3+95, N 92.89 | 14' | ~~15'~~ 14.6 |
| 6 | 8"x4" Saddle | 1 | 2 | 1 | ~~4+70~~, N 70.99 | 13' | ~~15'~~ ~~14.1~~ |
| 7 | 8"x4" Saddle | 3 | 1 | 1 | ~~8+46.39~~, N 46.93 | 9' | ~~15'~~ 13.2' N+ 29.7' E of MH |
| 8 | 4" MH Stub | 4 | 1 | 1 | ~~8+46.39~~, N 46.93 | 9' | ~~15'~~ NA |

NOTE: Vertical Riser Pipe shall be extended to 2' minimum above ground water elevation and 4' maximum below proposed ground elevation.

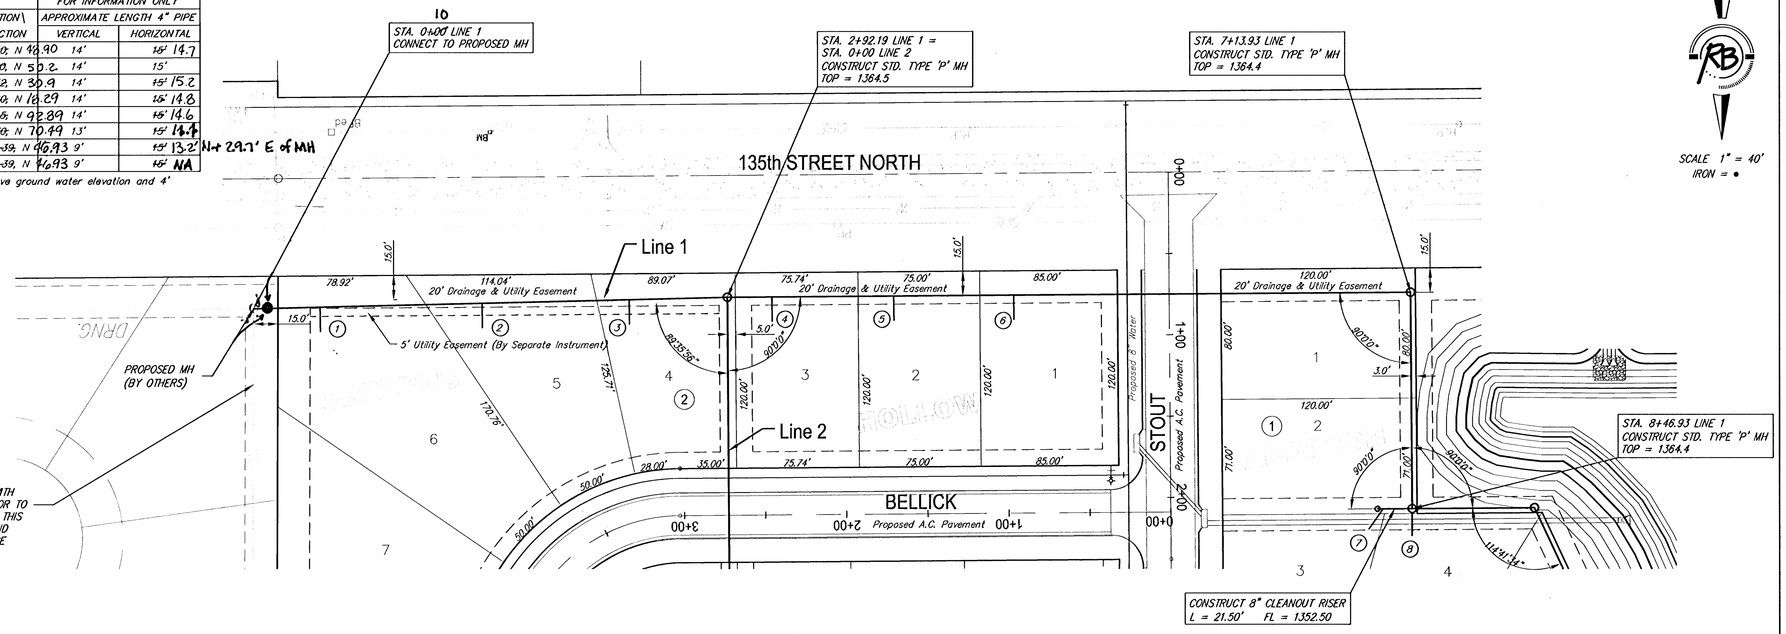

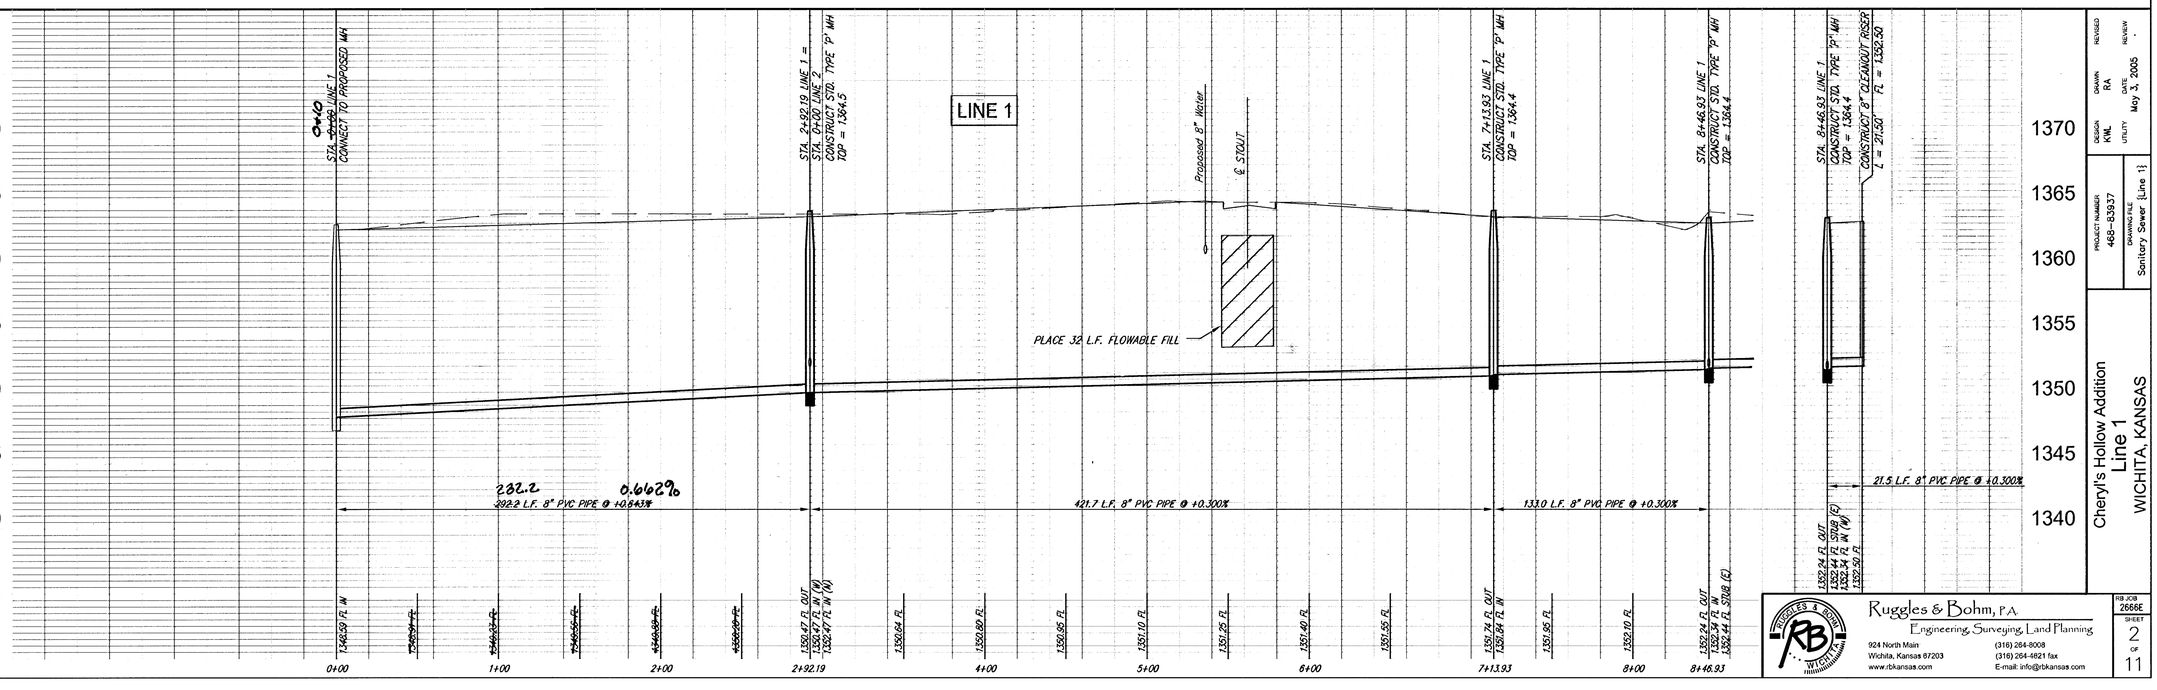

Ruggles & Bohm, P.A.
Engineering, Surveying, Land Planning
924 North Main
Wichita, Kansas 87203
www.rbkansas.com
(316) 264-8009
(316) 264-4621 fax
E-mail: info@rbkansas.com


| | |
|---|---|
| DESIGN | KWL |
| DRAWN | RA |
| REVISED | |
| DATE | May 3, 2005 |
| REVIEW | |
| UTILITY | |
| PROJECT NUMBER | 468-83937 |
| DRAWING FILE | Sanitary Sewer [Line 1] |

Cheryl's Hollow Addition
Line 1
WICHITA, KANSAS

RB JOB 2666E
SHEET 2 OF 11