
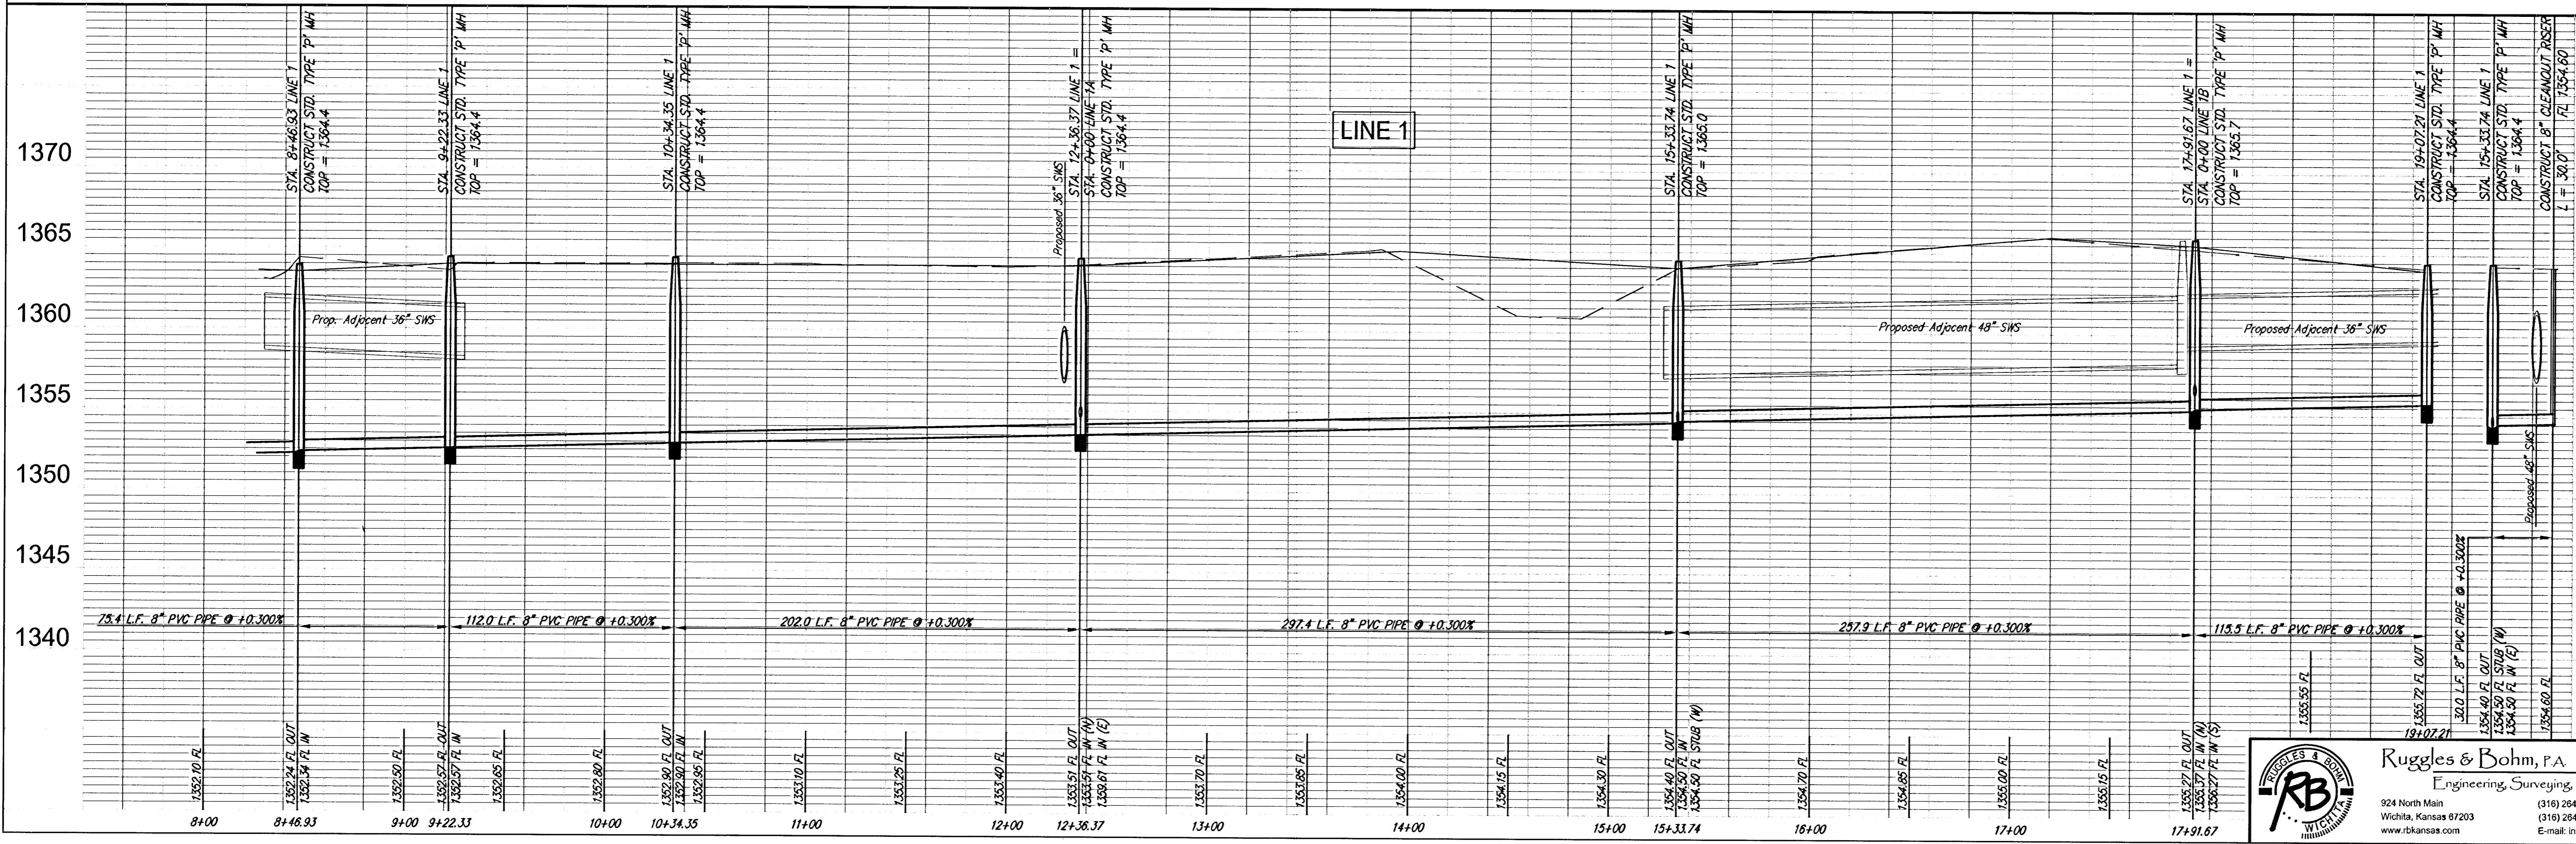
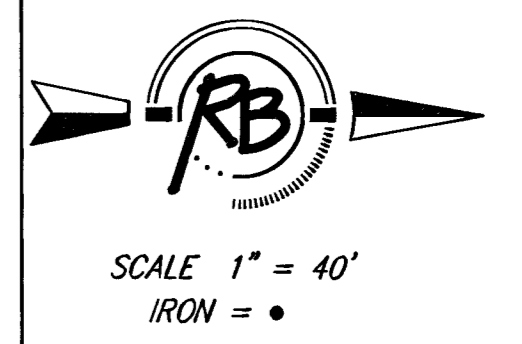


SEWER SERVICE TABLE

NUMBER	TYPE	SERVING			FOR INFORMATION ONLY	
		LOT NO.	BLOCK NO.	LINE NO.	STATION\ DIRECTION	APPROXIMATE LENGTH 4" PIPE VERTICAL HORIZONTAL
9	8"x4" Saddle	23	1	1	15+60+ N 17.24 9'	+5' 13.5
10	8"x4" Saddle	22	1	1	16+15+ N 16.54 9'	+5' 14.6
11	8"x4" Saddle	21	1	1	16+00+ N 20.94 9'	+5' 18.9
12	8"x4" Saddle	20	1	1	17+45+ N 17.94 9'	+5' 15.2
13	4" Manhole Stub	18	1	1	17+94.67 E 9'	+5' NA
					18+06.77	

NOTE: Vertical Riser Pipe shall be extended to 2' minimum above ground water elevation and 4' maximum below proposed ground elevation.

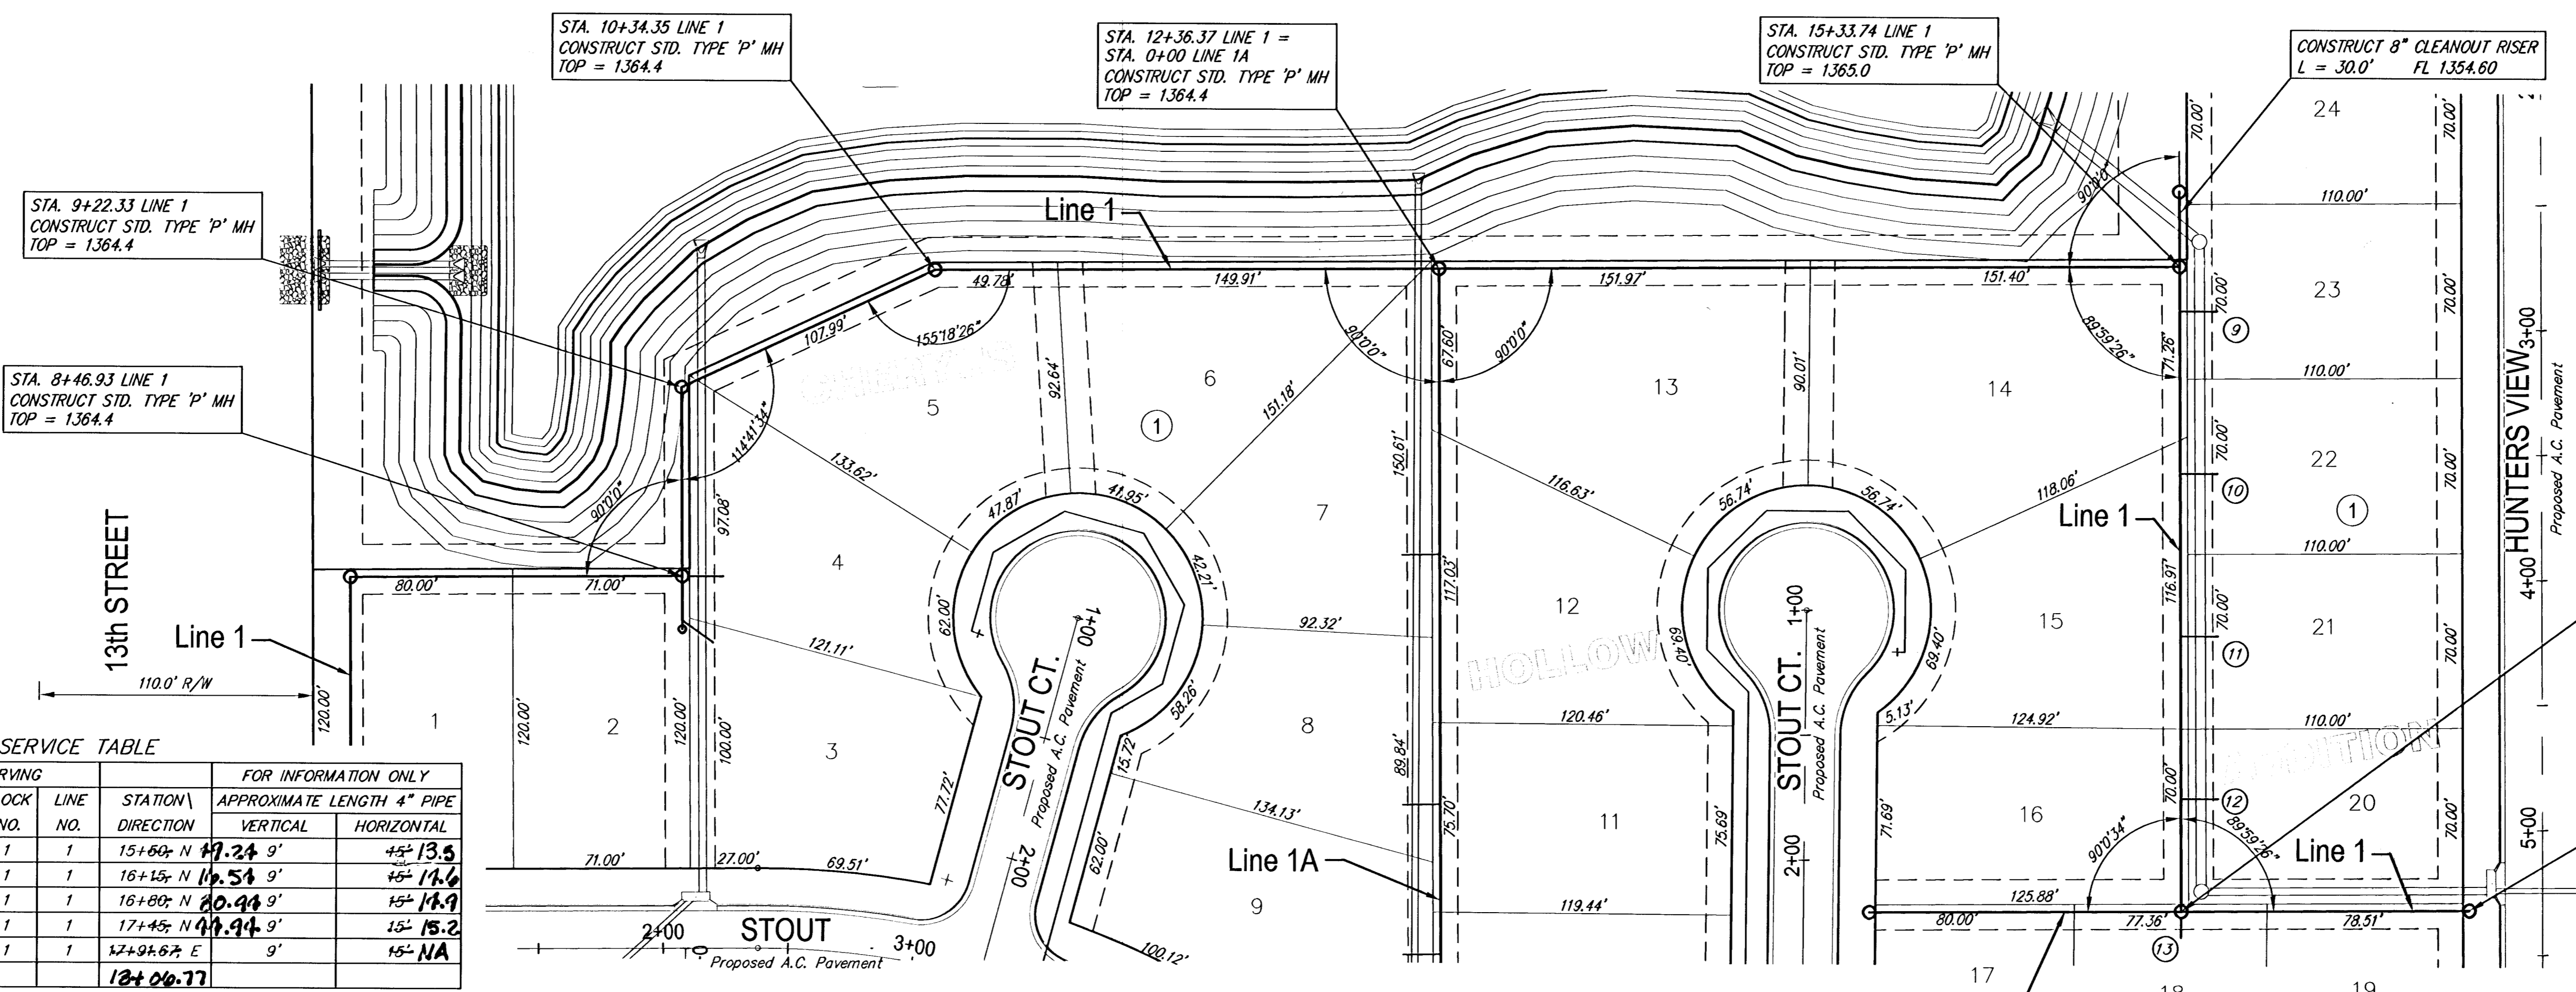

REVISION	DATE	BY	CHKD
PROJECT NUMBER	468-83937	DRAWING FILE	Sanitary Sewer (Line 1)
DATE	May 3, 2005		
Cheryl's Hollow Addition Line 1 WICHITA, KANSAS			
PROJECT NUMBER	468-83937	DRAWING FILE	Sanitary Sewer (Line 1)
DATE	May 3, 2005		
PROJECT NUMBER	468-83937	DRAWING FILE	Sanitary Sewer (Line 1)
DATE	May 3, 2005		