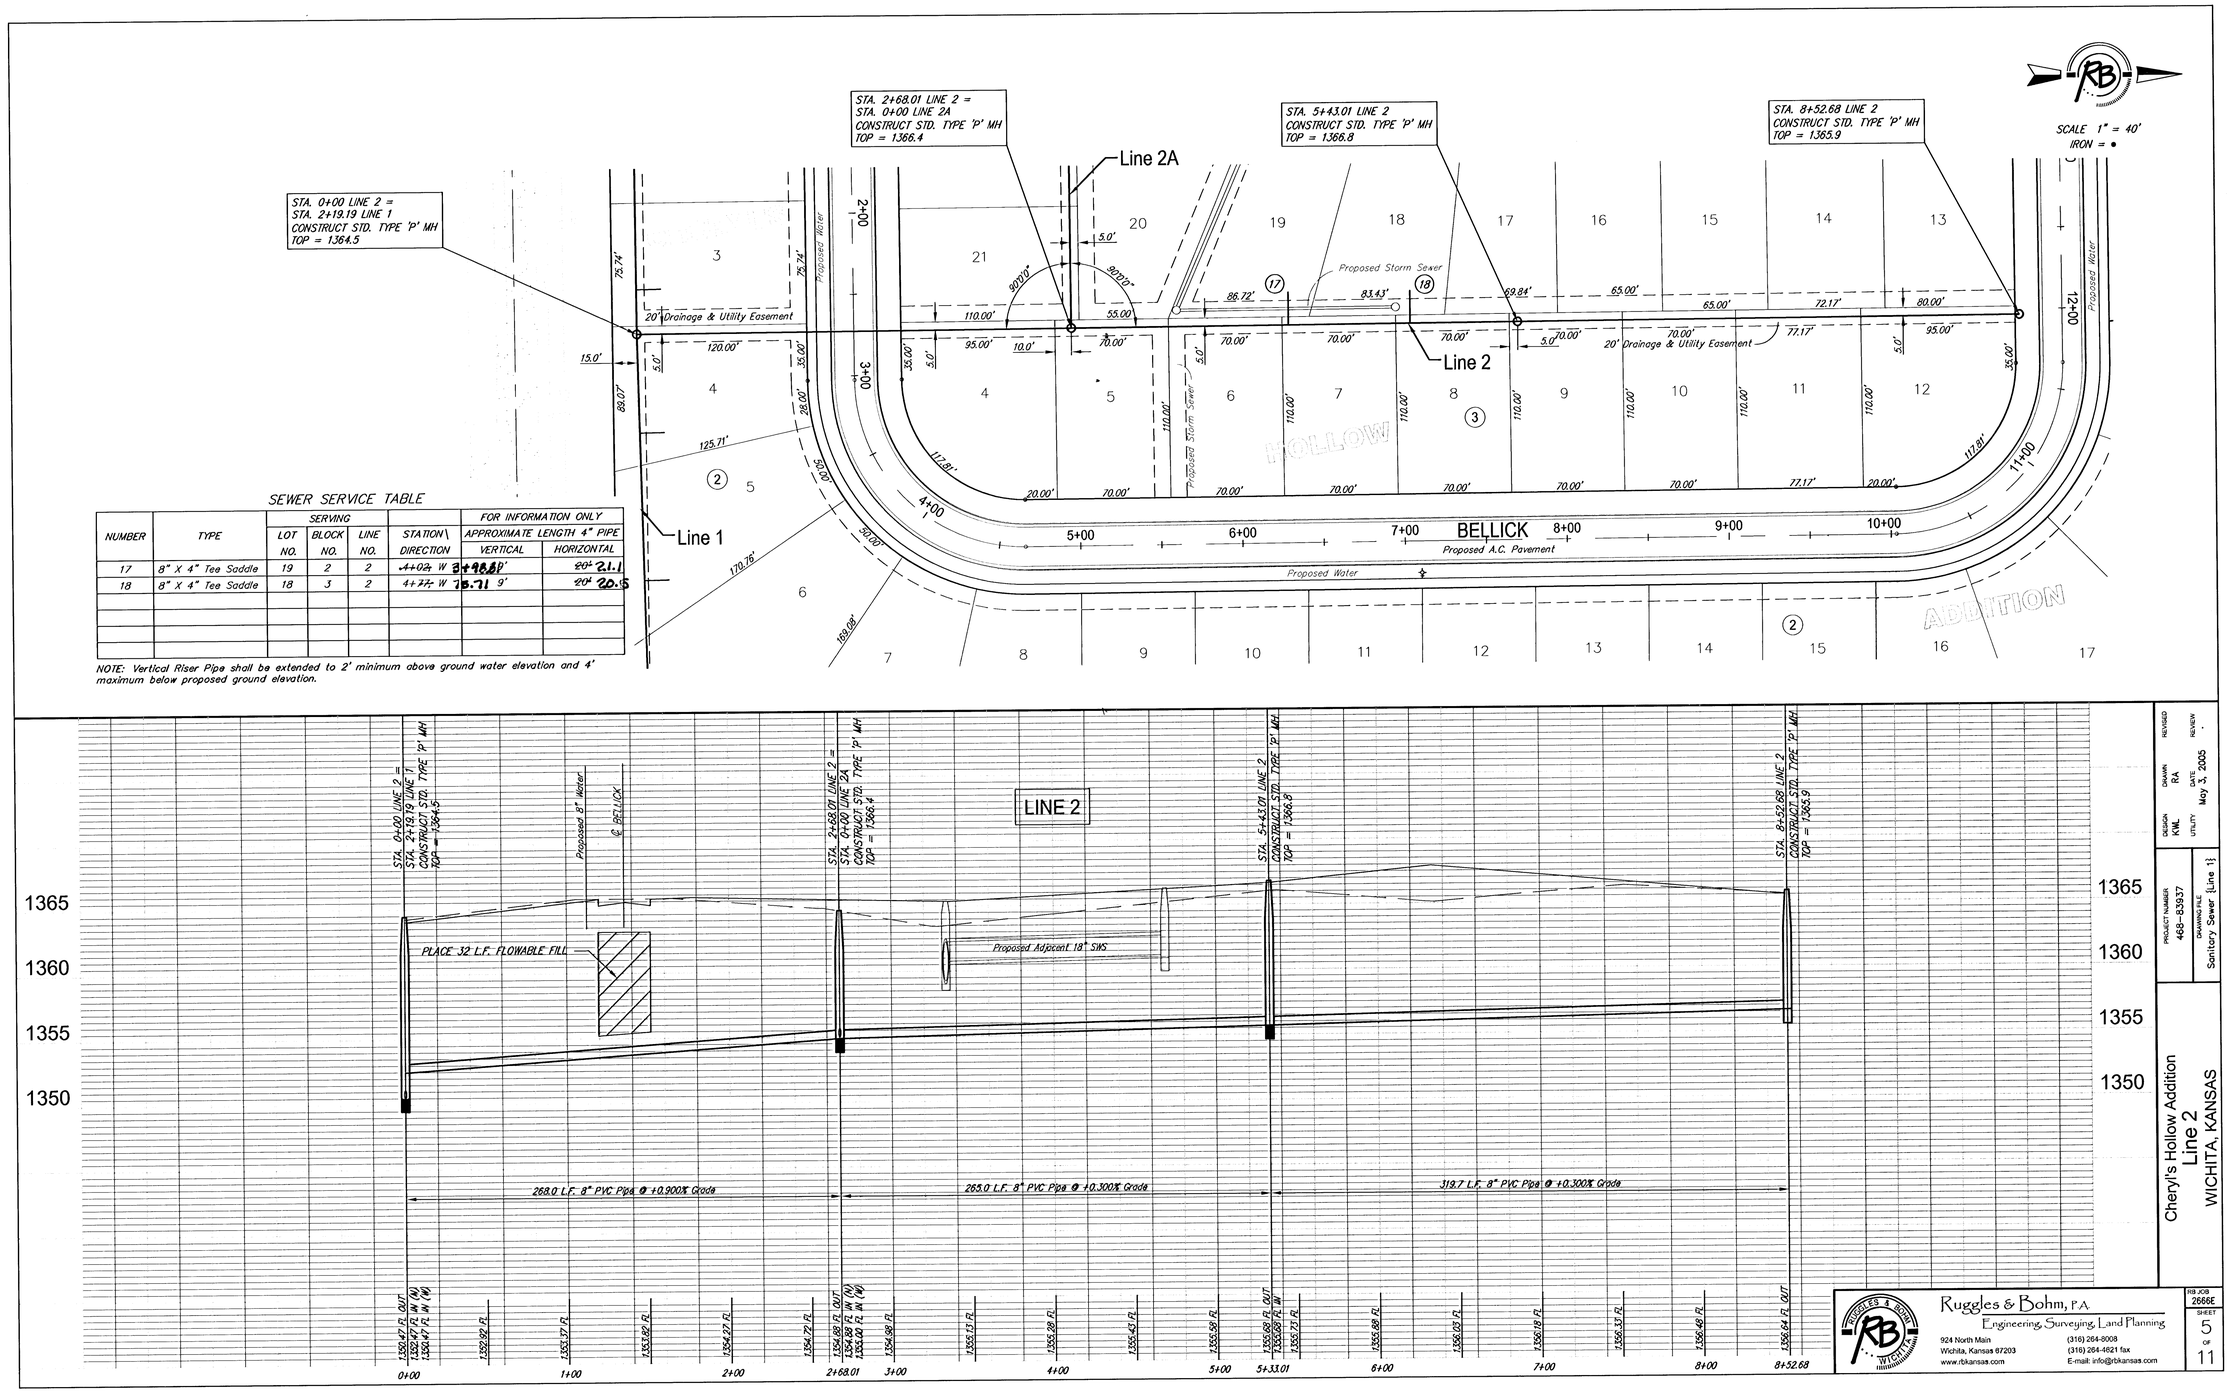

SEWER SERVICE TABLE

NUMBER	TYPE	SERVING LOT NO.	SERVING BLOCK NO.	SERVING LINE NO.	STATION\ DIRECTION	FOR INFORMATION ONLY APPROXIMATE LENGTH 4" PIPE VERTICAL	FOR INFORMATION ONLY APPROXIMATE LENGTH 4" PIPE HORIZONTAL
17	8" X 4" Tee Saddle	19	2	2	~~4+02~~ W 3+98.8	~~20'~~ 9'	~~20'~~ 21.1
18	8" X 4" Tee Saddle	18	3	2	4+~~77~~ W 75.71	~~20'~~ 9'	~~20'~~ 20.5

NOTE: Vertical Riser Pipe shall be extended to 2' minimum above ground water elevation and 4' maximum below proposed ground elevation.

DESIGN	KWL
DRAWN	RA
REVISED	
UTILITY	
DATE	May 3, 2005
REVIEW	
PROJECT NUMBER	468-83937
DRAWING FILE	Sanitary Sewer (Line 1)

Cheryl's Hollow Addition
Line 2
WICHITA, KANSAS

Ruggles & Bohm, P.A.
Engineering, Surveying, Land Planning
924 North Main
Wichita, Kansas 67203
www.rbkansas.com
(316) 264-8008
(316) 264-4621 fax
E-mail: info@rbkansas.com

RB JOB 2666E

SHEET 5 of 11