


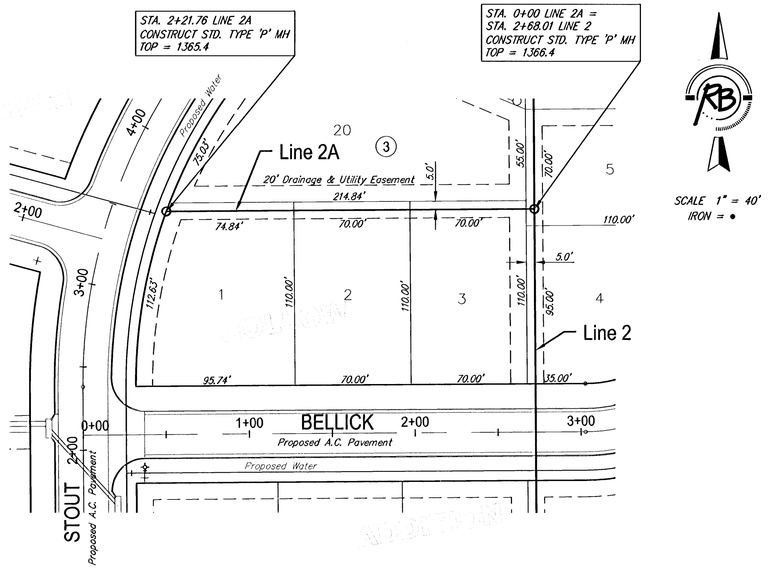


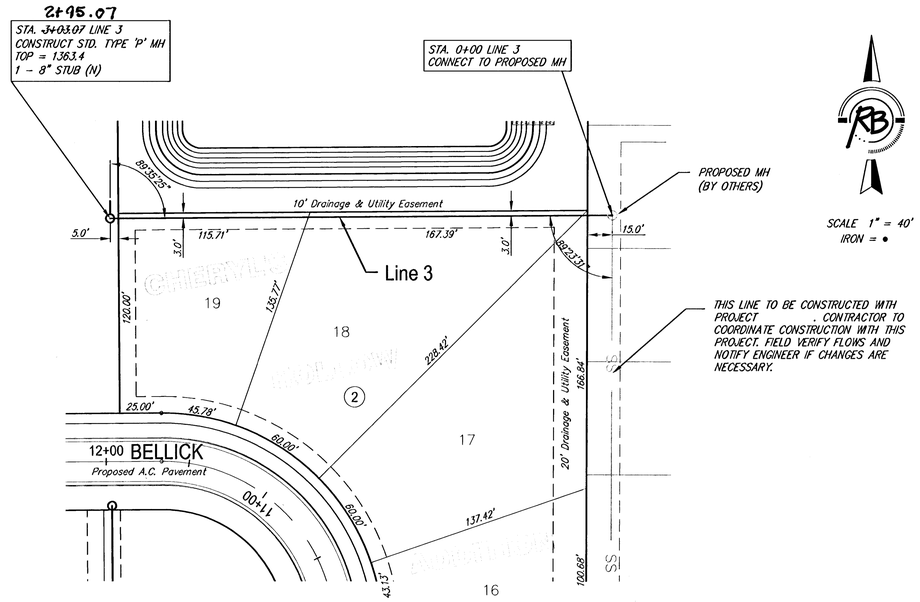

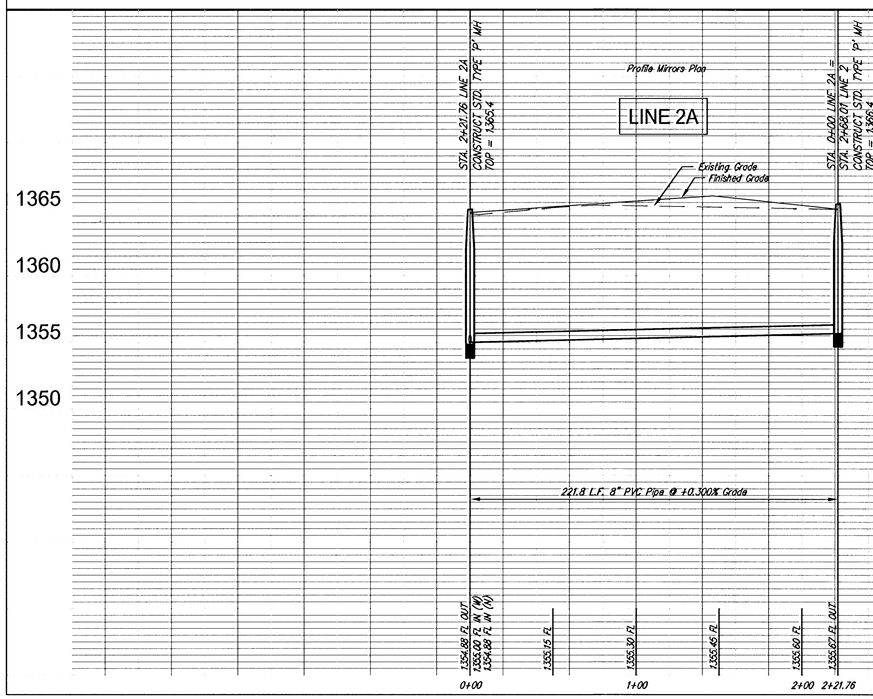

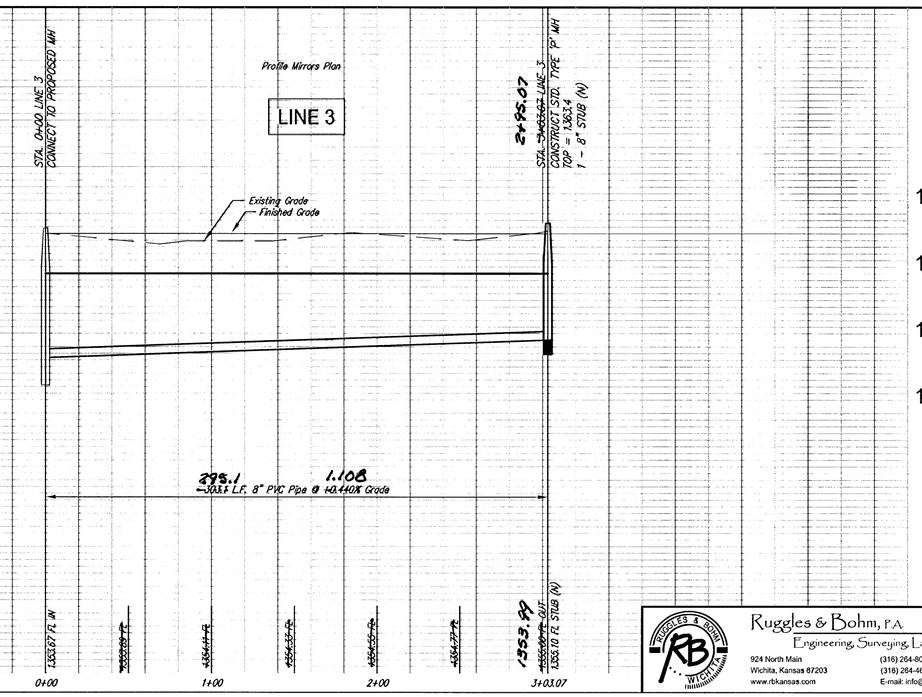

Cheryl's Hollow Addition
Line 2A and 3
WICHITA, KANSAS

REVISED	DRAWN	DESIGN	PROJECT NUMBER	DRAWING FILE
RENEW	RA	KWL	468-83937	Sanitary Sewer (Line 1)
DATE	UTILITY			
May 3, 2005				

Ruggles & Bohm, P.A.
Engineering, Surveying, Land Planning
924 North Main
Wichita, Kansas 87203
www.rbkansas.com
(316) 264-8008
(316) 264-4821 fax
E-mail: info@rbkansas.com

RB JOB 2666E
SHEET 6 OF 11