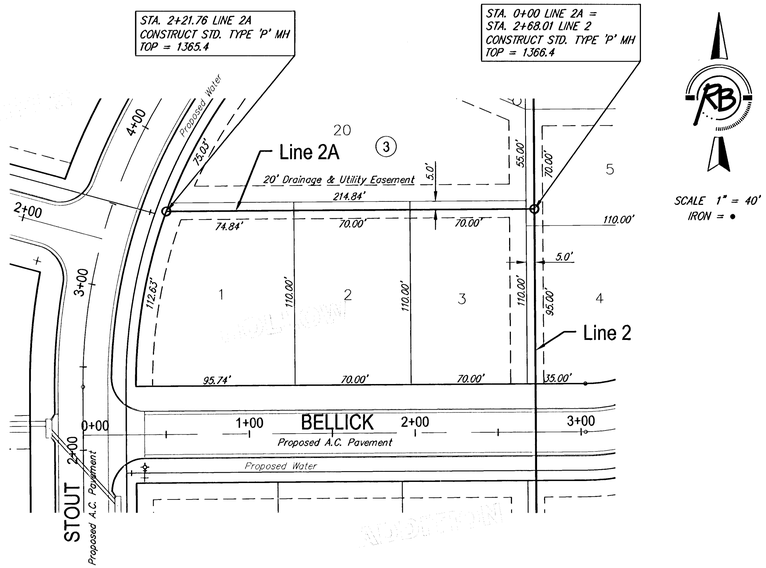

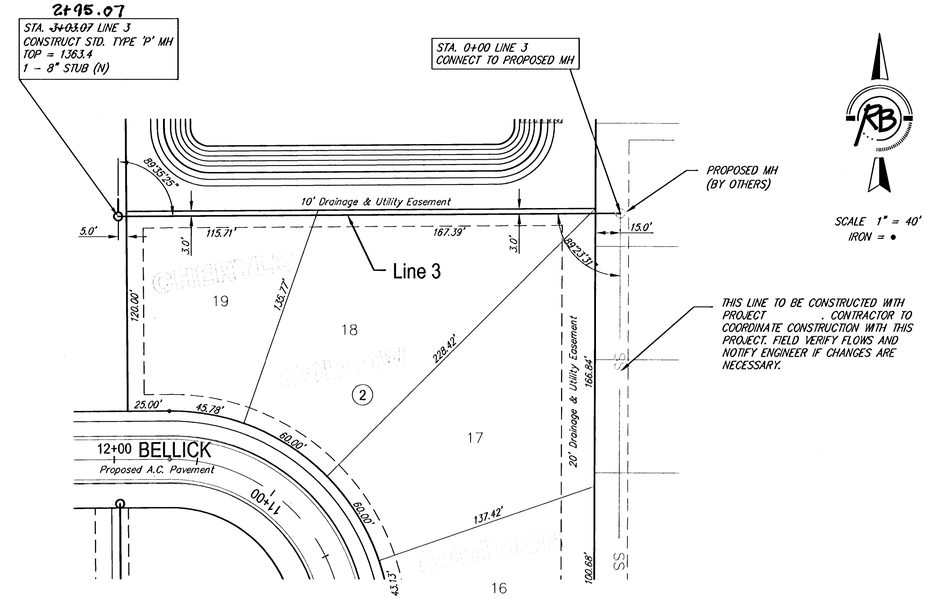

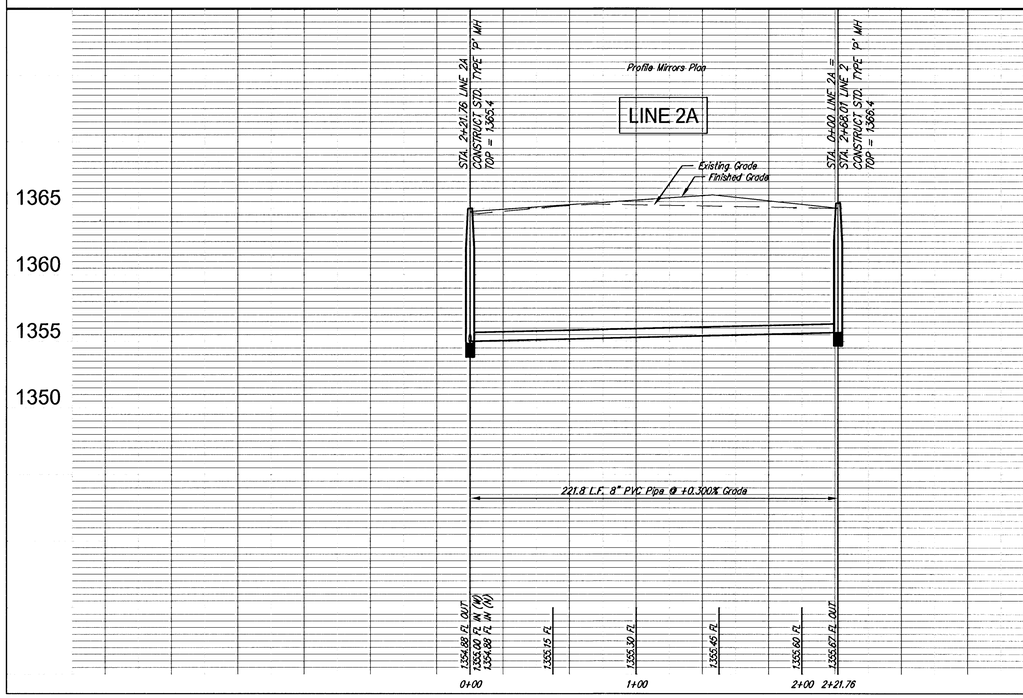

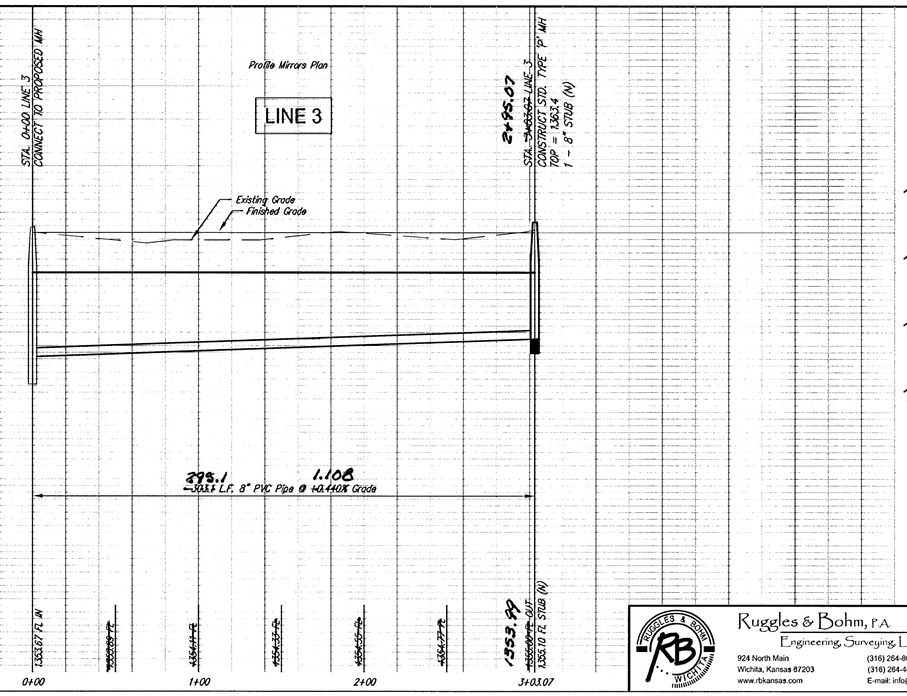

REVISED	-
DRAWN	RA
REVIEW	-
DESIGN	KWL
DATE	May 3, 2005
UTILITY	
PROJECT NUMBER	468-83937
DRAWING FILE	Sanitary Sewer (Line 1)

Cheryl's Hollow Addition
Line 2A and 3
WICHITA, KANSAS

Ruggles & Bohm, P.A.
Engineering, Surveying, Land Planning
924 North Main
Wichita, Kansas 67203
www.rbkansas.com
(316) 264-8008
(316) 264-4621 fax
E-mail: info@rbkansas.com

RB JOB 2666E