
BENCHMARKS:


BM #1: C.O.W. disc at SW corner of intersection.
30.00'± S. of CL of 13th St. N.
35.00'± W. of CL of 135th St. W.
Elev. = 168.25 City Datum

BM #2: Small RR spike in 4th HLP W. of 135th St. W. on south side of 13th St. N. (N. face of HLP).
Elev. = 179.24 City Datum

BM #3: RR spike in Power Pole.
1321.65 W. of 135th St. W.
30' N. of 13th St. N.
Elev. = 178.45 City Datum

Scale: 1" = 40' Horizontal
1" = 5' Vertical
• = Iron

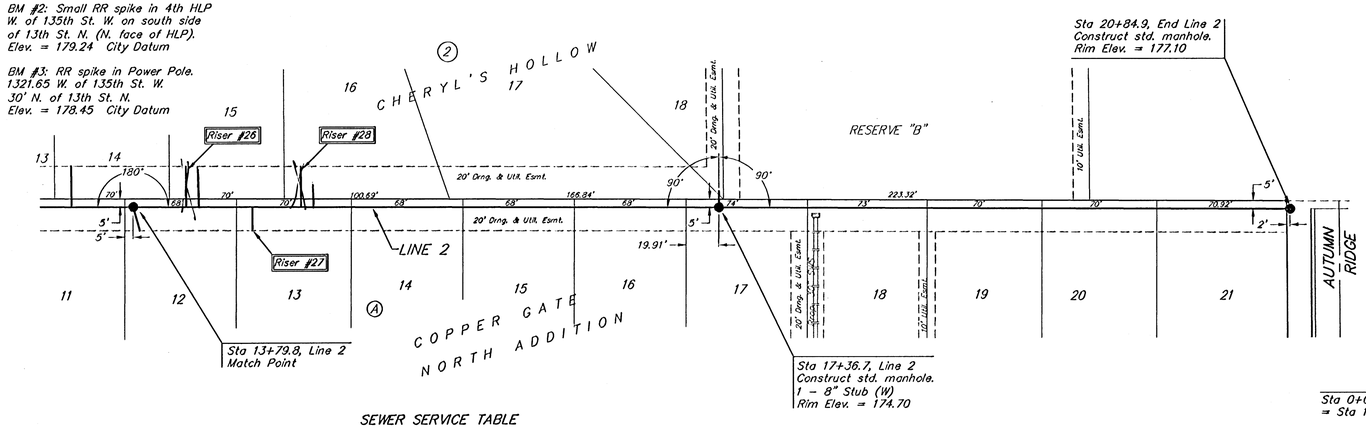


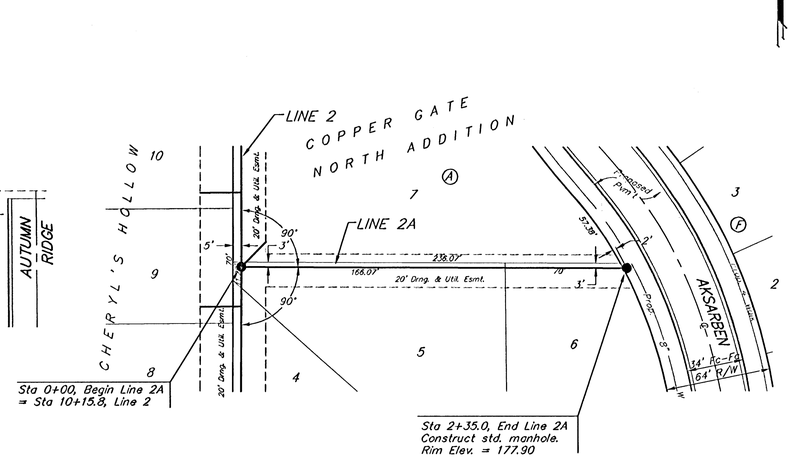

SEWER SERVICE TABLE

NUMBER	TYPE	LOCATION			STATION/ DIRECTION	FOR INFORMATION ONLY	
		LOT NO.	BLOCK NO.	LINE NO.		APPROXIMATE LENGTH 4" PIPE VERTICAL	HORIZONTAL
26	8" X 4" Tee	15	2	2	14+12/Lt. 18	8.5'	~~25'~~ 28'
27	8" X 4" Tee	13	A	2	14+52/Rt. 55	8'	~~-15'~~ 14'
28	8" X 4" Tee	16	2	2	14+82/Lt. 89	8'	~~-26'~~ 15.5'

NOTE: Vertical Riser Pipe shall be extended to 2' minimum above ground water elevation and 4' maximum below proposed ground elevation.

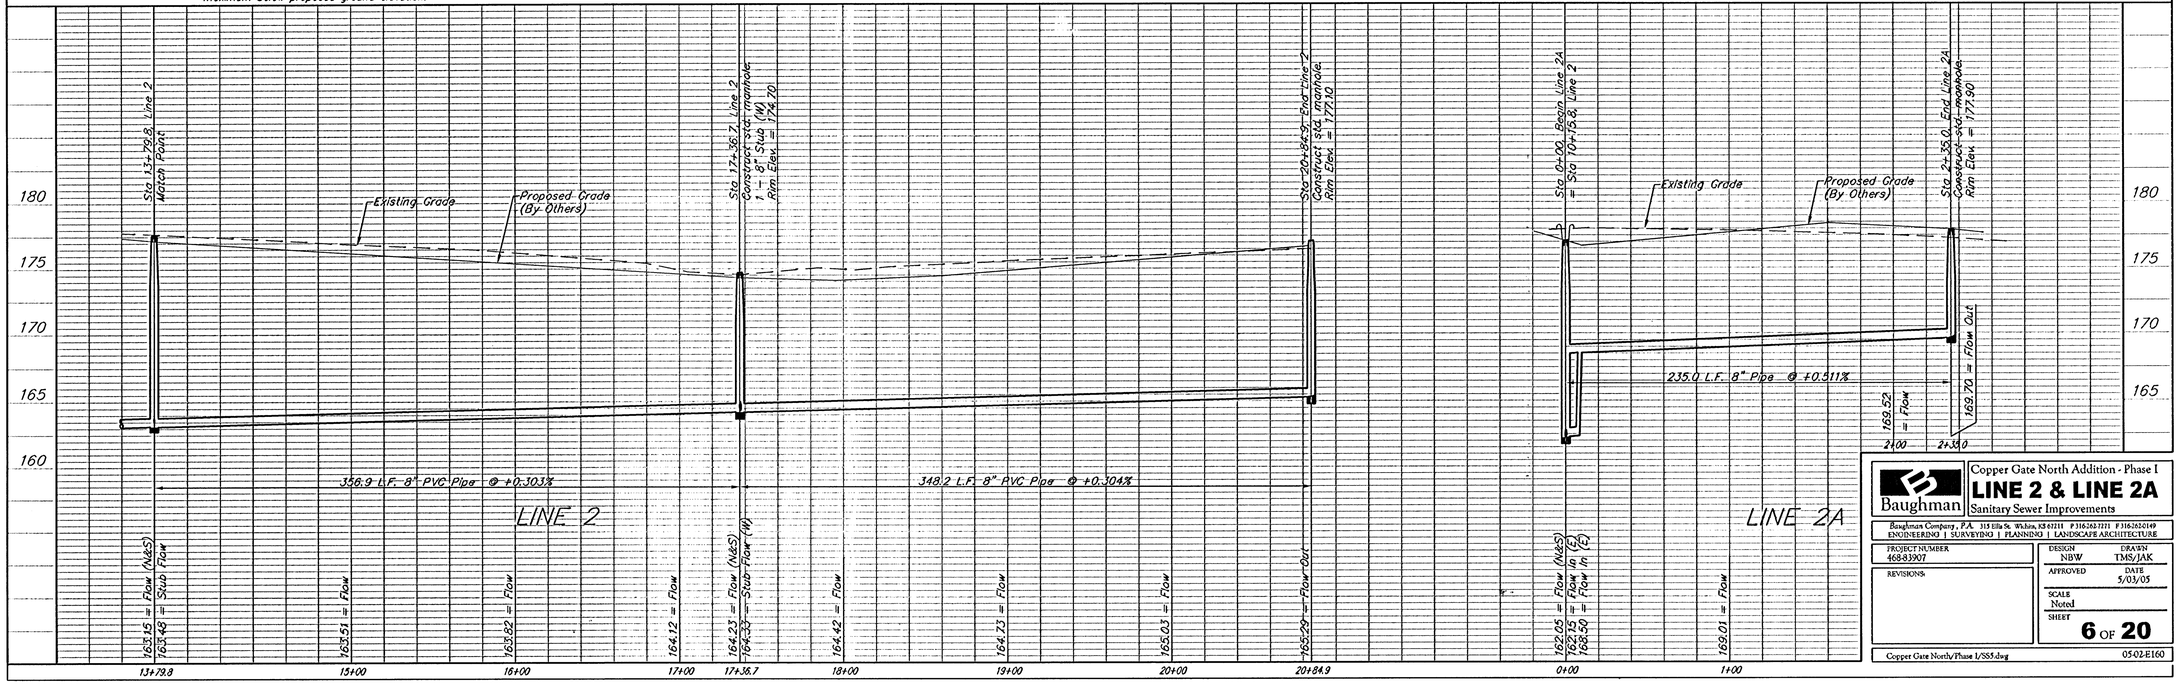

Baughman

Copper Gate North Addition - Phase I

LINE 2 & LINE 2A

Sanitary Sewer Improvements

Baughman Company, P.A. 315 Ella St. Wichita, KS 67211 P 316.262.7271 F 316.263.0149
ENGINEERING | SURVEYING | PLANNING | LANDSCAPE ARCHITECTURE

PROJECT NUMBER 468.83907
DESIGN NBW
DRAWN TMS/JAK
APPROVED
DATE 5/03/05
REVISIONS
SCALE Noted
SHEET **6** OF **20**

Copper Gate North/Phase I/SS5.dwg
05-02-E160