
BENCHMARKS:

BM #1: C.O.W. disc at SW corner of intersection.
30.00'± S. of CL of 13th St. N.
35.00'± W. of CL of 135th St. W.
Elev. = 168.25 City Datum

BM #2: Small RR spike in 4th HLP W. of 135th St. W. on south side of 13th St. N. (N. face of HLP).
Elev. = 179.24 City Datum

BM #3: RR spike in Power Pole.
1321.65 W. of 135th St. W.
30' N. of 13th St. N.
Elev. = 178.45 City Datum


Scale: 1" = 40' Horizontal
1" = 5' Vertical
• = Iron

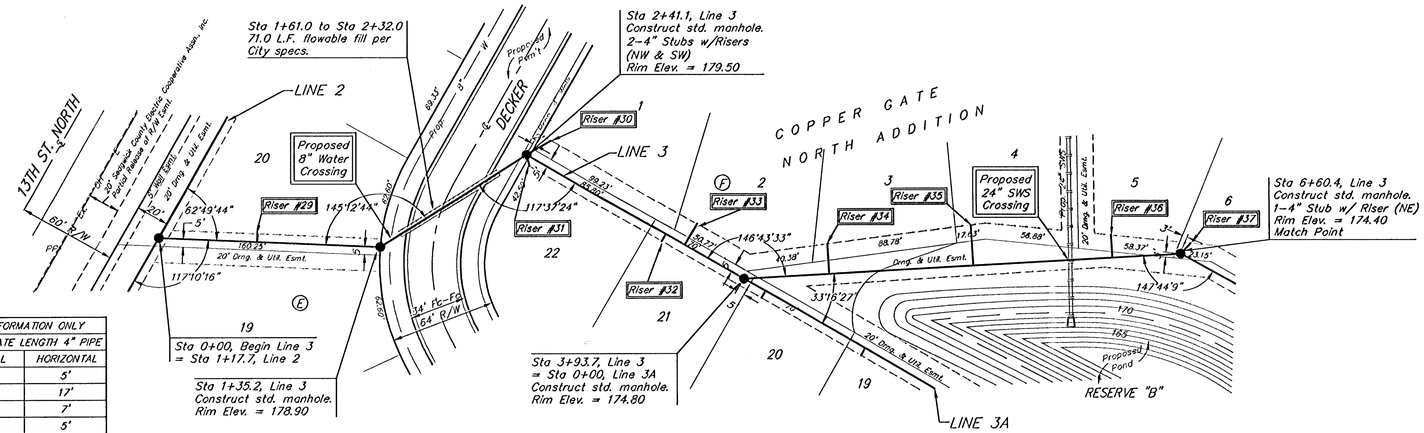

SEWER SERVICE TABLE

NUMBER	TYPE	LOCATION			STATION/ DIRECTION	FOR INFORMATION ONLY APPROXIMATE LENGTH 4" PIPE	
		LOT NO.	BLOCK NO.	LINE NO.		VERTICAL	HORIZONTAL
29	8" X 4" Tee	20	E	3	0+60/Lt.	13'	5'
30	4" Stub	1	F	3	2+41/Lt.	14.5'	17'
31	4" Stub	22	F	3	2+41/Rt.	14.5'	7'
32	8" X 4" Tee	21	F	3	3+40/Rt.	9.5'	5'
33	8" X 4" Tee	2	F	3	3+53/Lt.	9.5'	15'
34	8" X 4" Tee	3	F	3	4+48/Lt.	8.5'	18' 17'
35	8" X 4" Tee	4	F	3	5+34/Lt.	8.0'	25'
36	8" X 4" Tee	5	F	3	6+19/Lt.	7.5'	13' 12'
37	4" Stub	6	F	3	6+60.4/Lt.	7'	8' 10'

NOTE: Vertical Riser Pipe shall be extended to 2' minimum above ground water elevation and 4' maximum below proposed ground elevation.

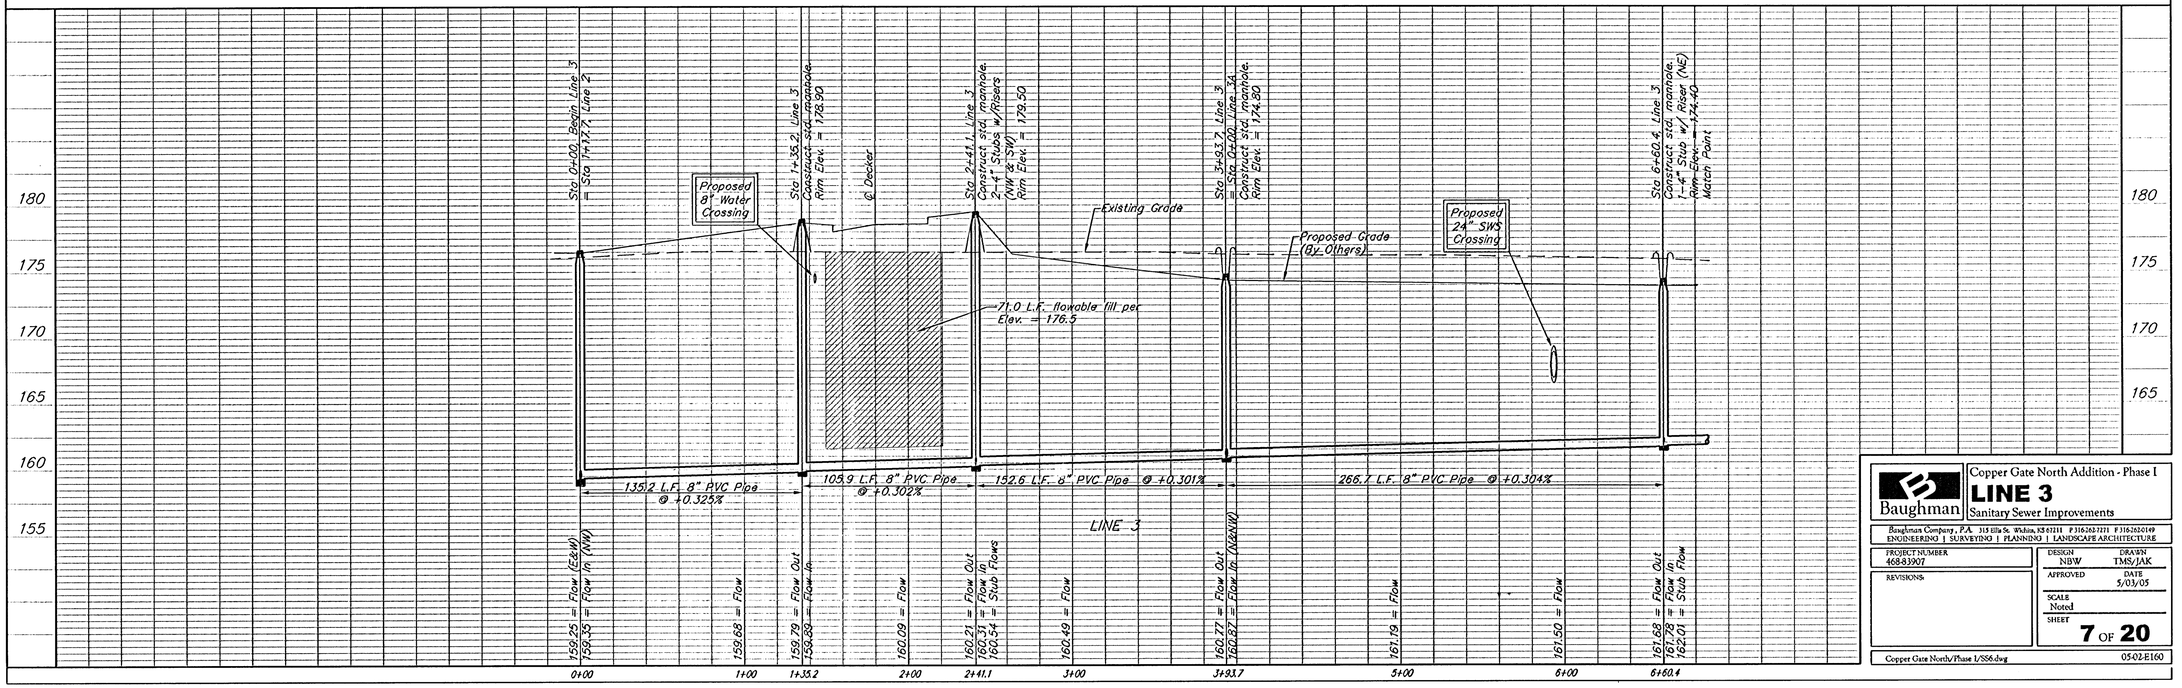

Baughman

Copper Gate North Addition - Phase I

LINE 3

Sanitary Sewer Improvements

Baughman Company, P.A. 315 Ellis St. Wichita, KS 67211 P 316.262.2221 F 316.262.0149
ENGINEERING | SURVEYING | PLANNING | LANDSCAPE ARCHITECTURE

PROJECT NUMBER 468-83907	DESIGN NBW / DRAWN TMS/JAK
REVISIONS	APPROVED / DATE 5/03/05
	SCALE Noted
	SHEET 7 OF 20

Copper Gate North/Phase I/SS6.dwg 05-02-E160