



N O T H R I D G E P L A Z A A D D I T I O N

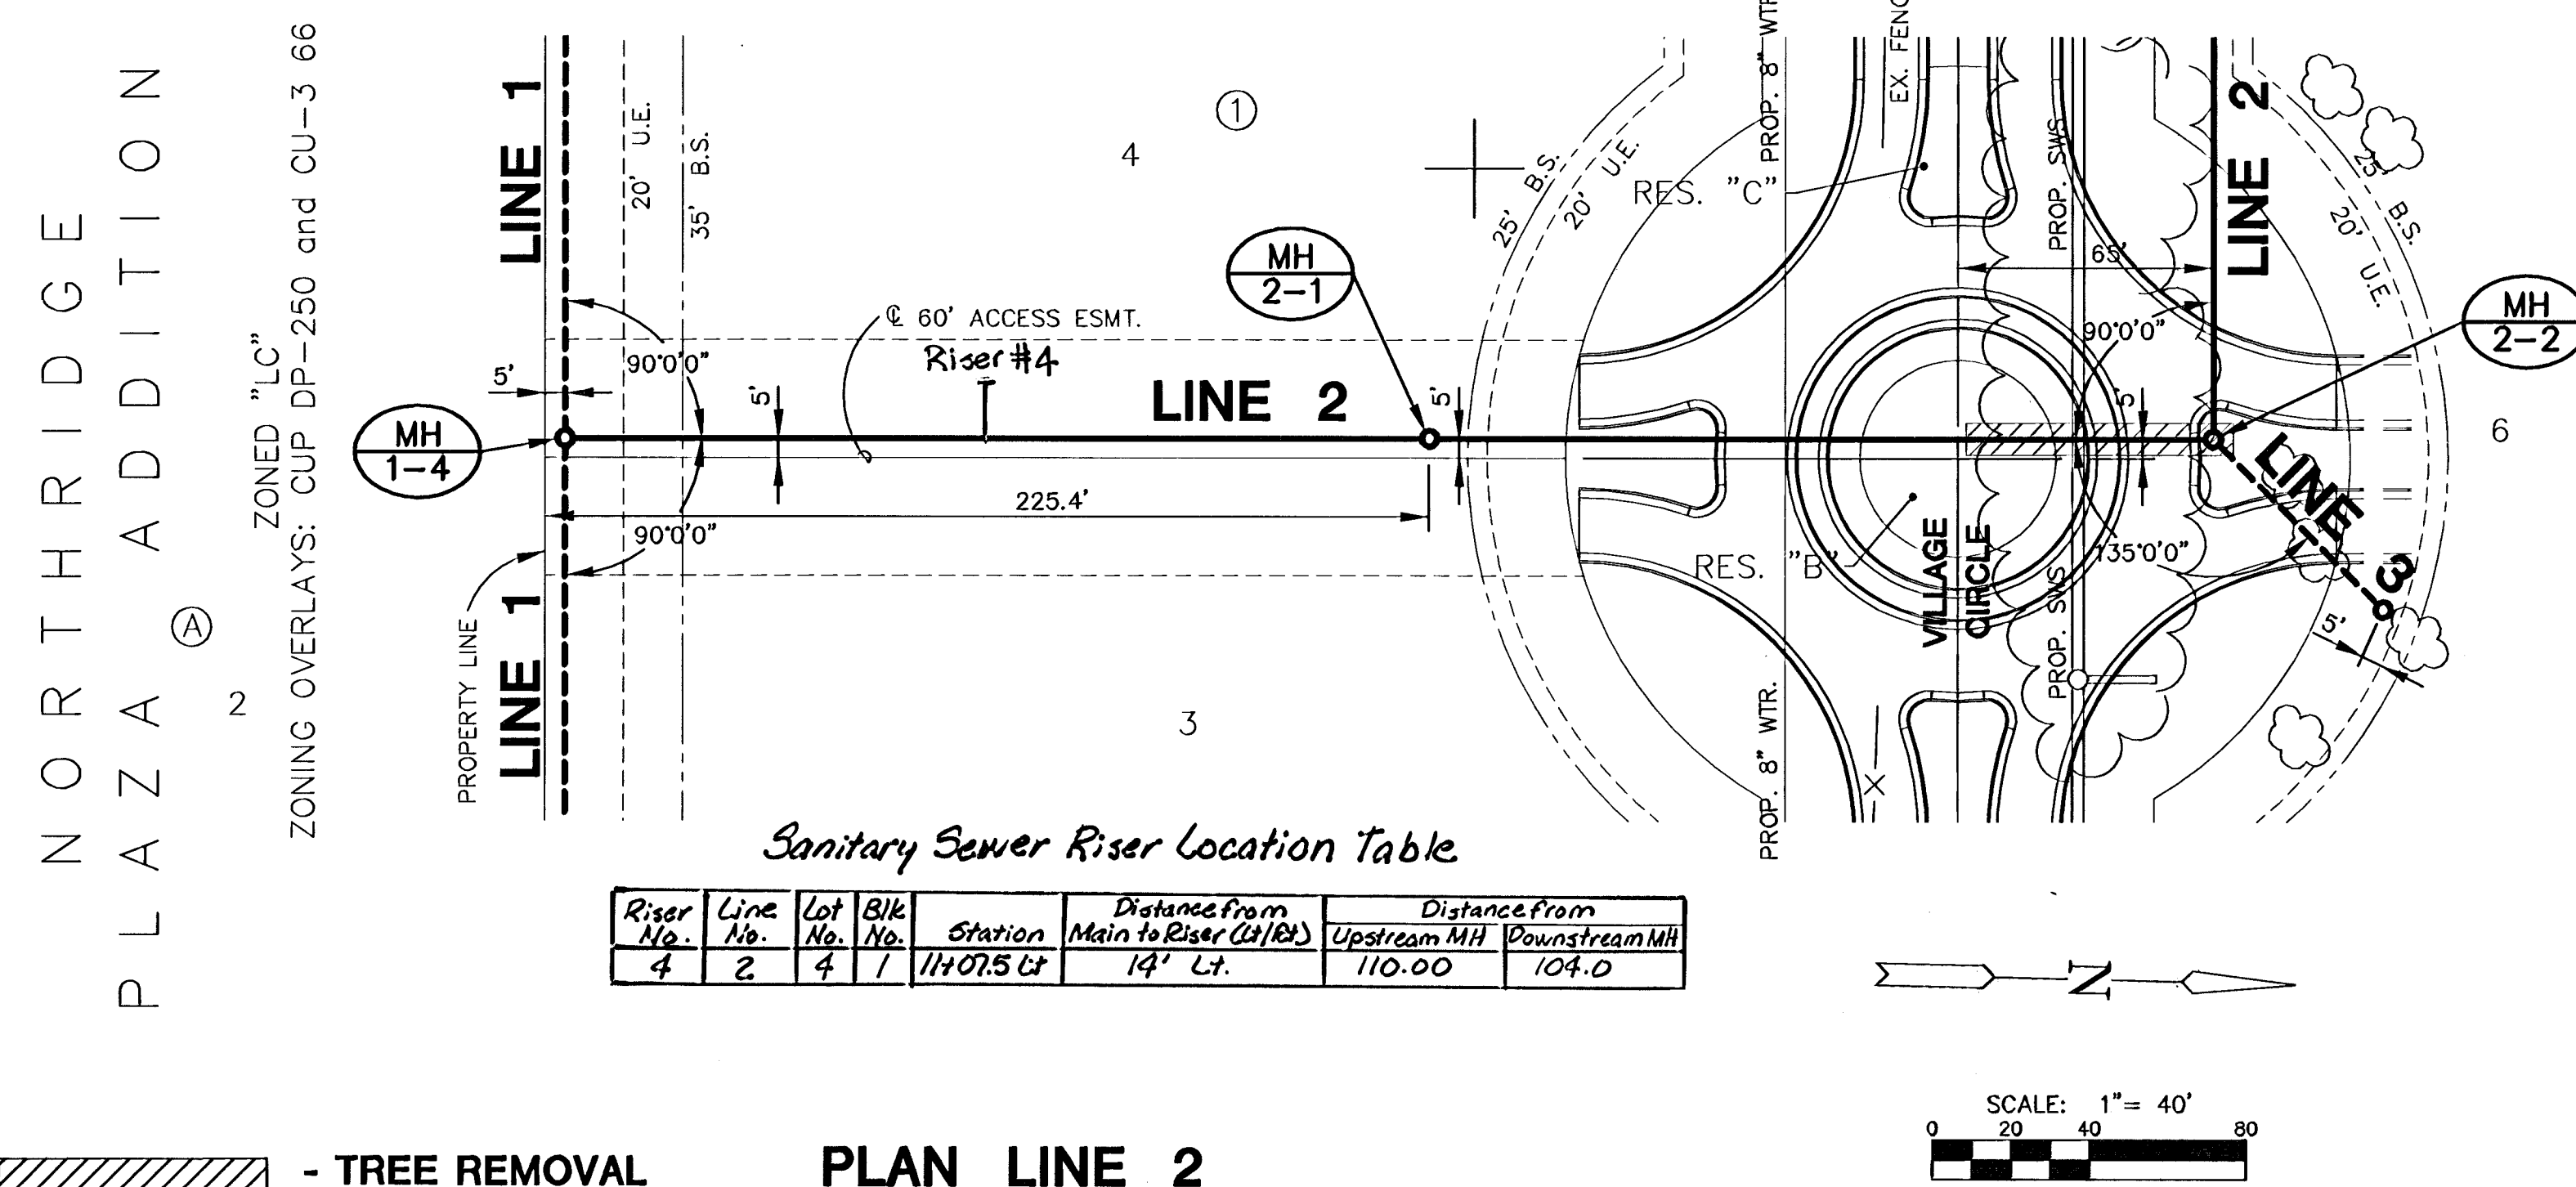

▨ - TREE REMOVAL

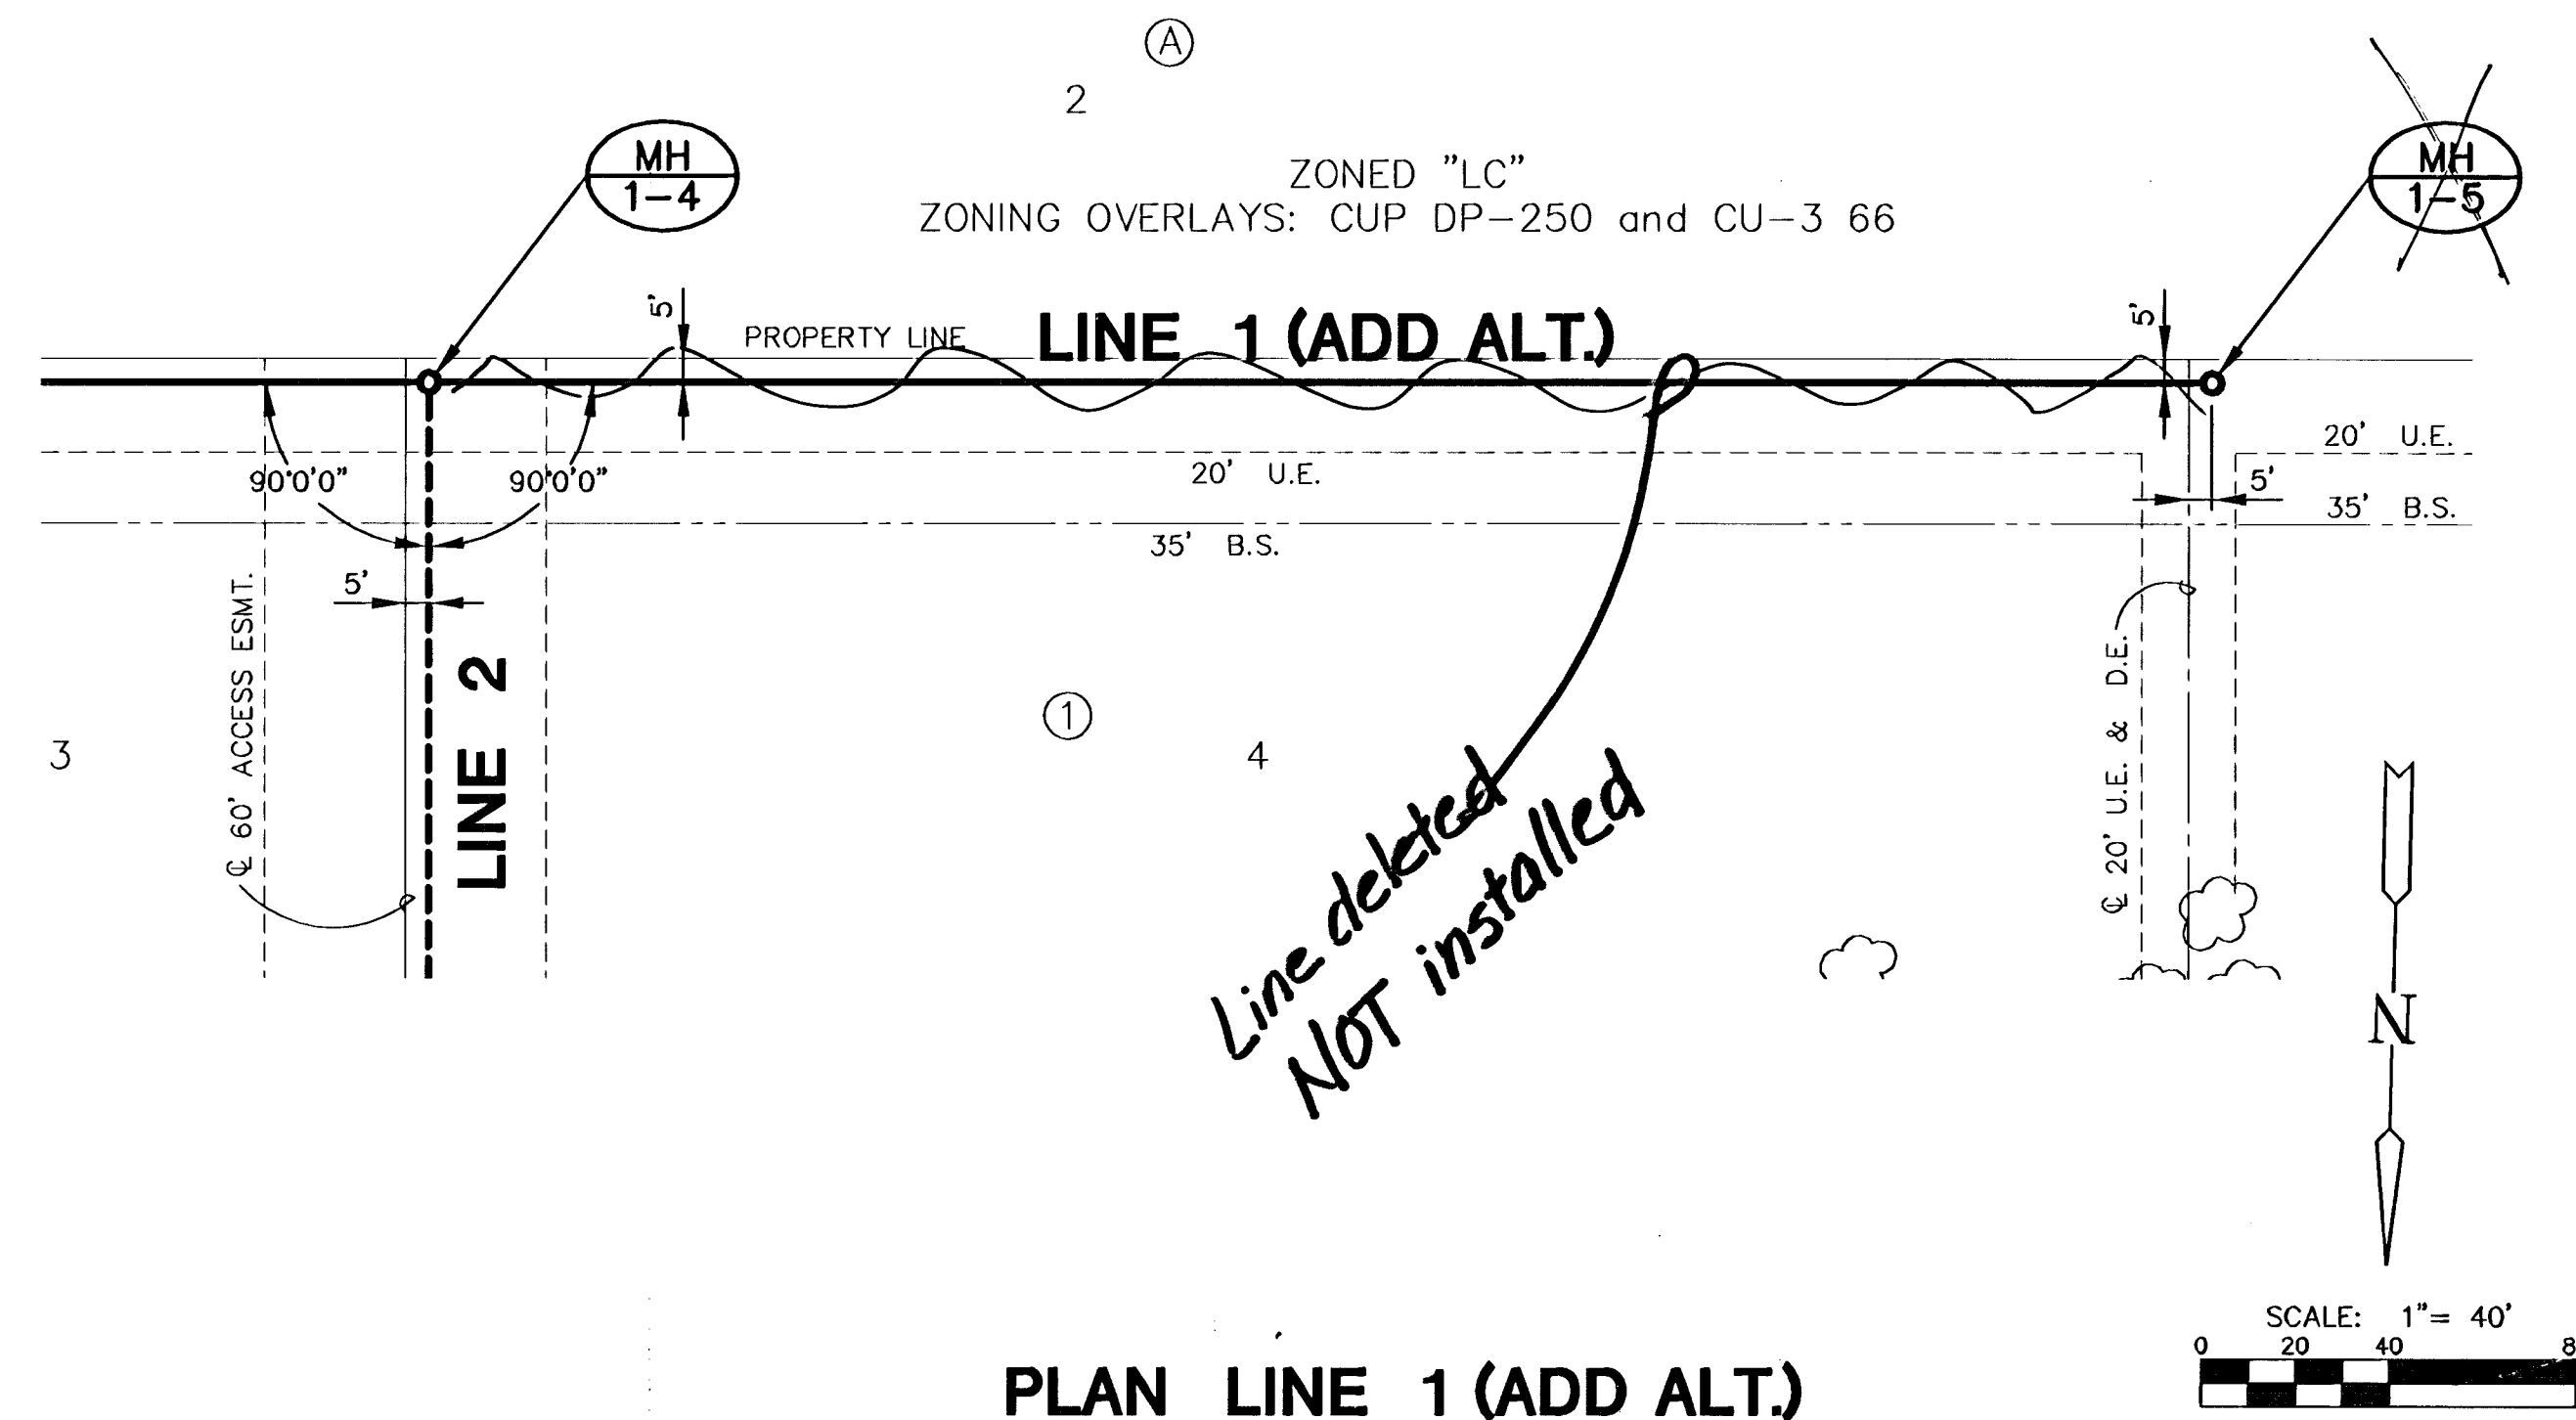