
Benchmarks:

City of Wichita Benchmark located 41.60' North and 69.00' East of the Centerlines of Hoover and MacArthur (39th St. South)

Elevation = 121.22 (City Datum)

City of Wichita Bencmark located at East end of Bridge over the Big Ditch on MacArthur in the West bound lane.

Elevation = 116.52 (City Datum)

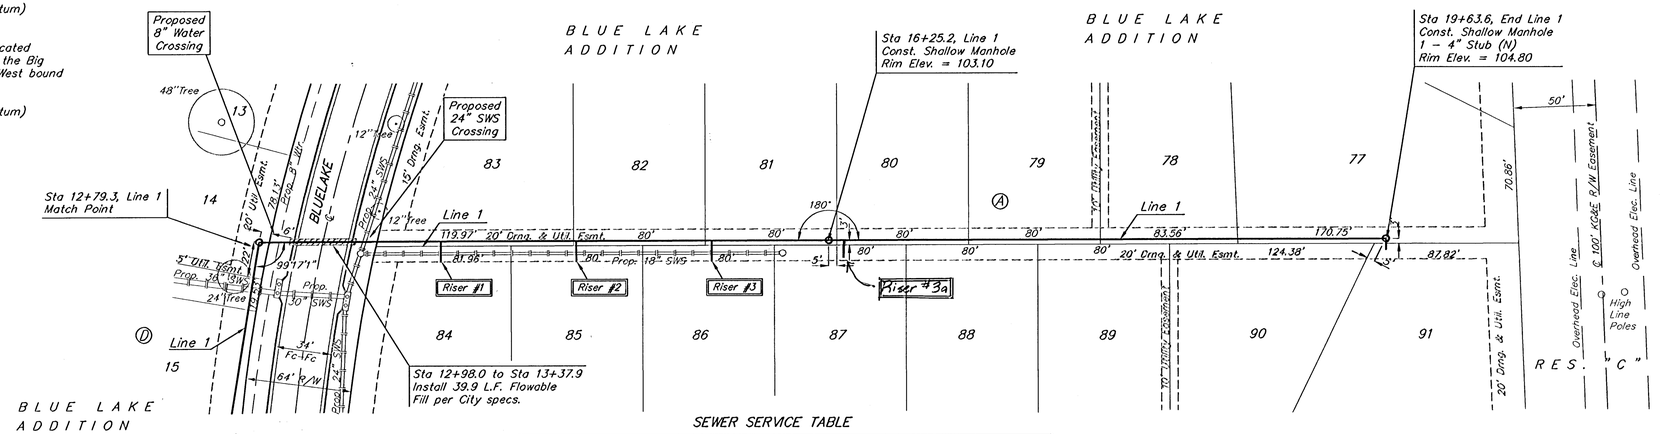


Scale: 1" = 40' Horizontal
1" = 5' Vertical
• = Iron

SEWER SERVICE TABLE

NUMBER	TYPE	LOCATION			STATION\ DIRECTION	FOR INFORMATION ONLY	
		LOT NO.	BLOCK NO.	LINE NO.		APPROXIMATE LENGTH 4" PIPE VERTICAL	HORIZONTAL
1	8" x 4" Tee Saddle	84	A	1	13+86/Rt. 83	2.5'	13' 12'
2	8" x 4" Tee Saddle	85	A	1	14+68/Rt. 85	2'	13' 12'
3	8" x 4" Tee Saddle	86	A	1	15+60/Rt. 44	2.5'	13' 12'
3a	8" x 4" Tee Saddle	87	A	1	16+33/Rt		12'.

Note: Vertical Riser Pipe shall be extended to 2' minimum above ground water elevation and 4' maximum below proposed ground elevation.

Note: Contractor shall Remove Trees only as Necessary to Construct Sanitary Sewer Line. Cost of Tree Removal shall be Included in Bid Item "Site Clearing and Restoration."

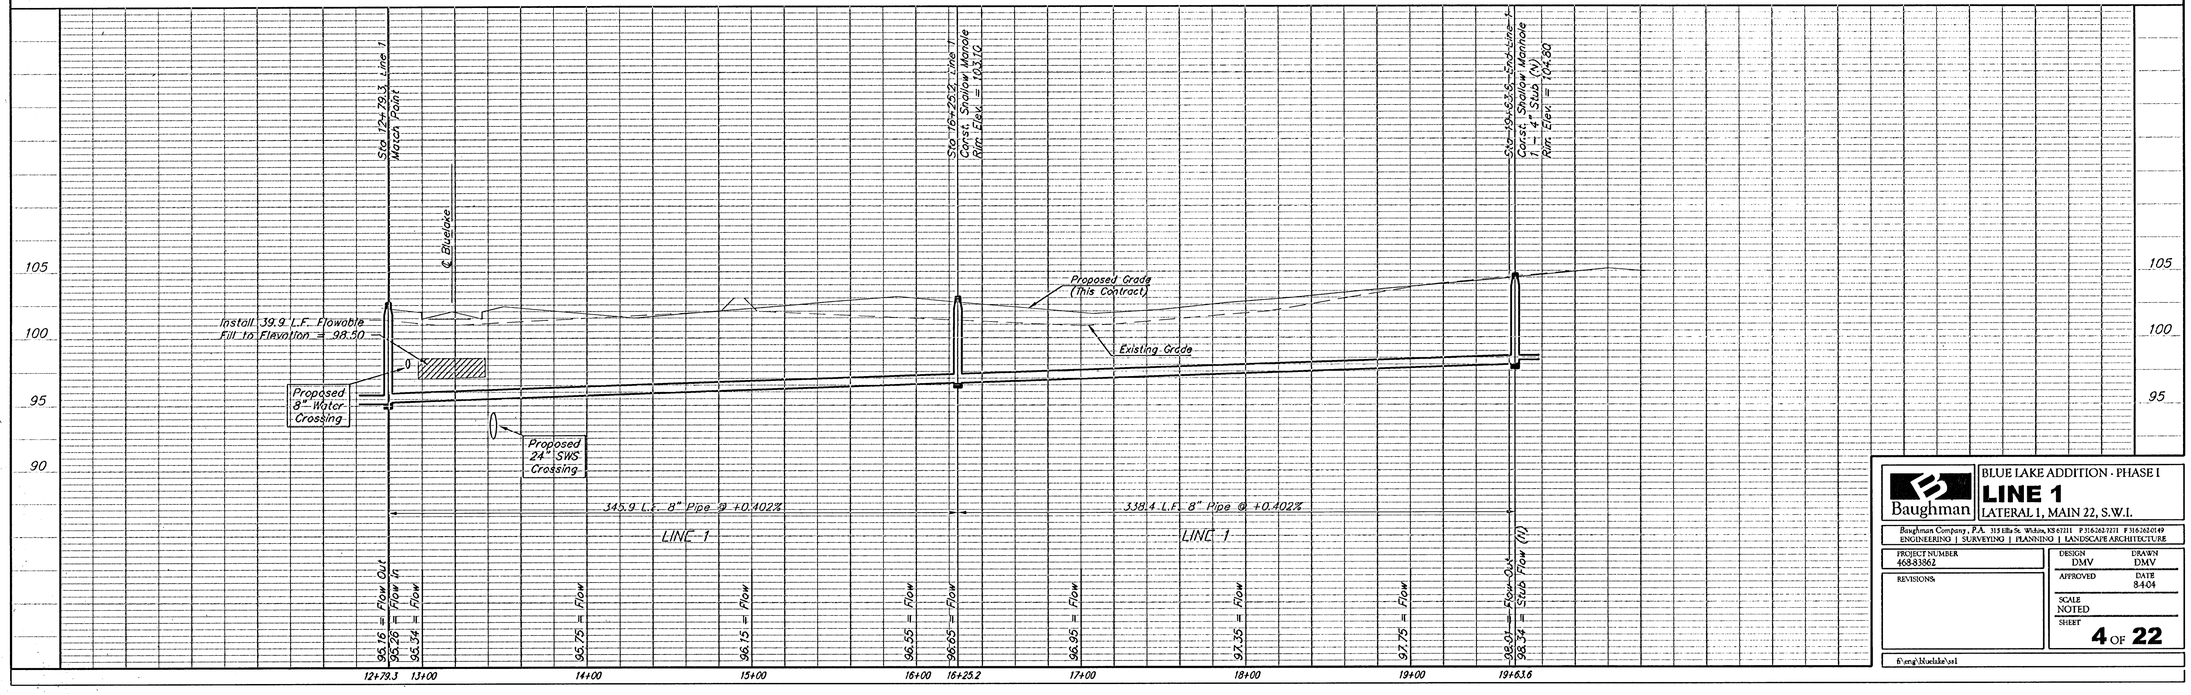

Baughman

BLUE LAKE ADDITION - PHASE I

LINE 1

LATERAL 1, MAIN 22, S.W.I.

Baughman Company, P.A. 315 E. Elk St. Wichita, KS 67211 P 316.263.7271 F 316.263.0149
ENGINEERING | SURVEYING | PLANNING | LANDSCAPE ARCHITECTURE

PROJECT NUMBER 468-83862

DESIGN DMV | DRAWN DMV

APPROVED | DATE 8-4-04

REVISIONS

SCALE NOTED

SHEET 4 OF 22

f:\eng\bluelake\ln1