


City Disc In T.C. Adj. to F.H.
27' North of Monterey. At the
Intersection of Monterey and
Auburn Hills.
Elev. = 179.40 (City Datum)

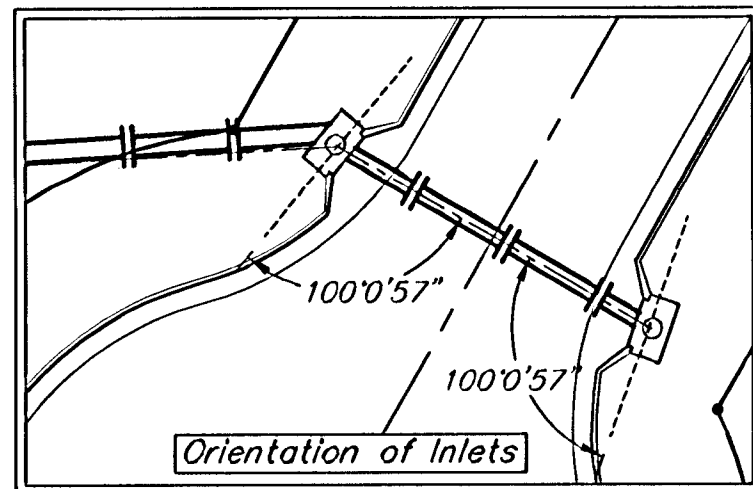

Sta. 2+12.3 to Sta. 2+49.6
Install 37.3 L.F. Flowable Fill
per City Specs.

CAUTION:
Ex. 8" SS
Crossing

Remove trees only as necessary for storm sewer construction and only with permission of Developer or Baughman Co. Cost of removal to be incidental to lump sum bid item "Site Clearing & Restoration".

Sta. 2+49.6, End Line 1
Construct std. type 1A
single curb inlet (5'x3').
Top Elev. = 182.45

Sta. 0+00, Line 2
Begin at blockout
and extend SWS S

<i>Pond Data:</i>
Static WS = 159.0
100-yr WS = 164.0
Pond Bottom = 152.0

Sta. 0+13.9, Line 2
Const. Std. Double Curb
Inlet (10'x4').
Top Elev. = 171.88

Sta. 0+13.9 to Sta. 0+55.7
Install 41.8 L.F. Flowable Fill
per City Specs.

Sta. 0+55.7, End Line 2
Const. Std. Double Curb
Inlet (10'x3').
Top Elev. = 171.88


Scale: 1" = 20' Horizontal
1" = 5' Vertical
• = Iron

Pond Data:
Static WS = 163.0
100-yr WS = 167.4

Existing Pond

RES. "B"

AUBURN HILLS
15TH ADDITION

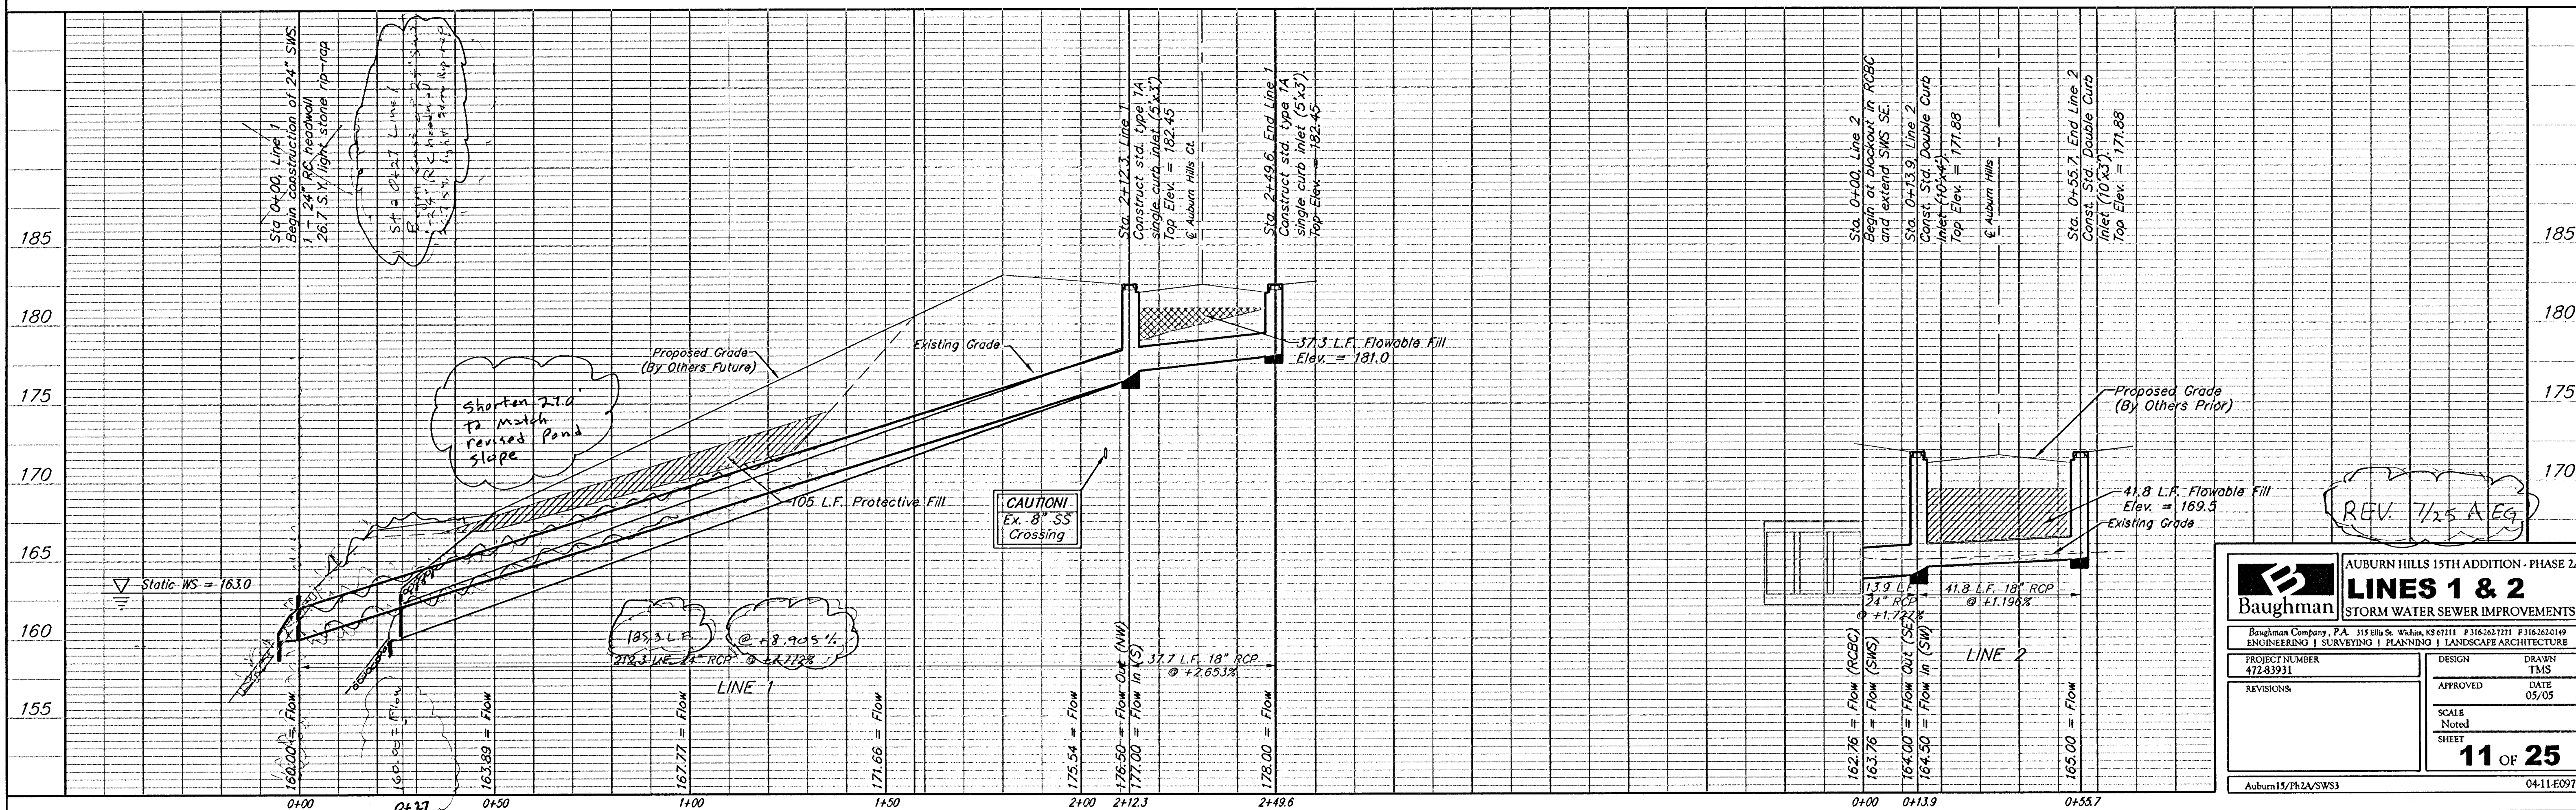

 Baughman ENGINEERING	AUBURN HILLS 15TH ADDITION - PHASE 2A LINES 1 & 2 STORM WATER SEWER IMPROVEMENTS																	
PROJECT NUMBER 472-83931 REVISIONS:	<table border="1" style="width: 100%; border-collapse: collapse;"> <tr> <td style="width: 50%;">DESIGN</td> <td style="width: 50%;">DRAWN</td> </tr> <tr> <td></td> <td>TMS</td> </tr> <tr> <td style="text-align: center;">APPROVED</td> <td style="text-align: center;">DATE</td> </tr> <tr> <td></td> <td style="text-align: center;">05/05</td> </tr> <tr> <td colspan="2" style="text-align: center;">SCALE</td> </tr> <tr> <td colspan="2" style="text-align: center;">Noted</td> </tr> <tr> <td colspan="2" style="text-align: center;">SHEET</td> </tr> <tr> <td colspan="2" style="text-align: center;"> 11 OF 25 </td> </tr> </table>	DESIGN	DRAWN		TMS	APPROVED	DATE		05/05	SCALE		Noted		SHEET		11 OF 25		Auburn15/Ph2A/SW53 04-11-E097
DESIGN	DRAWN																	
	TMS																	
APPROVED	DATE																	
	05/05																	
SCALE																		
Noted																		
SHEET																		
11 OF 25																		