


PLAN	CHECKED	DATE

PROFILE	CHECKED	DATE

DSNR: MDK OPER. SCALE: 1"=40.00
Q:\2004\04688\001\04688-001-C-SSPP0200 1 06-14-2005 10:59:35 am

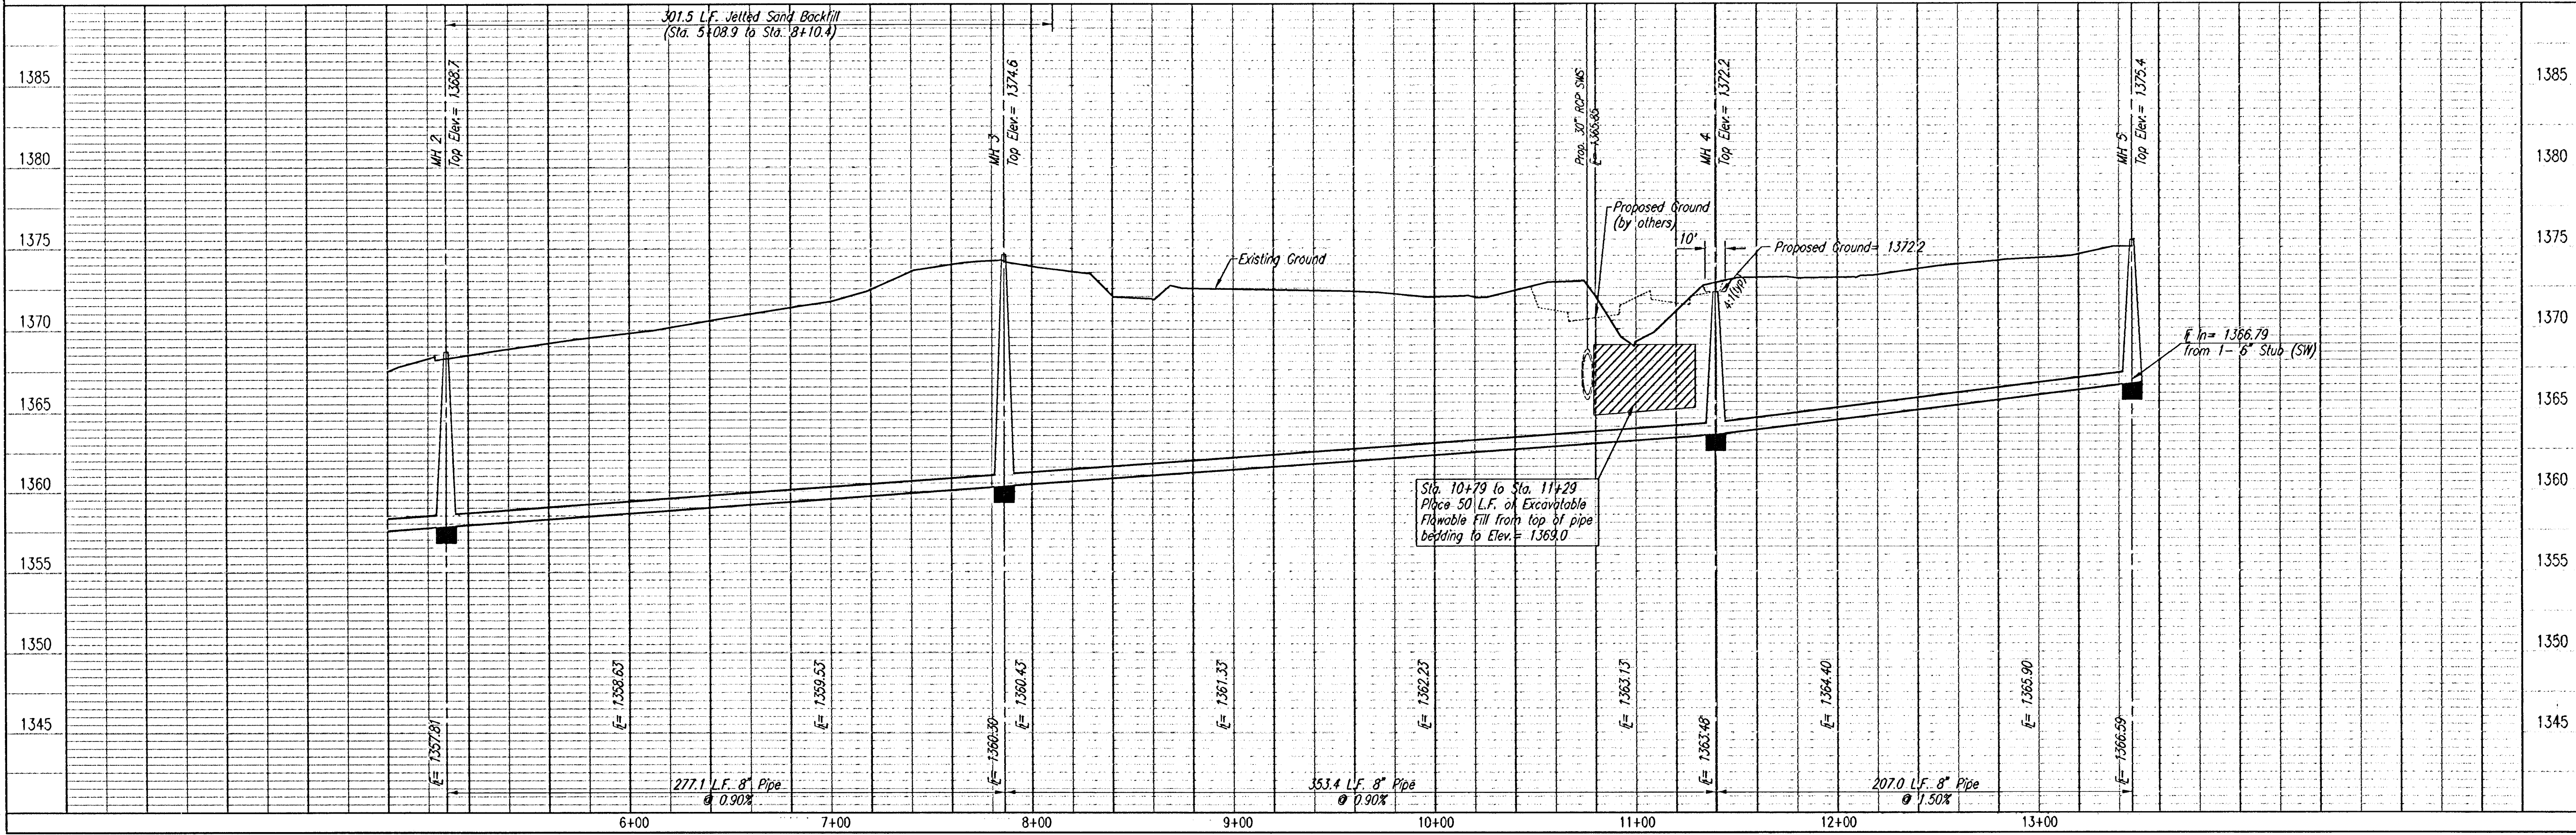

Professional Engineering Consultants, P.A. 303 S. TOPICKA • WICHITA, KANSAS 67202 316-262-2691 • FAX 316-262-3003	
Designed By: MDK	Date: January 2005
Drawn By: TLB	

Sheet 6 of 18
CHANGE ORDER #1

CAUTION !!
Approximate location of existing City of Wichita water meter, (10801 E. 21st. St. North). Existing 1" water service line to remain active. Location of water service line unknown. This water service line will also be crossed in the vicinity of MH 11 on Sanitary Sewer Line No. 3. Any damage to the water service line shall be repaired by the contractor.

N-387,188.6777, E-2,372,752.5994
Sta. 5+08.7
MH 2

N-387,183.9259, E-2,372,475.4956
Sta. 7+85.8
Const. MH 3
Standard MH

CAUTION !!!
Proposed 30" RCP Storm Sewer (by others)

N-387,177.8662, E-2,372,122.1159
Sta. 11+39.2
Const. MH 4
Standard MH

N-387,174.3171, E-2,371,915.1463
Sta. 13+46.2
Const. MH 5
Standard MH

Install 1-6" Stub and Plug.

Abandoned water service (10715 E. 21st. Street North) Water meter to be removed by City of Wichita Water Department.

Remove 19 L.F. Asphalt drive. Do not replace.

Install 353.4 L.F. 8" Pipe.

Remove Fence as required. Do not replace.

Install 207.0 L.F. 8" Pipe.

SEE SHEET NO. 3 & 4 FOR PLAT COORDINATES



SCALE:
PLAN: LAT. & LONG. 0 40 80
PROFILE: HORZ. SAME AS ABOVE
VERT. 0 5

LATERAL 1, MAIN 16
OF THE FOUR MILE CREEK SEWER
SANITARY SEWER LINE NO. 1
JAMES L. ARNOUR, P.E. - ACTING CITY ENGINEER
CITY OF WICHITA PROJECT NO. 468-8394