
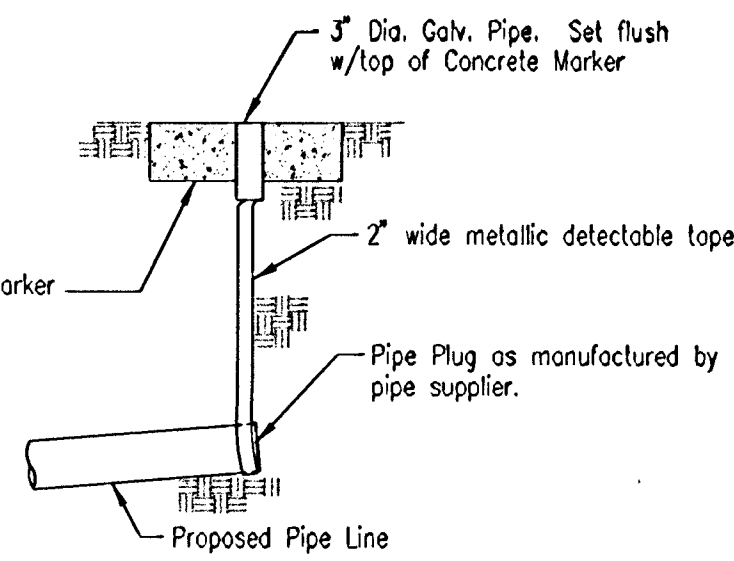


PROFILE	CHECKED	BY	DATE
	CHECKED		


DSNR: MDK OPER: CSL SCALE: 1=40.00

BURIED PIPE PLUG & MARKER DETAIL
(PLUGGING & STAKING SHALL BE SUBSIDIARY TO
THE LUMP SUM PRICE BID FOR PIPE IN PLACE)

SEE SHEET NO. 3 & 4
FOR PLAT COORDINATES

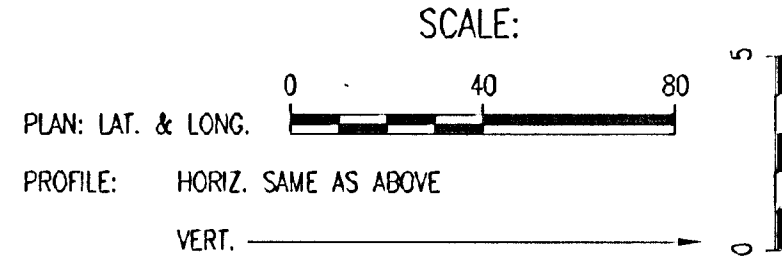

1	CHANGE ORDER #1 - SANITARY SEWER ALIGNMENT CHANGE	MDK	06/14/05
No.	Revision	By	Date

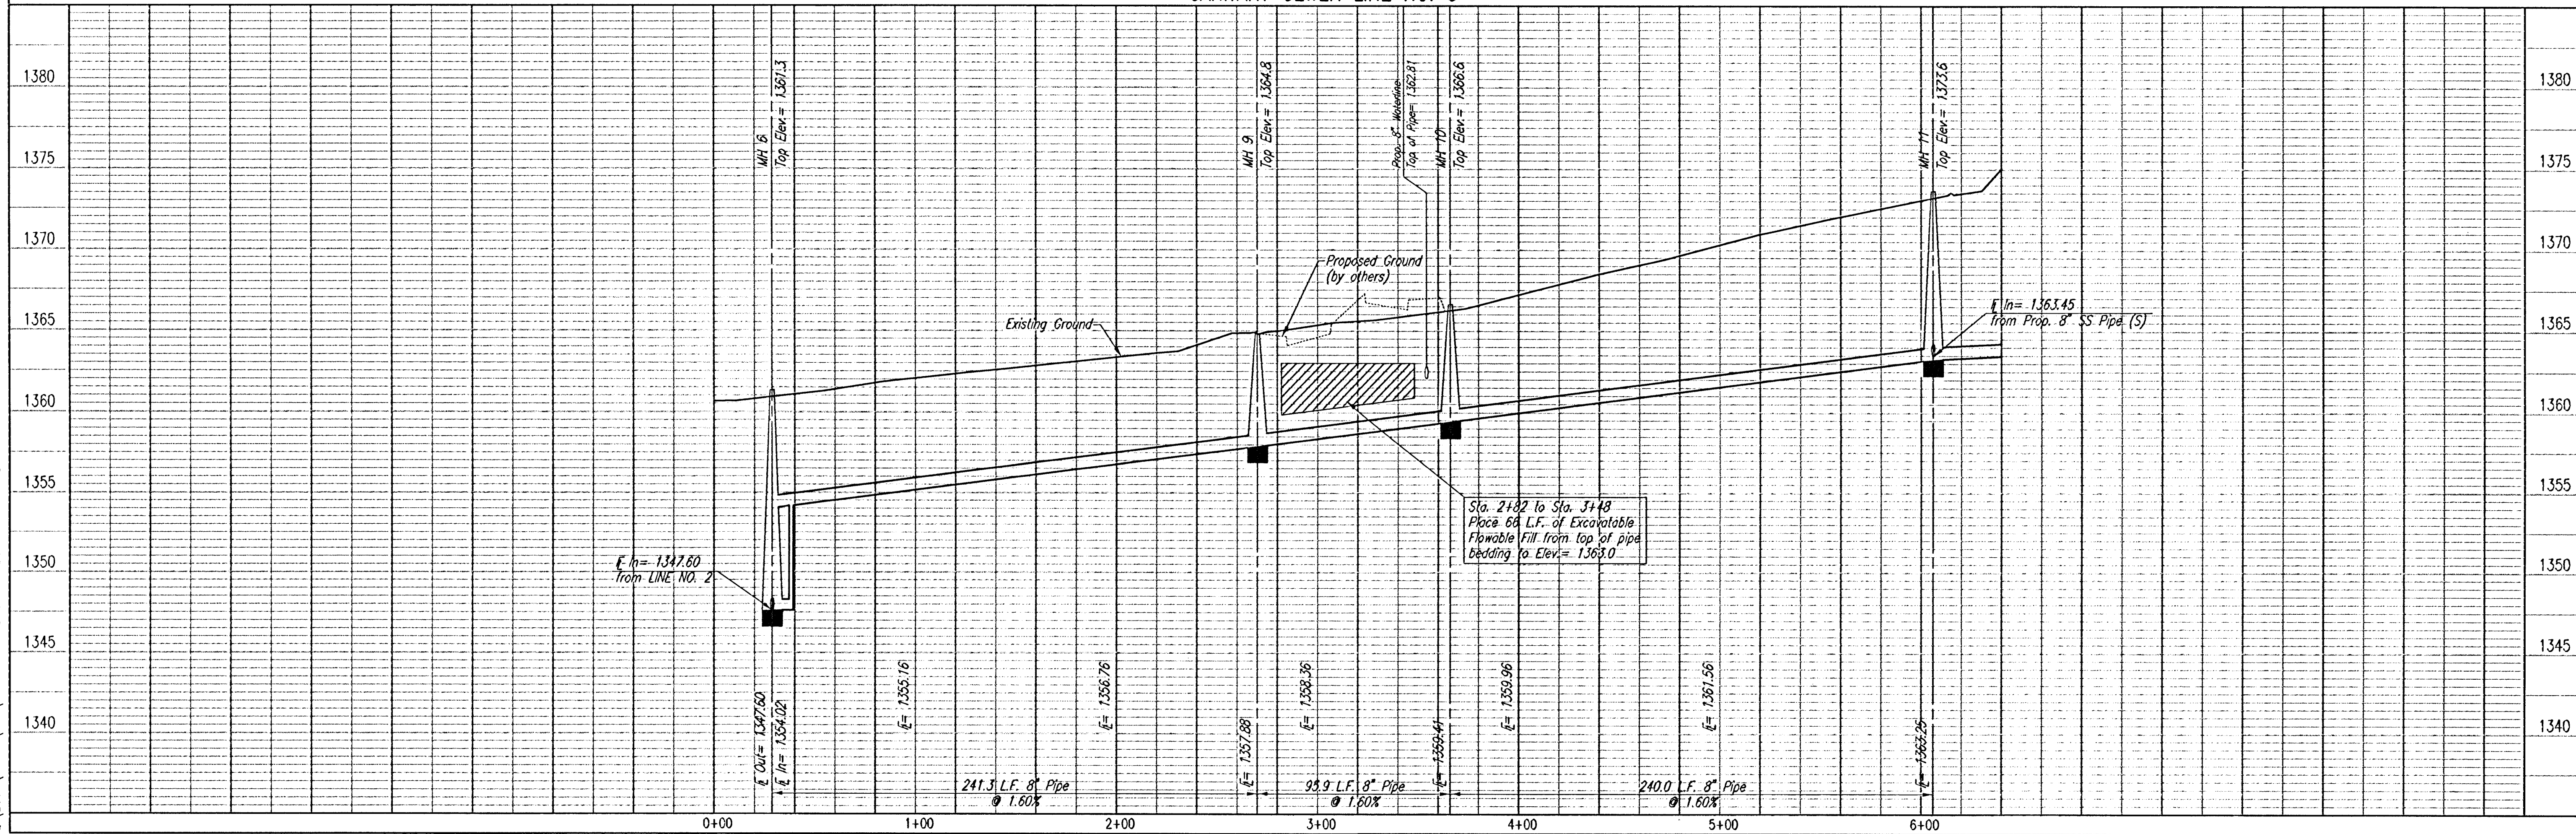

LATERAL 1, MAIN 16
OF THE FOUR MILE CREEK SEWER

SANITARY SEWER LINE NO. 3

JAMES L. ARMOUR, P.E. - ACTING CITY ENGINEER
CITY OF WICHITA PROJECT NO. 468-83984



Professional Engineering Consultants, P.A.
 303 S. TOPEKA • WICHITA, KANSAS 67202
 316-262-2691 • FAX 316-262-3003

Designed By	MDK	Job No.	35-04688-001
Drawn By	TLB	Date	January 2005

Sheet 8 of 18
CHANGE ORDER #1