


PLAN	CHECKED	DATE



PROFILE	CHECKED	DATE

DSNR: OPER. JGA SCALE: 1"=40.00
 Q:\2004\04090\000\Change Order No. 1\04090-000-C-SSPP02 05-05-2005 01:11:21 pm

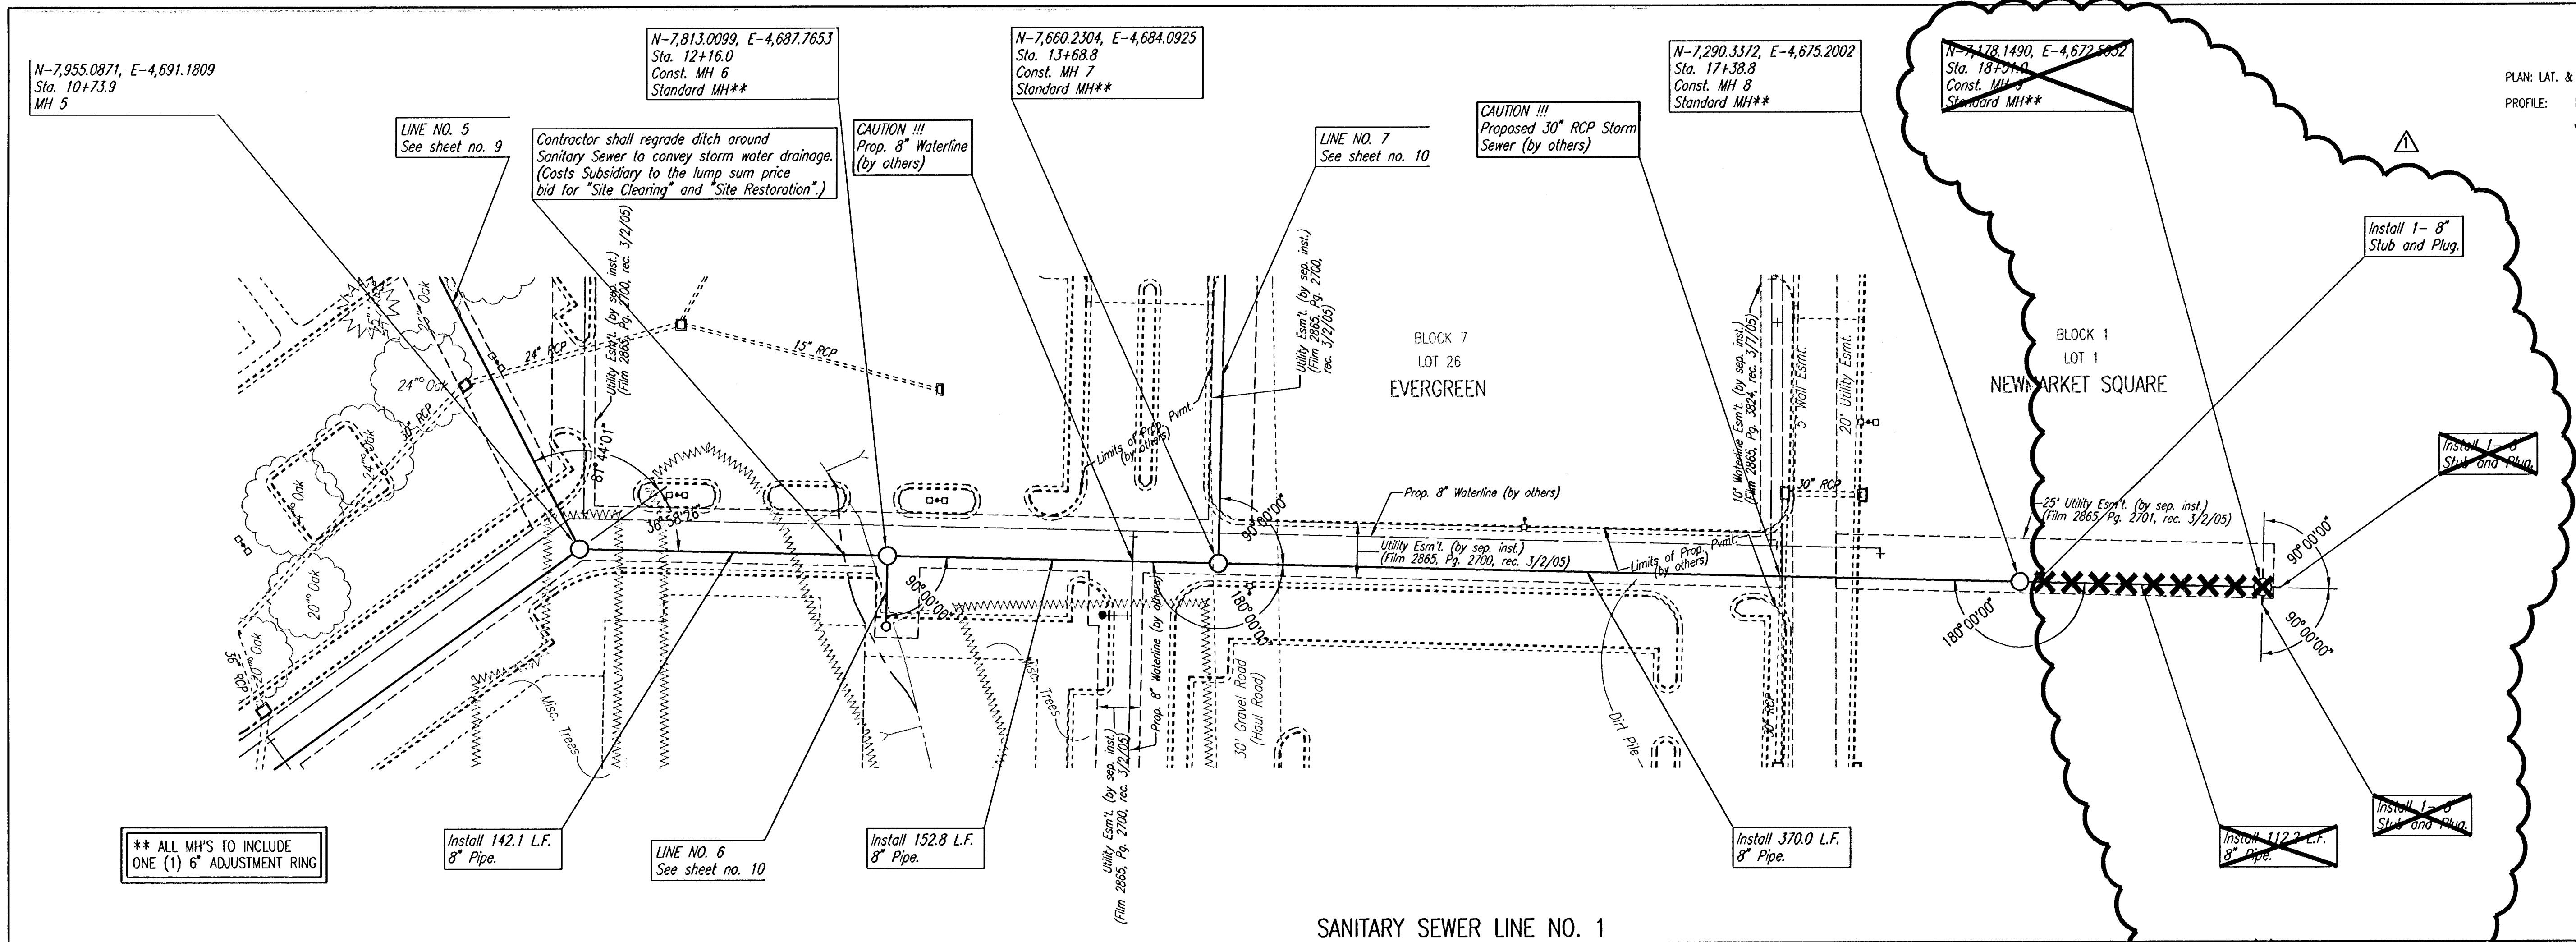

SCALE:
 PLAN: LAT. & LONG. 0 40 80
 PROFILE: HORIZ. SAME AS ABOVE
 VERT. 0 10 20

SEE SHEET NO. 3, 4, AND 5
 FOR PLAT COORDINATES

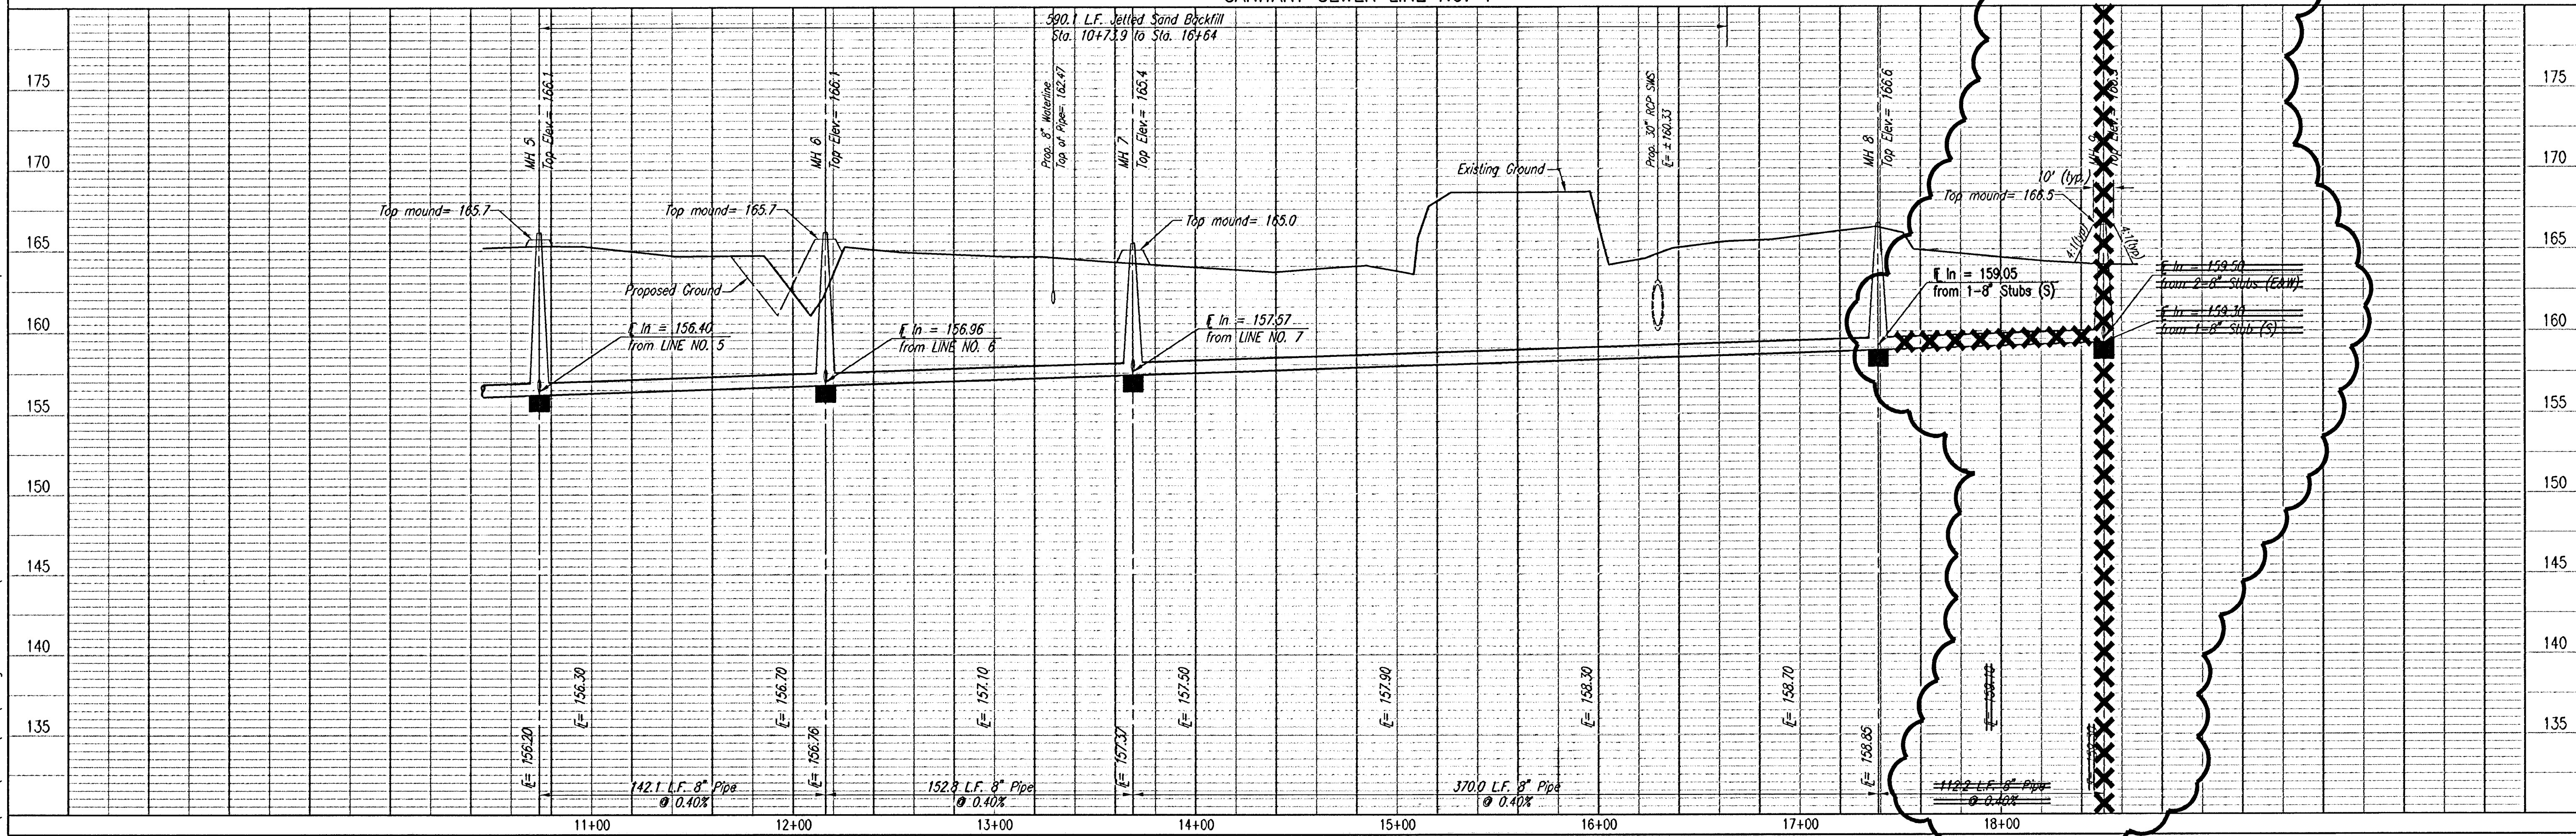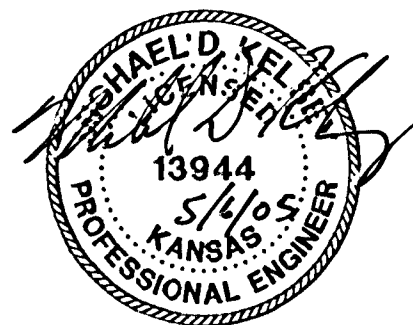

LATERAL 1, MAIN 6 OF THE NORTHWEST INTERCEPTOR SEWER	
SANITARY SEWER LINE NO. 1	
JAMES L. ARMOUR, P.E. - ACTING CITY ENGINEER CITY OF WICHITA PROJECT NO. 488-83669	
Professional Engineering Consultants, P.A. 303 S. TOPERA • WICHITA, KANSAS 67202 316-262-2691 • FAX 316-262-3003	Job No. 35-04090-5054 Date January 2005
Designed By MDK	Drawn By JGA

CHANGE ORDER NO. 1 5-02-05