


PLAN	CHECKED	DATE

PROFILE	CHECKED	DATE



DSUR: OPER. JCA SCALE: 1"=40.00
 Q:\2004\04090\000\Change Order No. 1\04090-000-C-SSPP04 05-05-2005 01:12:30 pm

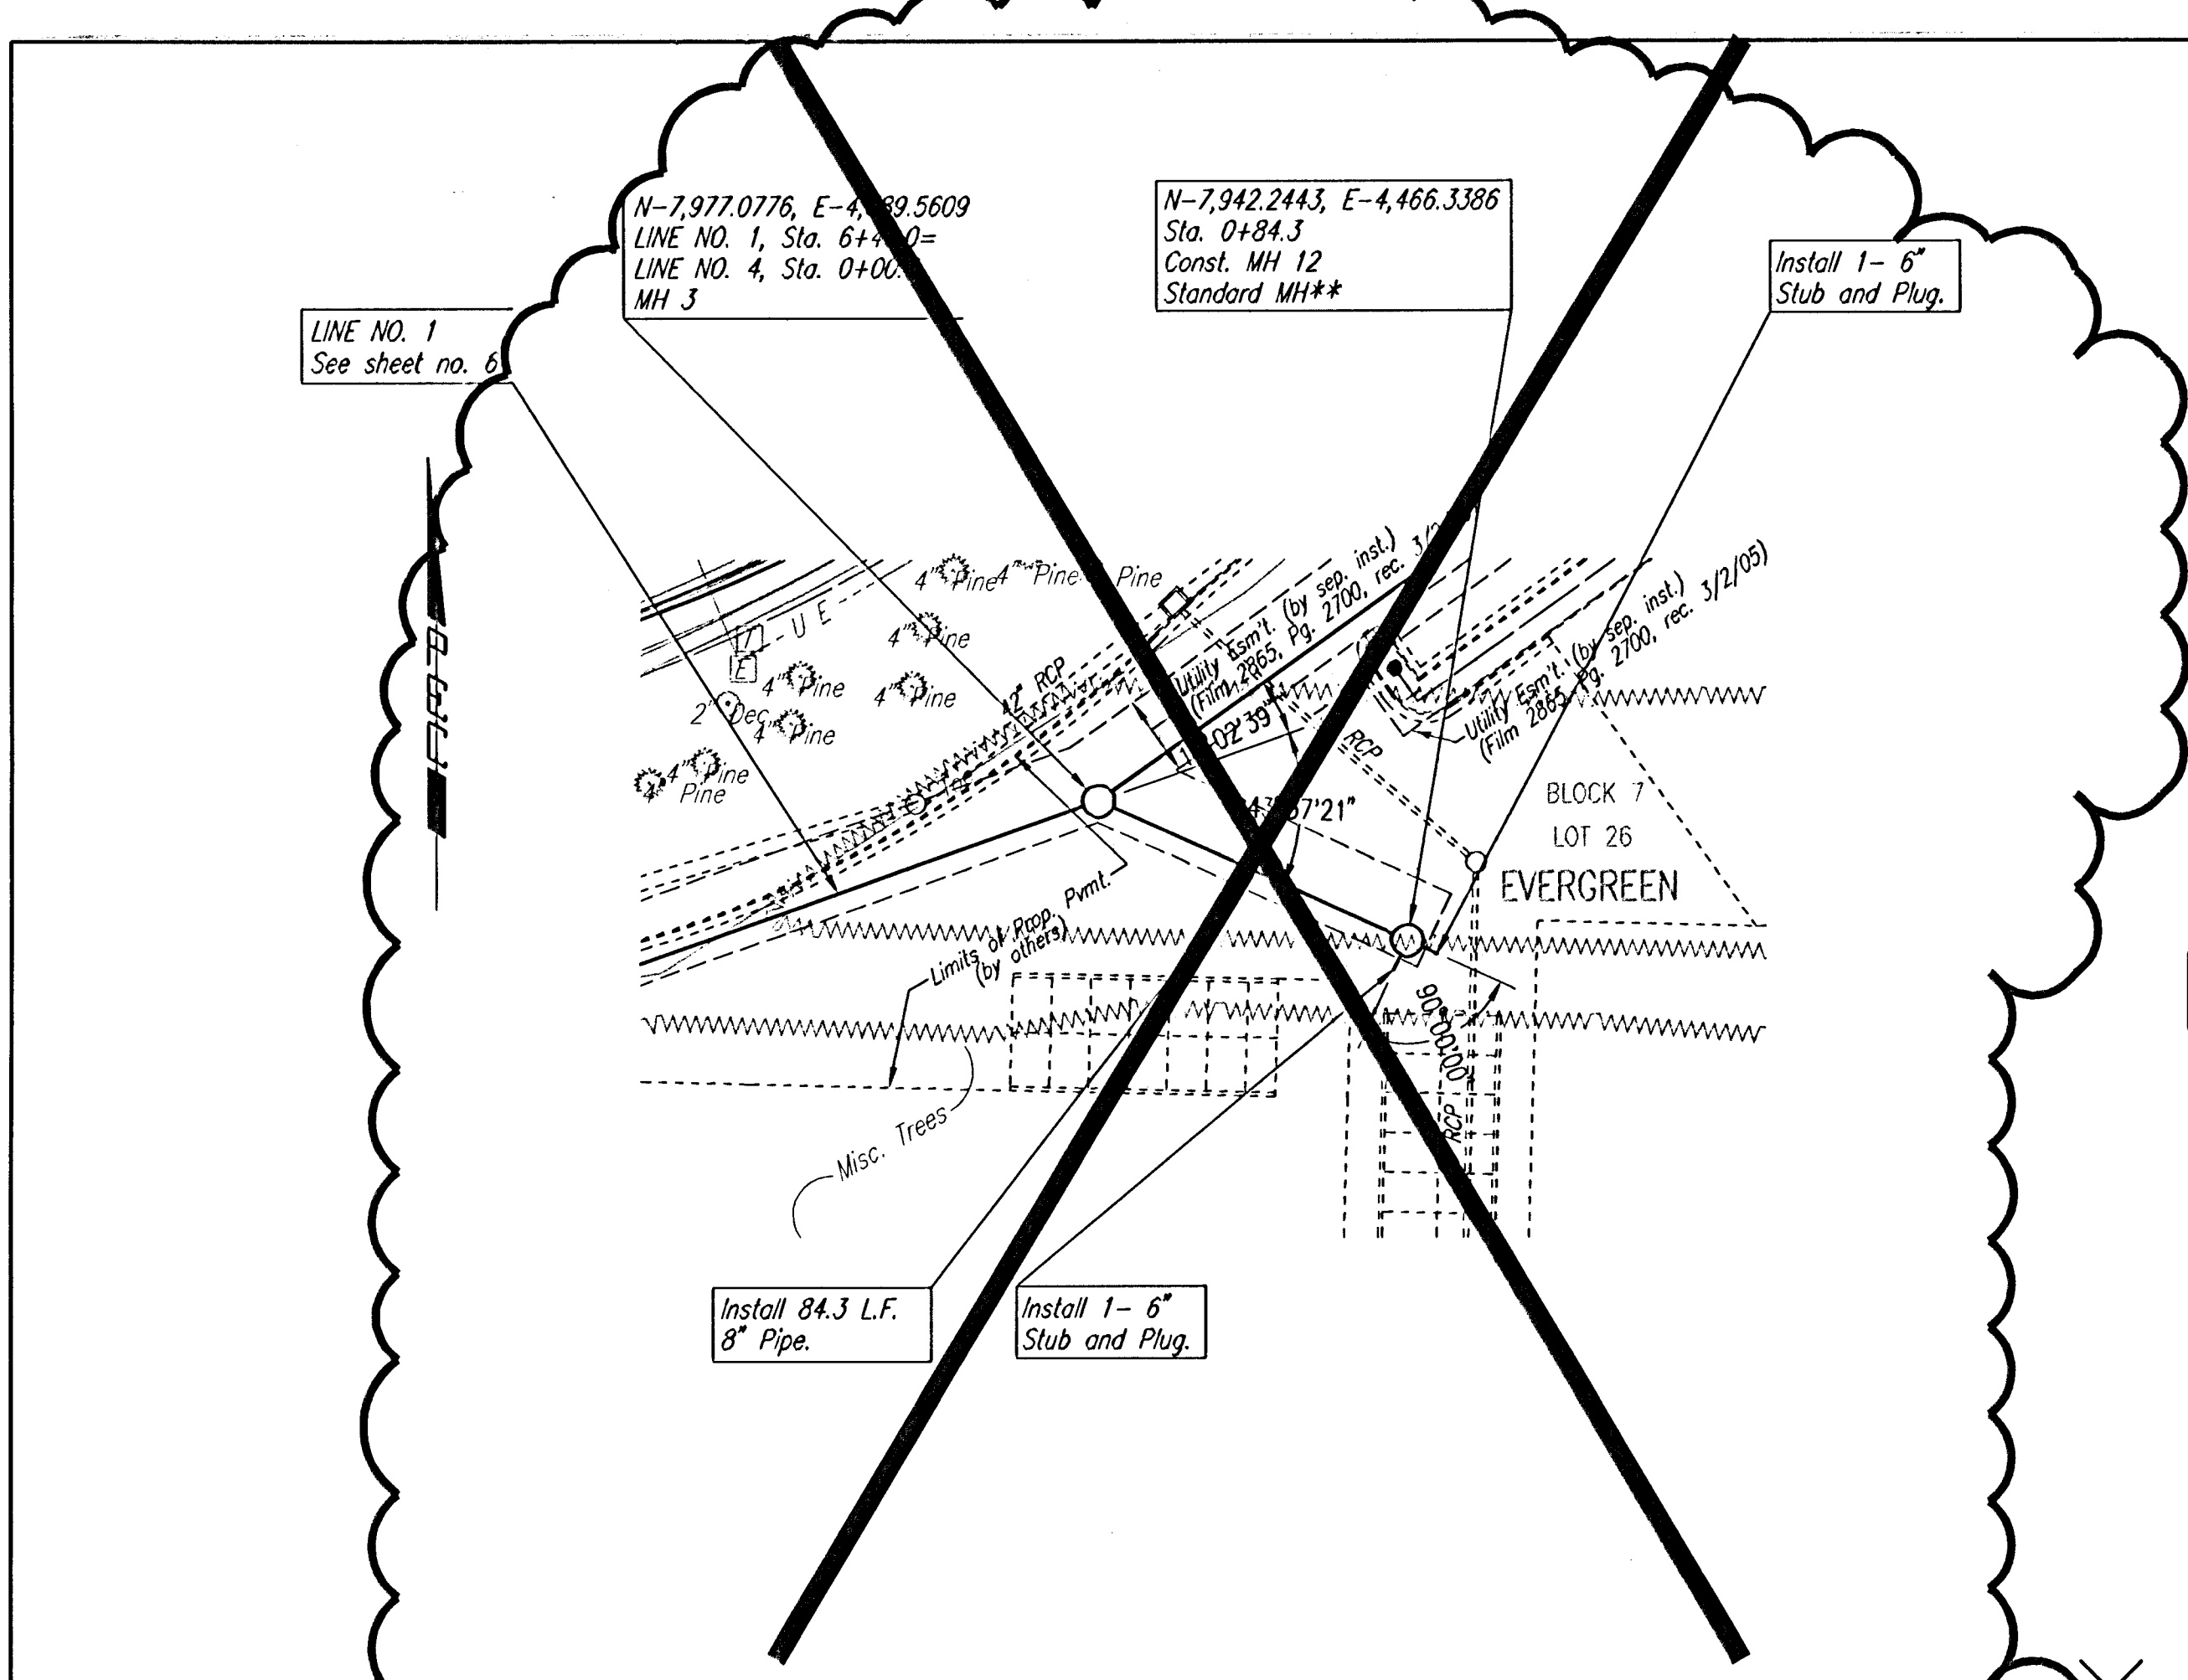


SEE SHEET NO. 3, 4, AND 5
FOR PLAT COORDINATES

** ALL MH'S TO INCLUDE
ONE (1) 6" ADJUSTMENT RING

X = TREE REMOVAL

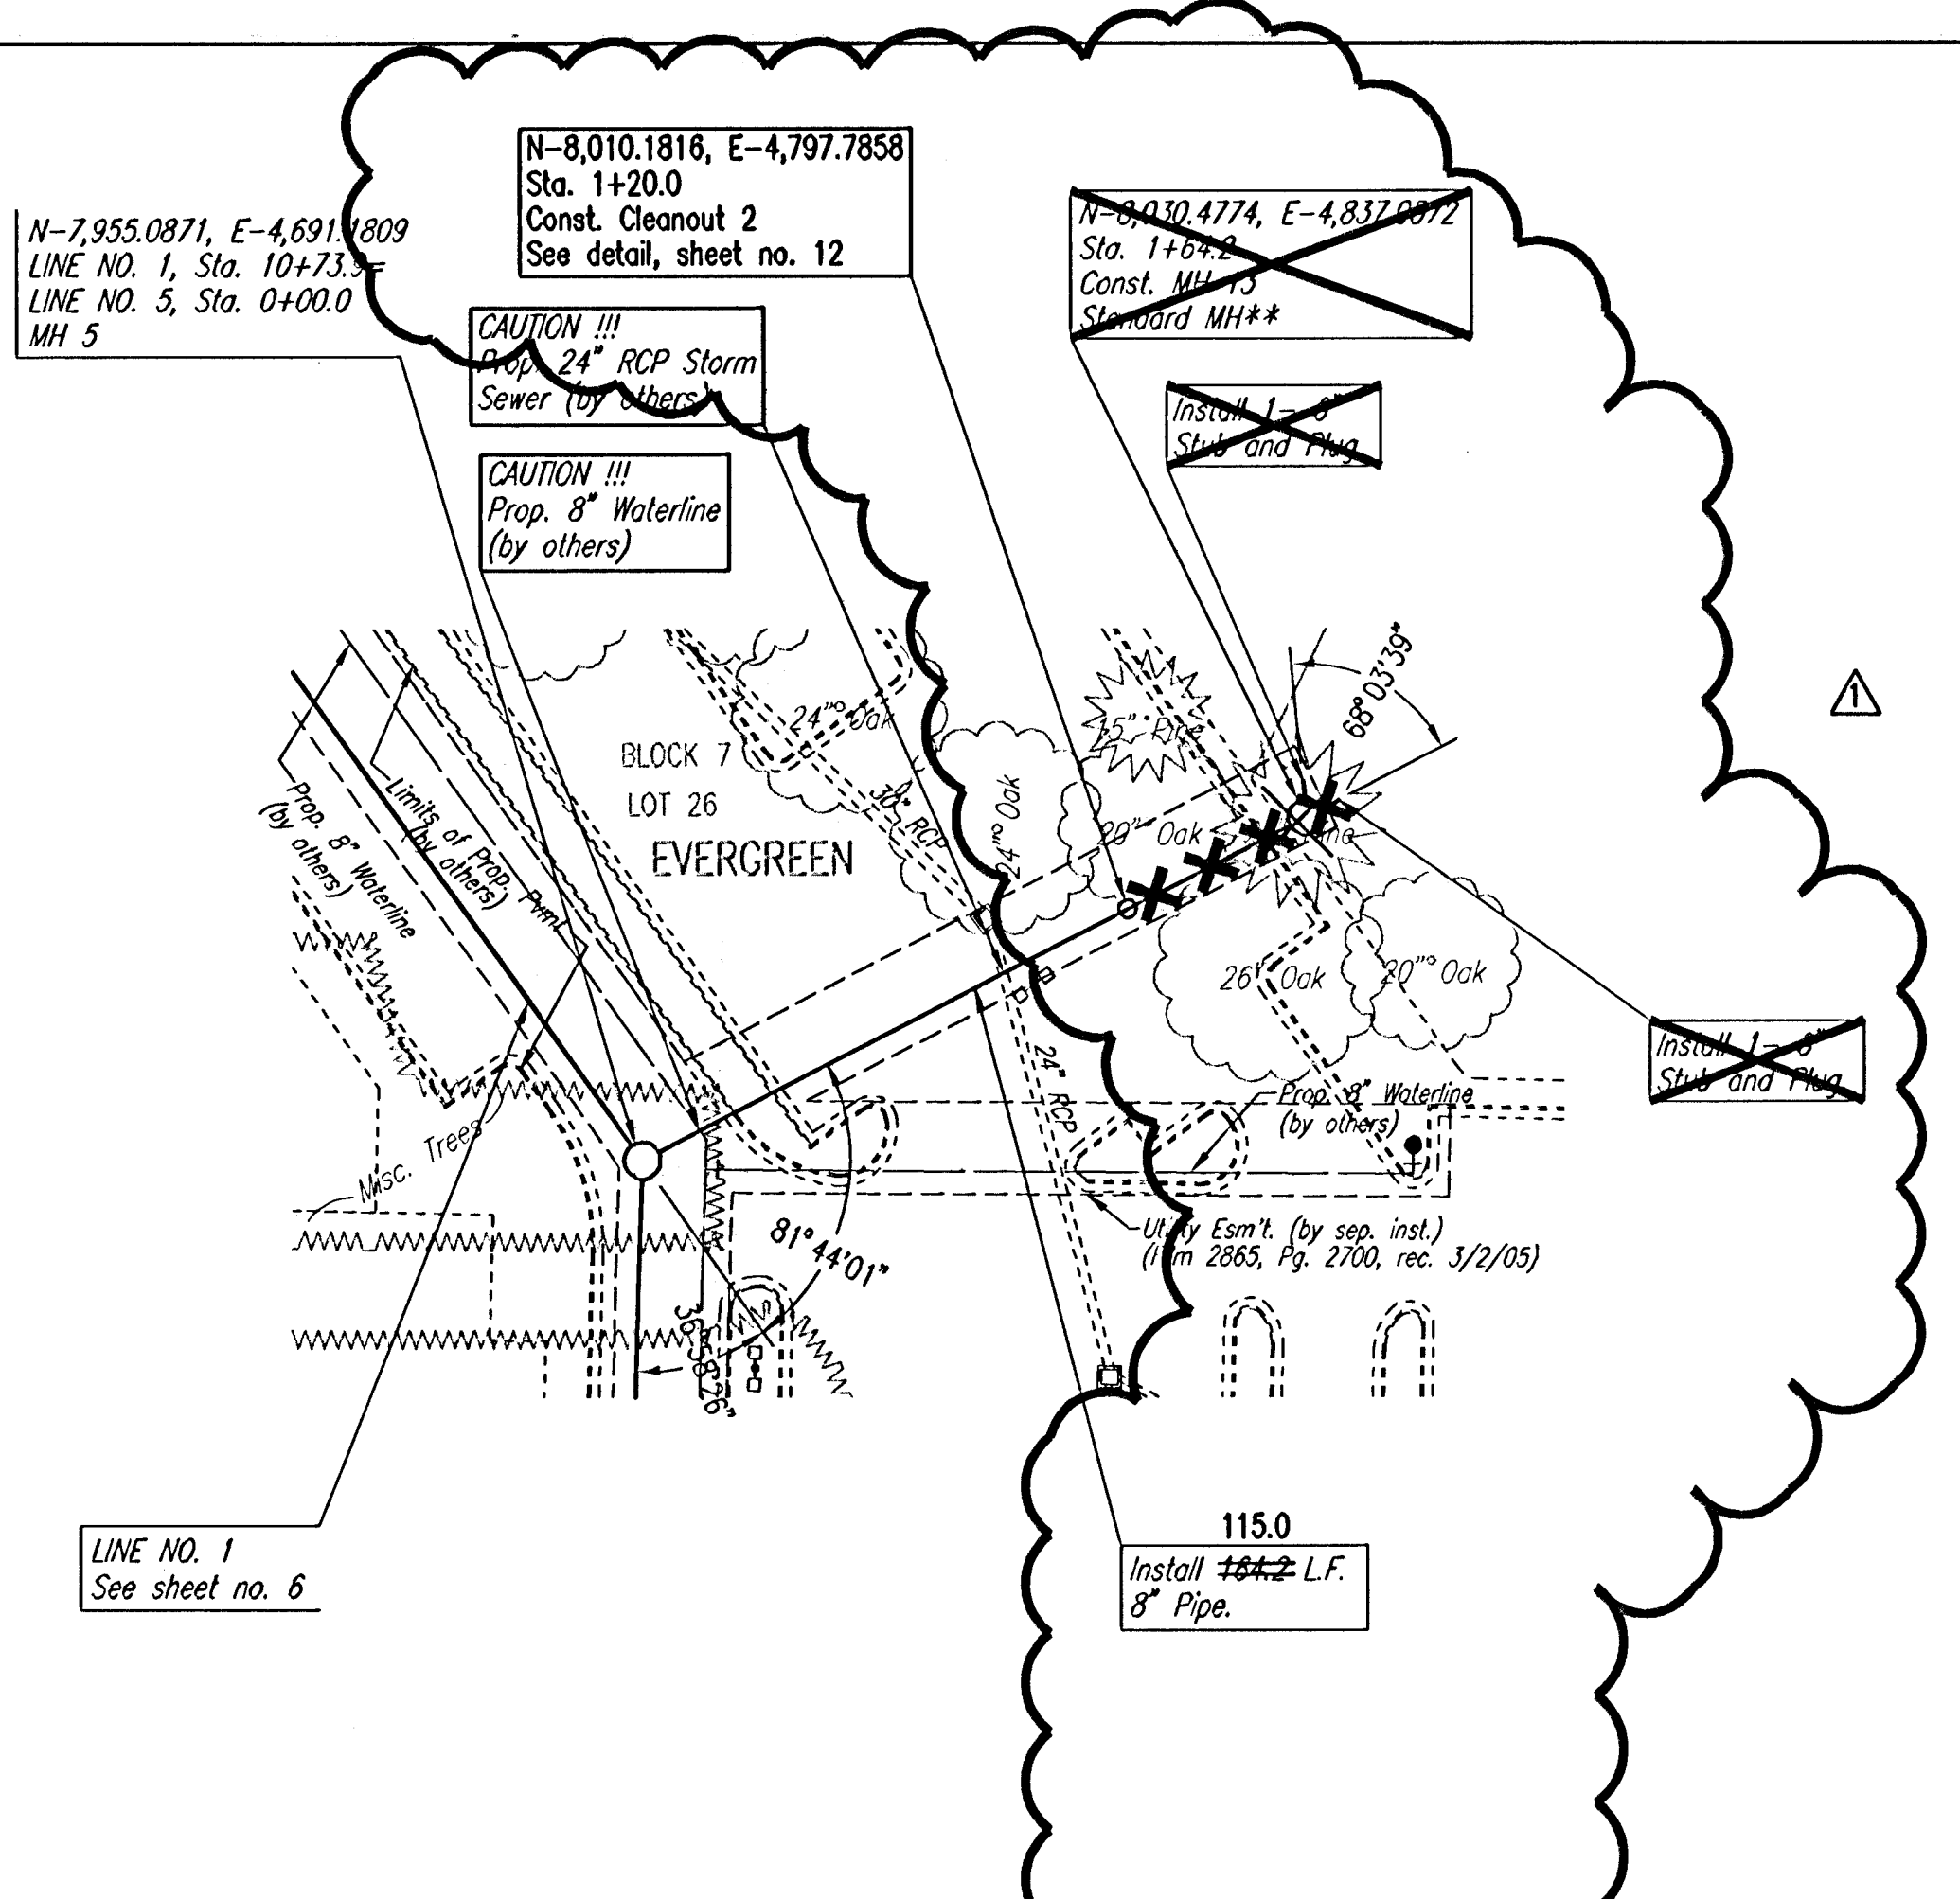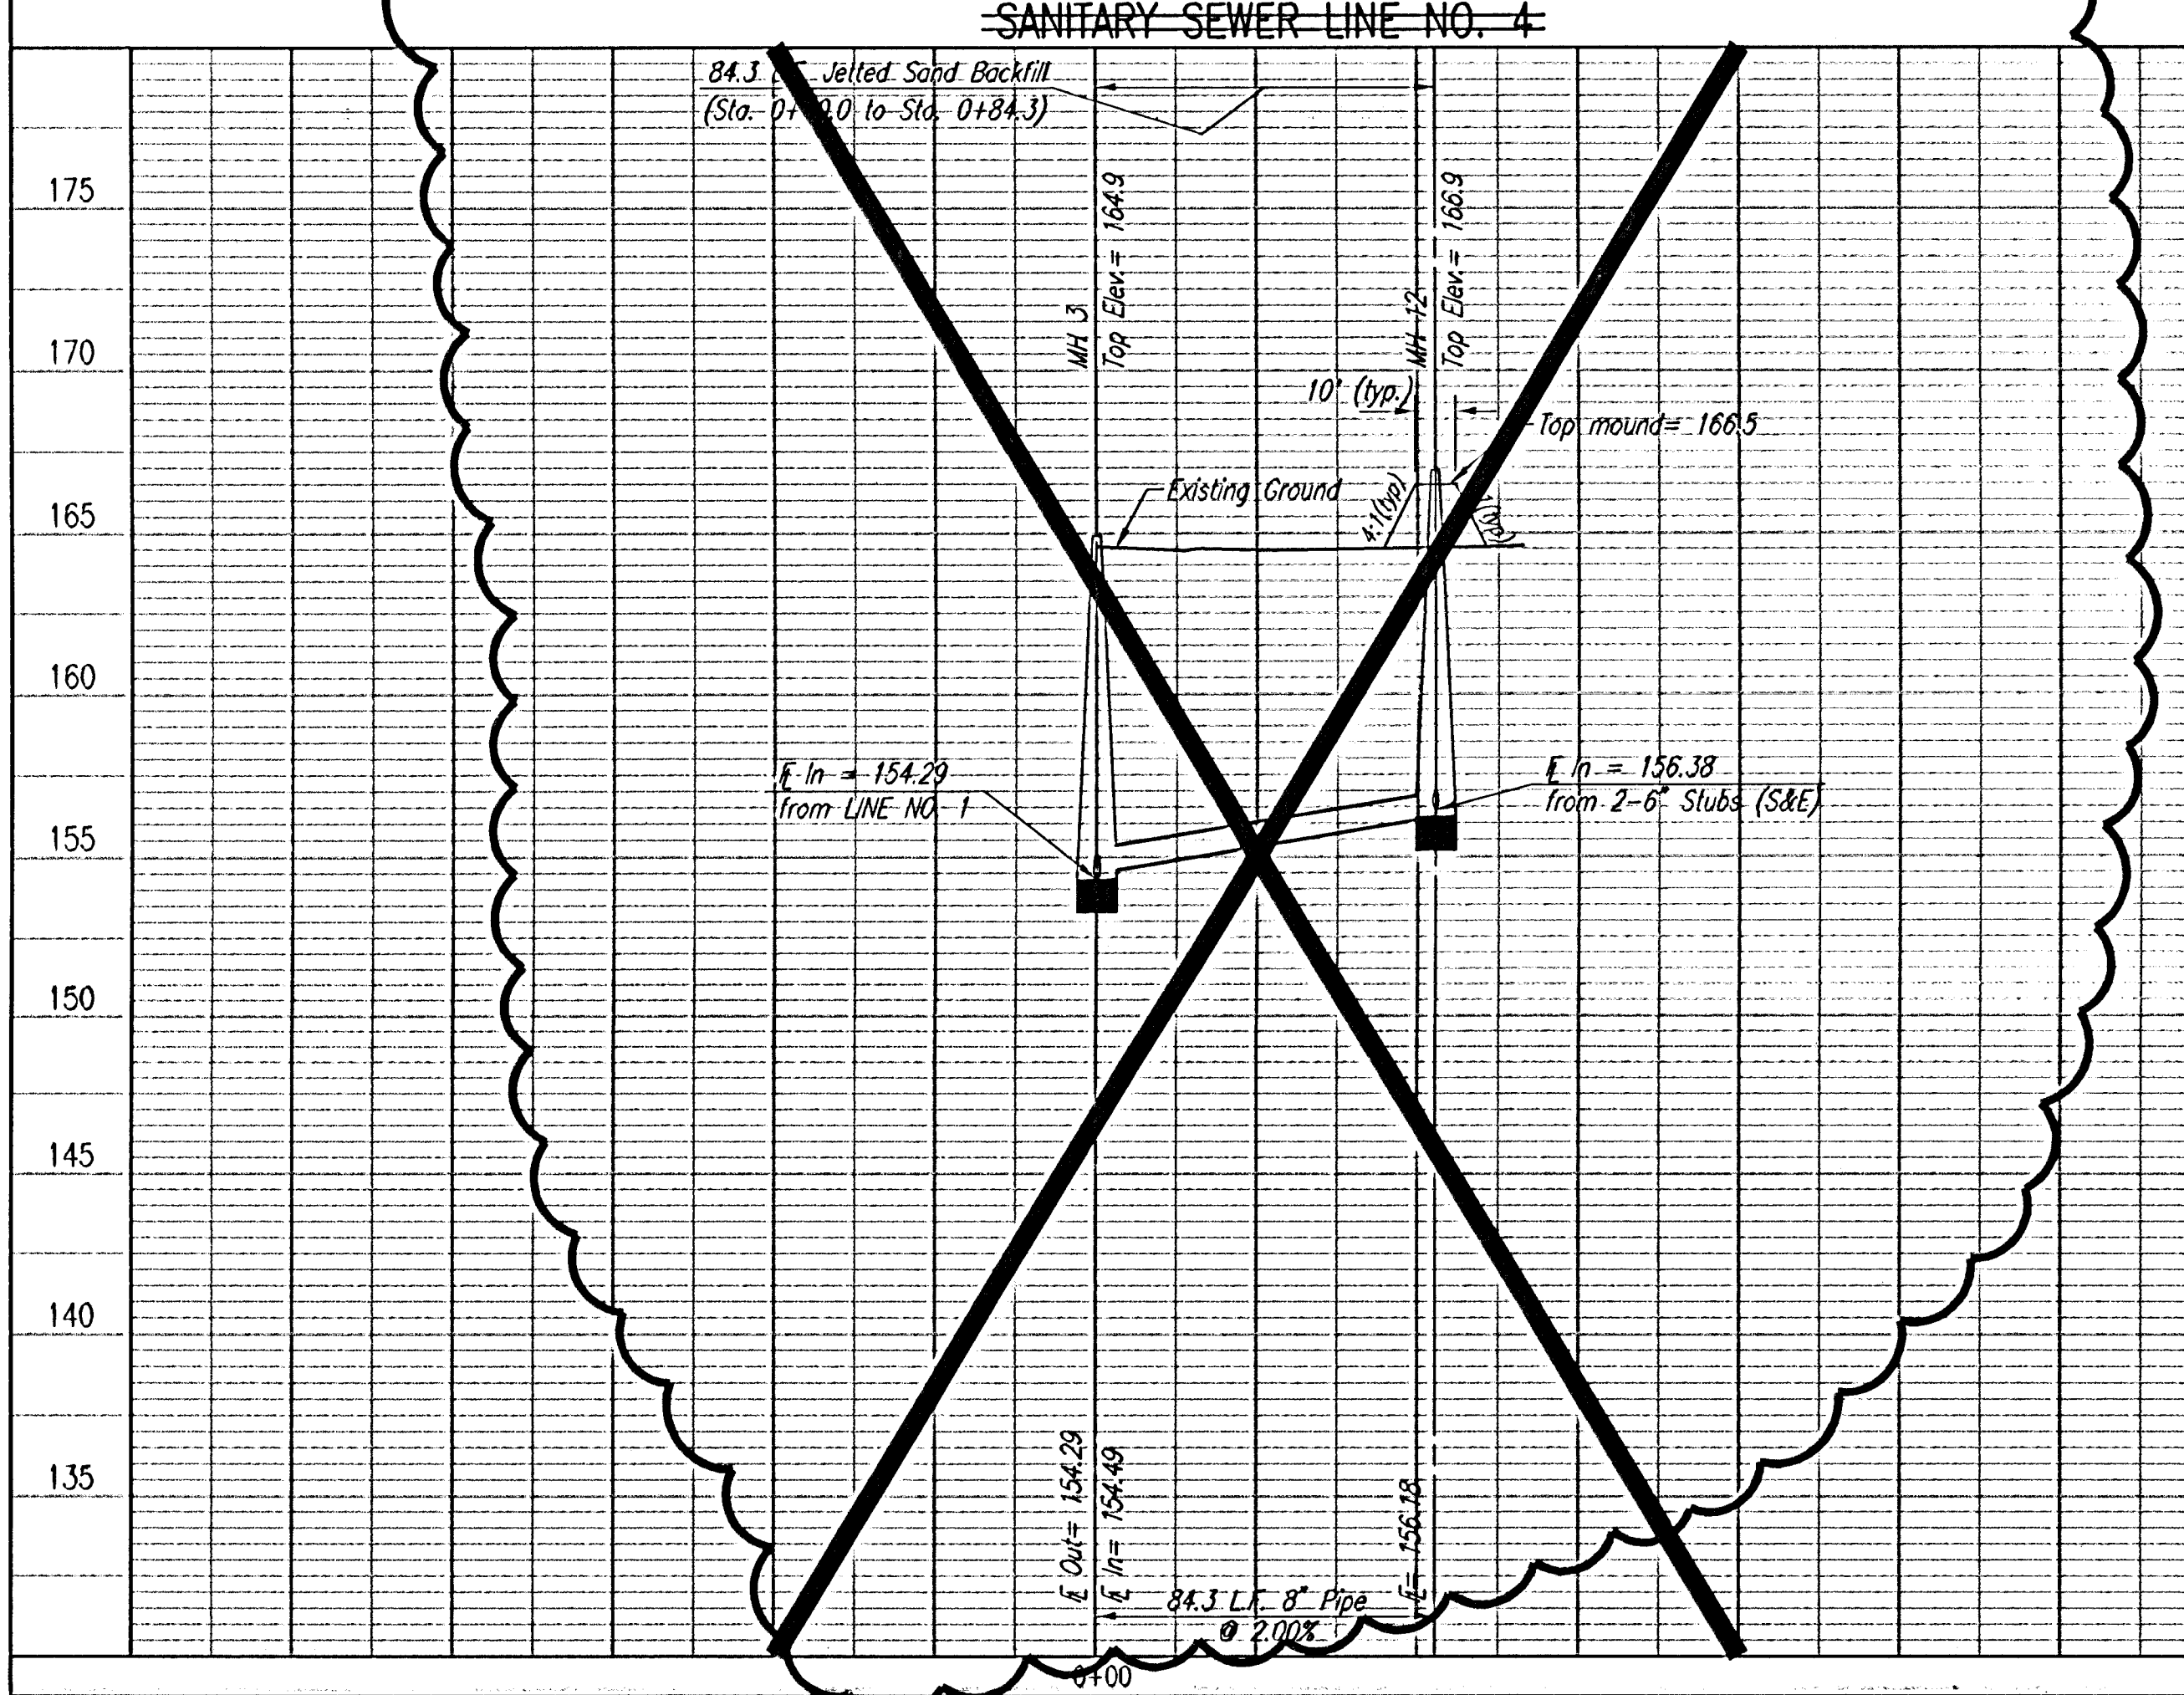

SCALE:
 PLAN: LAT. & LONG. 0 40 80
 PROFILE: HORIZ. SAME AS ABOVE
 VERT. 0 5

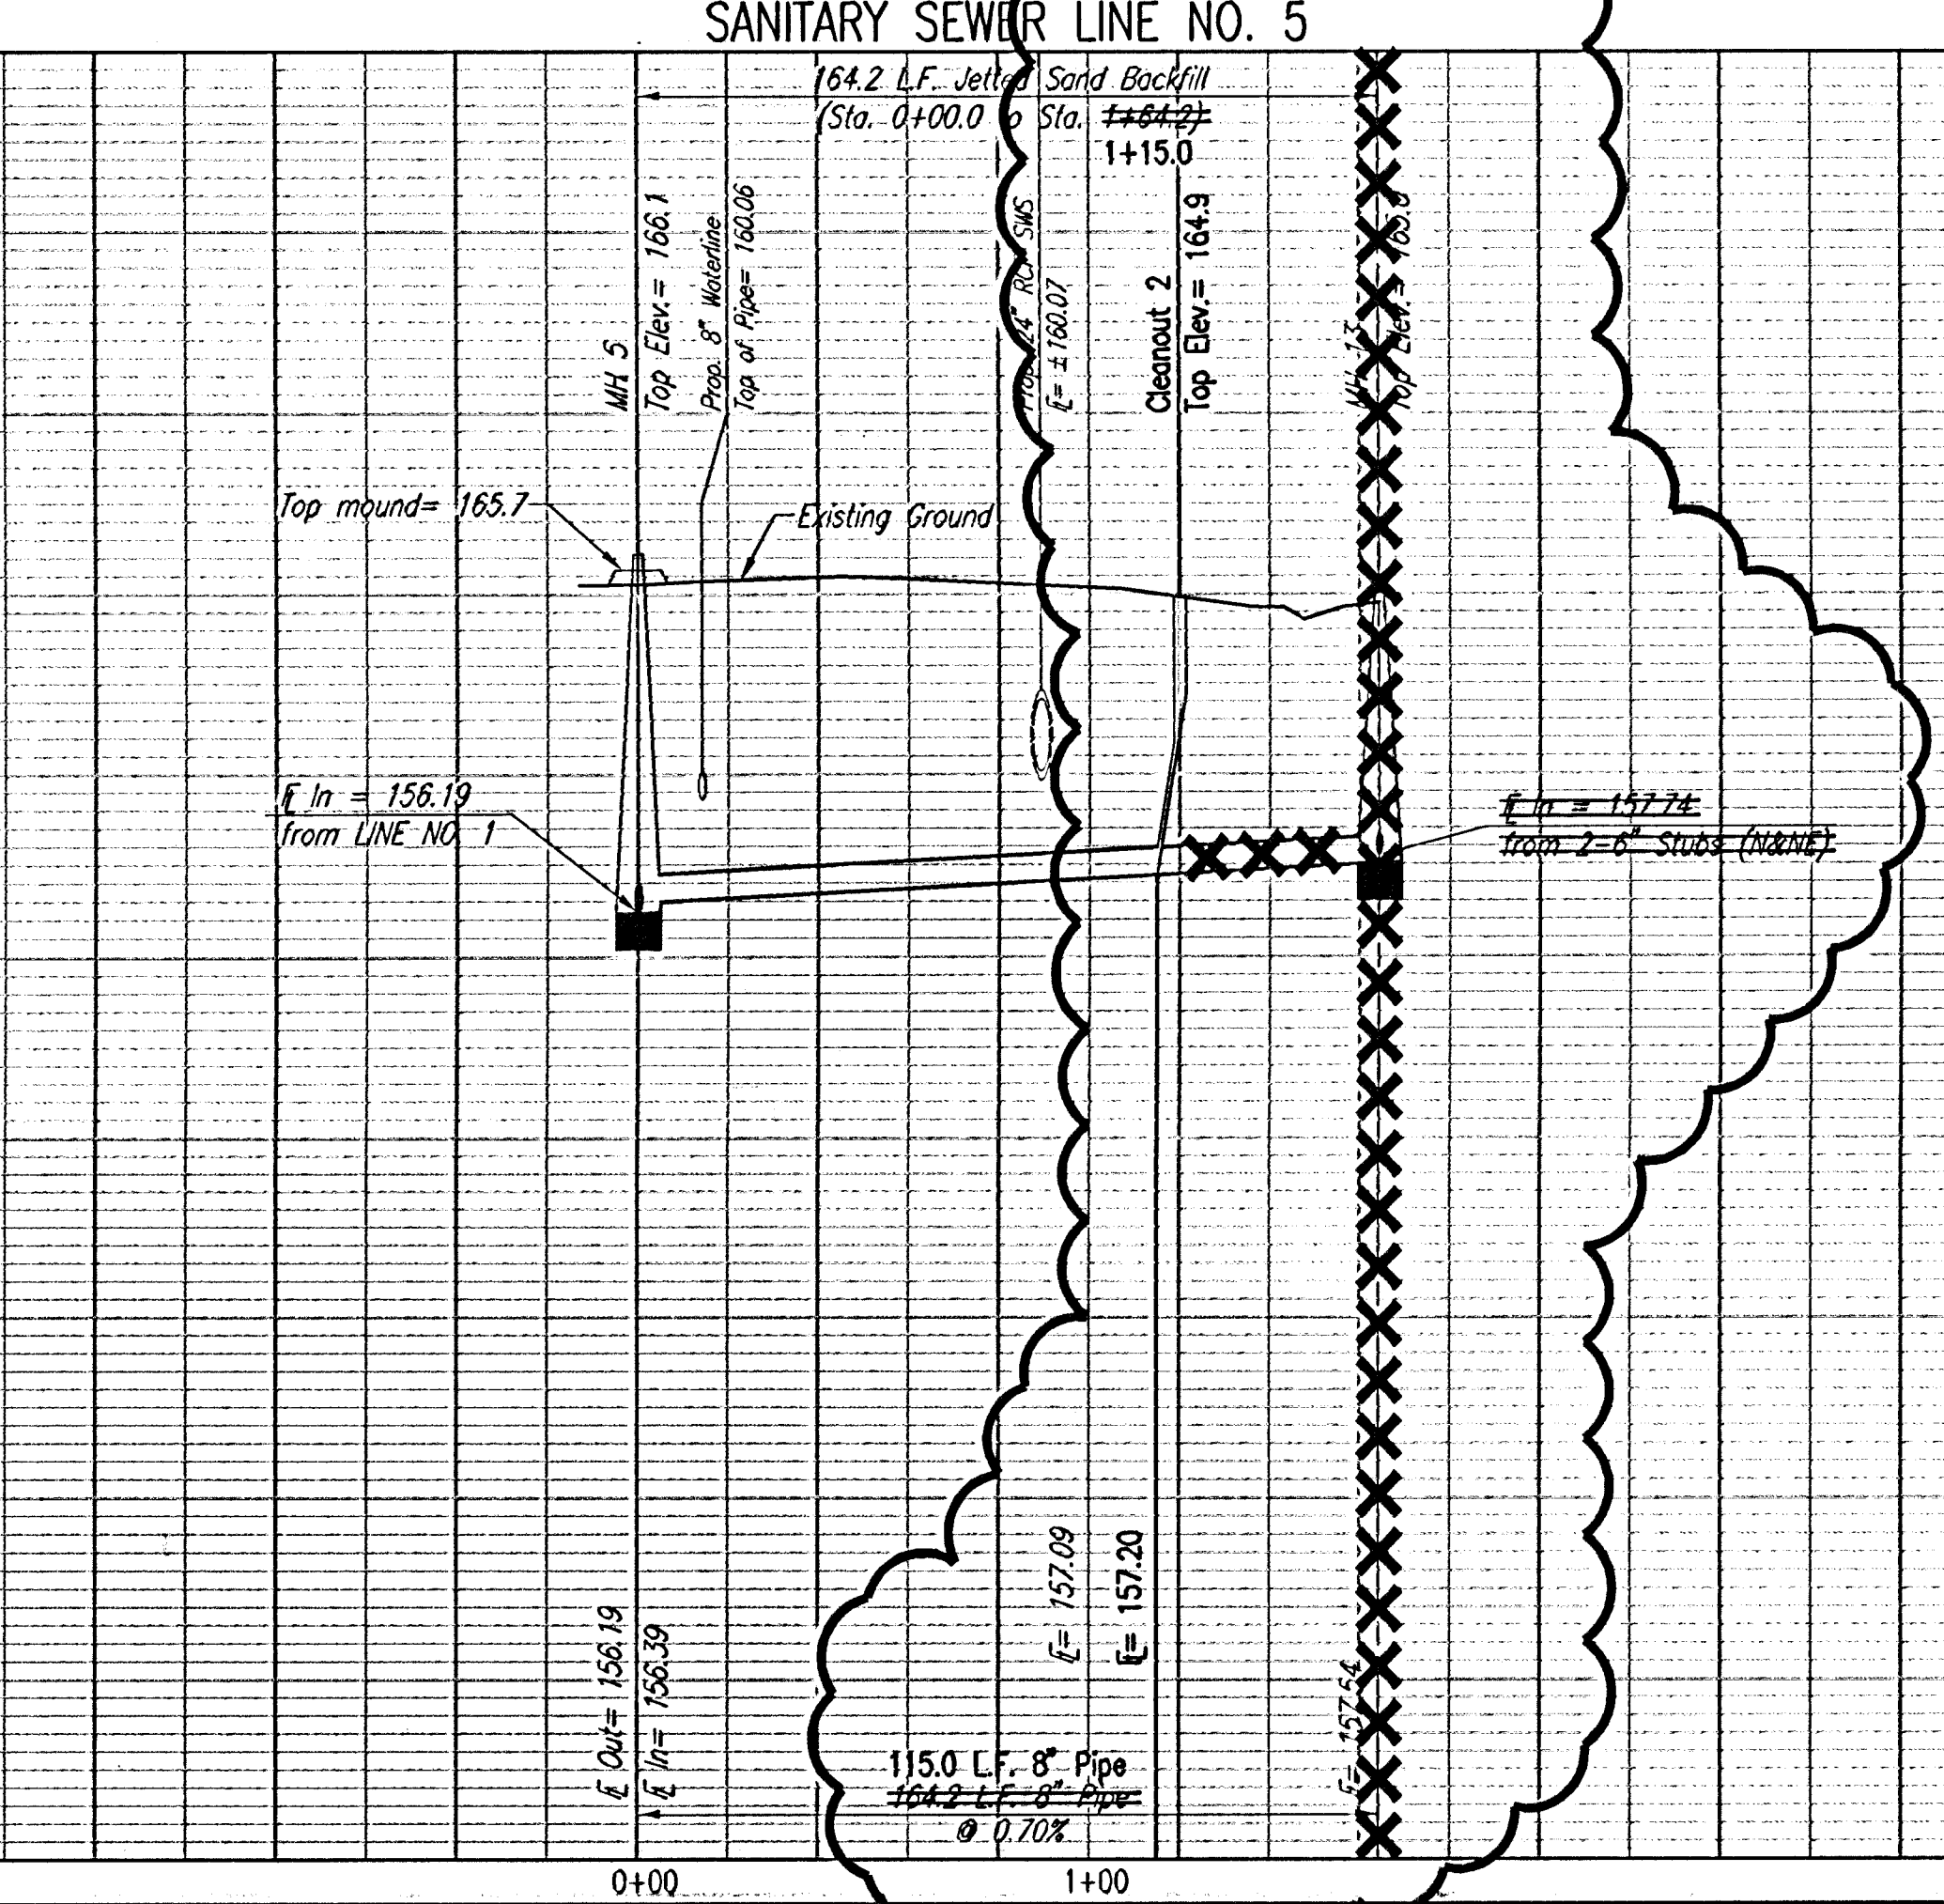

CHANGE ORDER NO. 1 5-02-05

Professional Engineering Consultants, P.A.
 303 S. TOPEKA • WICHITA, KANSAS 67202
 316-262-2691 • FAX 316-262-3003

Designed By MDK
 Drawn By JCA

Job No. 35-04090-5054
 Date January 2005

LATERAL 1, MAIN 6 OF THE
 NORTHWEST INTERCEPTOR SEWER

SANITARY SEWER LINE NO. 4 & 5

JAMES L. ARMOUR, P.E. - ACTING CITY ENGINEER
 CITY OF WICHITA PROJECT NO. 468-63969

Sheet 9 of 18