BENCHMARK:

City Disc In T.C. Adj. to F.H. 17.5' North of Monterey. At the South West Corner of Lot 10 Block C Auburn Hills 15th Addition.
Elev. = 177.39 (City Datum)

City Disc In T.C. Adj. to F.H. 27' North of Monterey. At the Intersection of Monterey and Auburn Hills.
Elev. = 179.40 (City Datum)

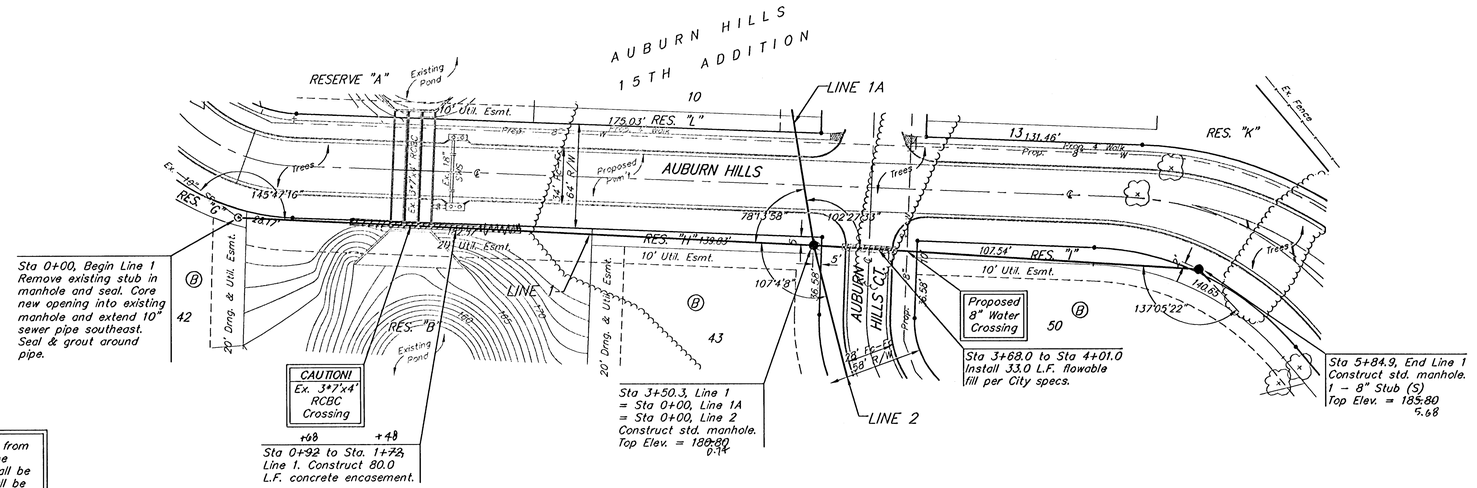

Scale: 1" = 40' Horizontal
1" = 5' Vertical
• = Iron

All trench and manhole excavation areas from Sta. 0+00 to Sta. 5+84.9, Line 1 shall be backfilled with sand. The sand backfill shall be within two feet of existing grade and shall be water–jetted and vibrated during backfilling. All costs shall be subsidiary to pipe cost.

Remove trees only as necessary for sanitary sewer construction and only with permission of Developer or Baughman Co. Cost of removal to be incidental to lump sum bid item "Site Clearing & Restoration".

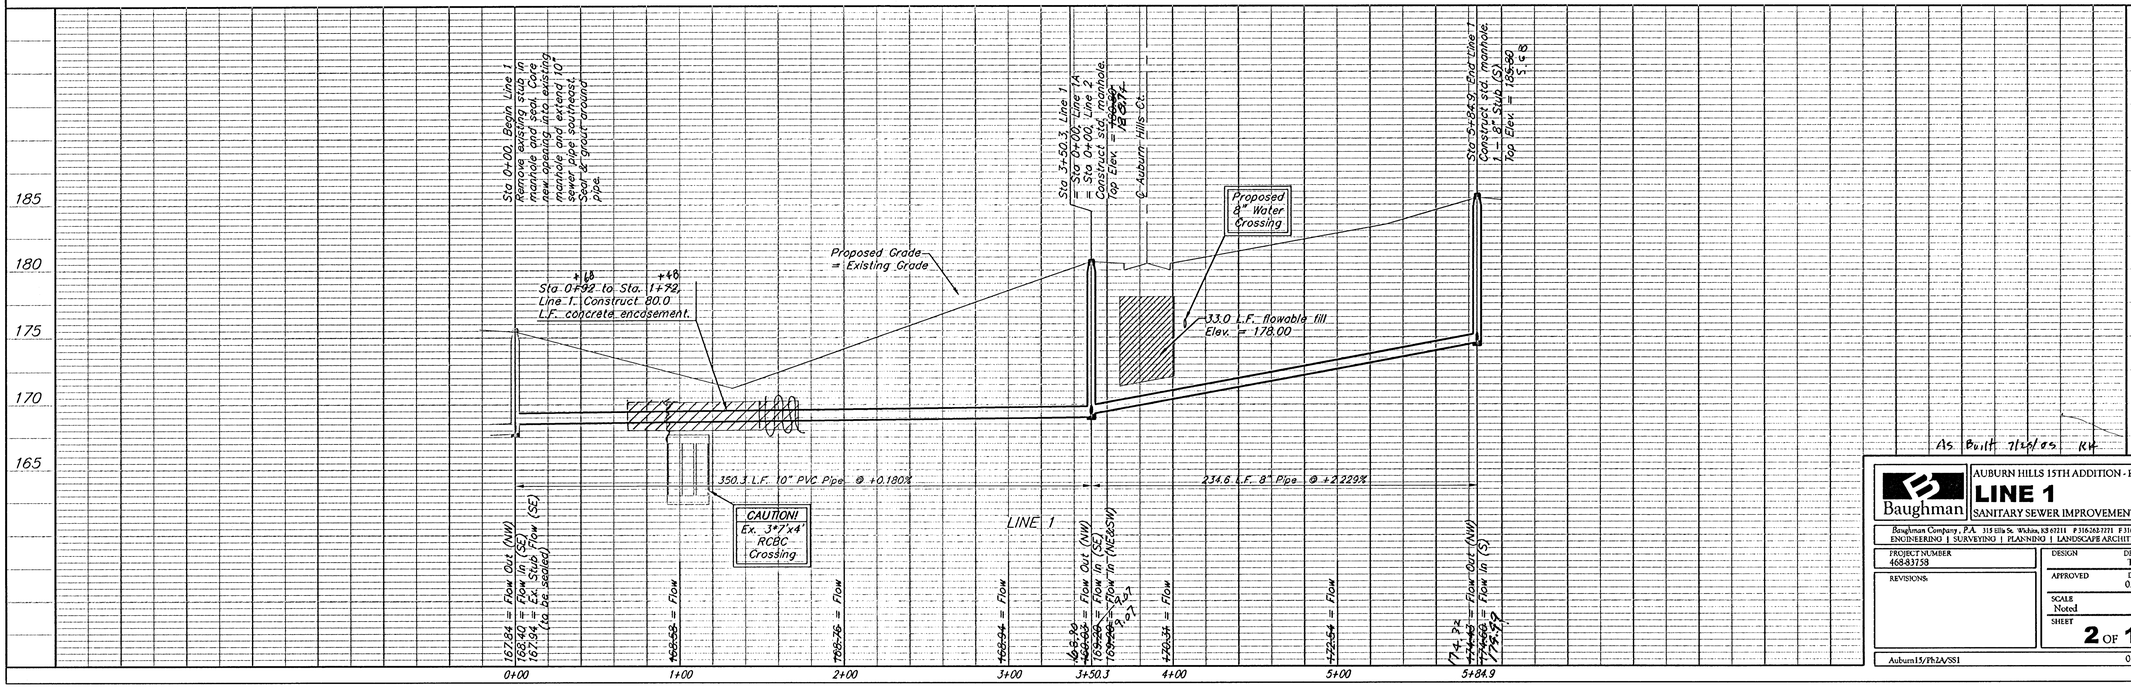

As Built 7/29/05 RH

Baughman

AUBURN HILLS 15TH ADDITION - PHASE 2A

LINE 1

SANITARY SEWER IMPROVEMENTS

Baughman Company, P.A. 315 Ellis St. Wichita, KS 67211 P 316.263.2221 F 316.263.0149
ENGINEERING | SURVEYING | PLANNING | LANDSCAPE ARCHITECTURE

PROJECT NUMBER	DESIGN	DRAWN
468-83758		TMS
REVISIONS:	APPROVED	DATE
		03/05
	SCALE	
	Noted	
	SHEET	
	2 OF 15	

Auburn15/Ph2A/SS1 04-11-E095