
BENCHMARK:


City Disc In T.C. Adj. to F.H. 17.5' North of Monterey. At the South West Corner of Lot 10 Block C Auburn Hills 15th Addition.
Elev. = 177.39 (City Datum)

City Disc In T.C. Adj. to F.H. 27' North of Monterey. At the Intersection of Monterey and Auburn Hills.
Elev. = 179.40 (City Datum)

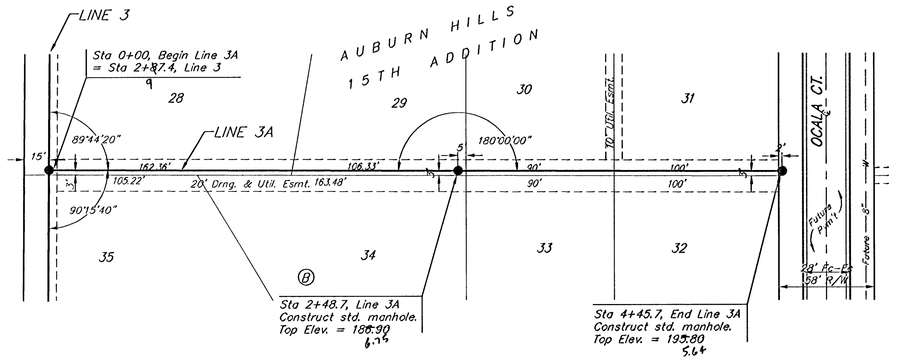

Scale: 1" = 40' Horizontal
1" = 5' Vertical
• = Iron

Remove trees only as necessary for sanitary sewer construction and only with permission of Developer or Baughman Co. Cost of removal to be incidental to lump sum bid item "Site Clearing & Restoration".

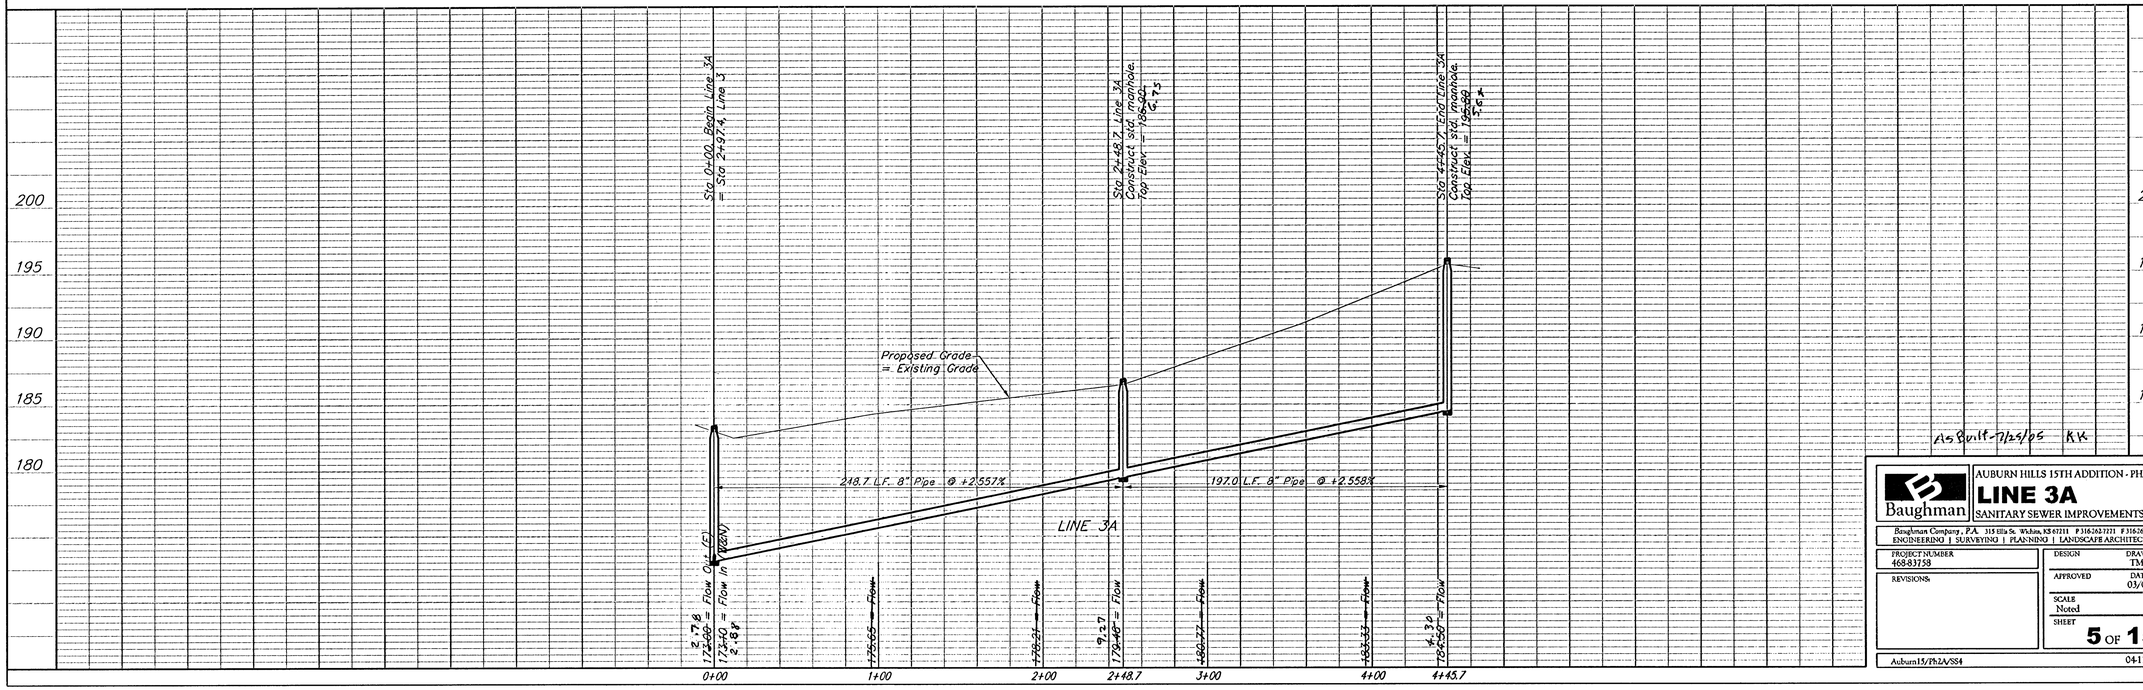

As Built-7/25/05 KK

Baughman

AUBURN HILLS 15TH ADDITION - PHASE 2A

LINE 3A

SANITARY SEWER IMPROVEMENTS

Baughman Company, P.A. 315 Ellis St. Wichita, KS 67211 P 316.263.7721 F 316.262.6749
ENGINEERING | SURVEYING | PLANNING | LANDSCAPE ARCHITECTURE

PROJECT NUMBER 468-83758

DESIGN — DRAWN TMS

APPROVED — DATE 03/05

REVISIONS:

SCALE Noted

SHEET 5 OF 15

Auburn15/Ph2AVSS4

04-11-E095