


LATERAL 2, MAIN 7 OF THE NORTHWEST INTERCEPTOR SEWER IN THE CITY OF WICHITA

OCA NO. 744144
CITY OF WICHITA PROJECT NO. 468-83808
JAMES L. ARMOUR, P.E. - CITY ENGINEER

INDEX OF SHEETS

SHEET NO. 1	TITLE SHEET
SHEET NO. 2	KEY MAP AND GENERAL NOTES
SHEET NO. 3-4	PLATS
SHEET NO. 5-7	PLAN/PROFILE
SHEET NO. 8	TYPE "P" MANHOLE DETAILS
SHEET NO. 9	FRAME & COVER DETAILS
SHEET NO. 10	RISER DETAILS
SHEET NO. 11-14	SOIL EROSION BMP DETAILS

*McCullough Excavation, Inc. - Contractor
Koleczek/Shalander, City-Inspectors
Released 2/11/06
Per Plan
Risers & Stub
.pdf by JDL 4/26/06*

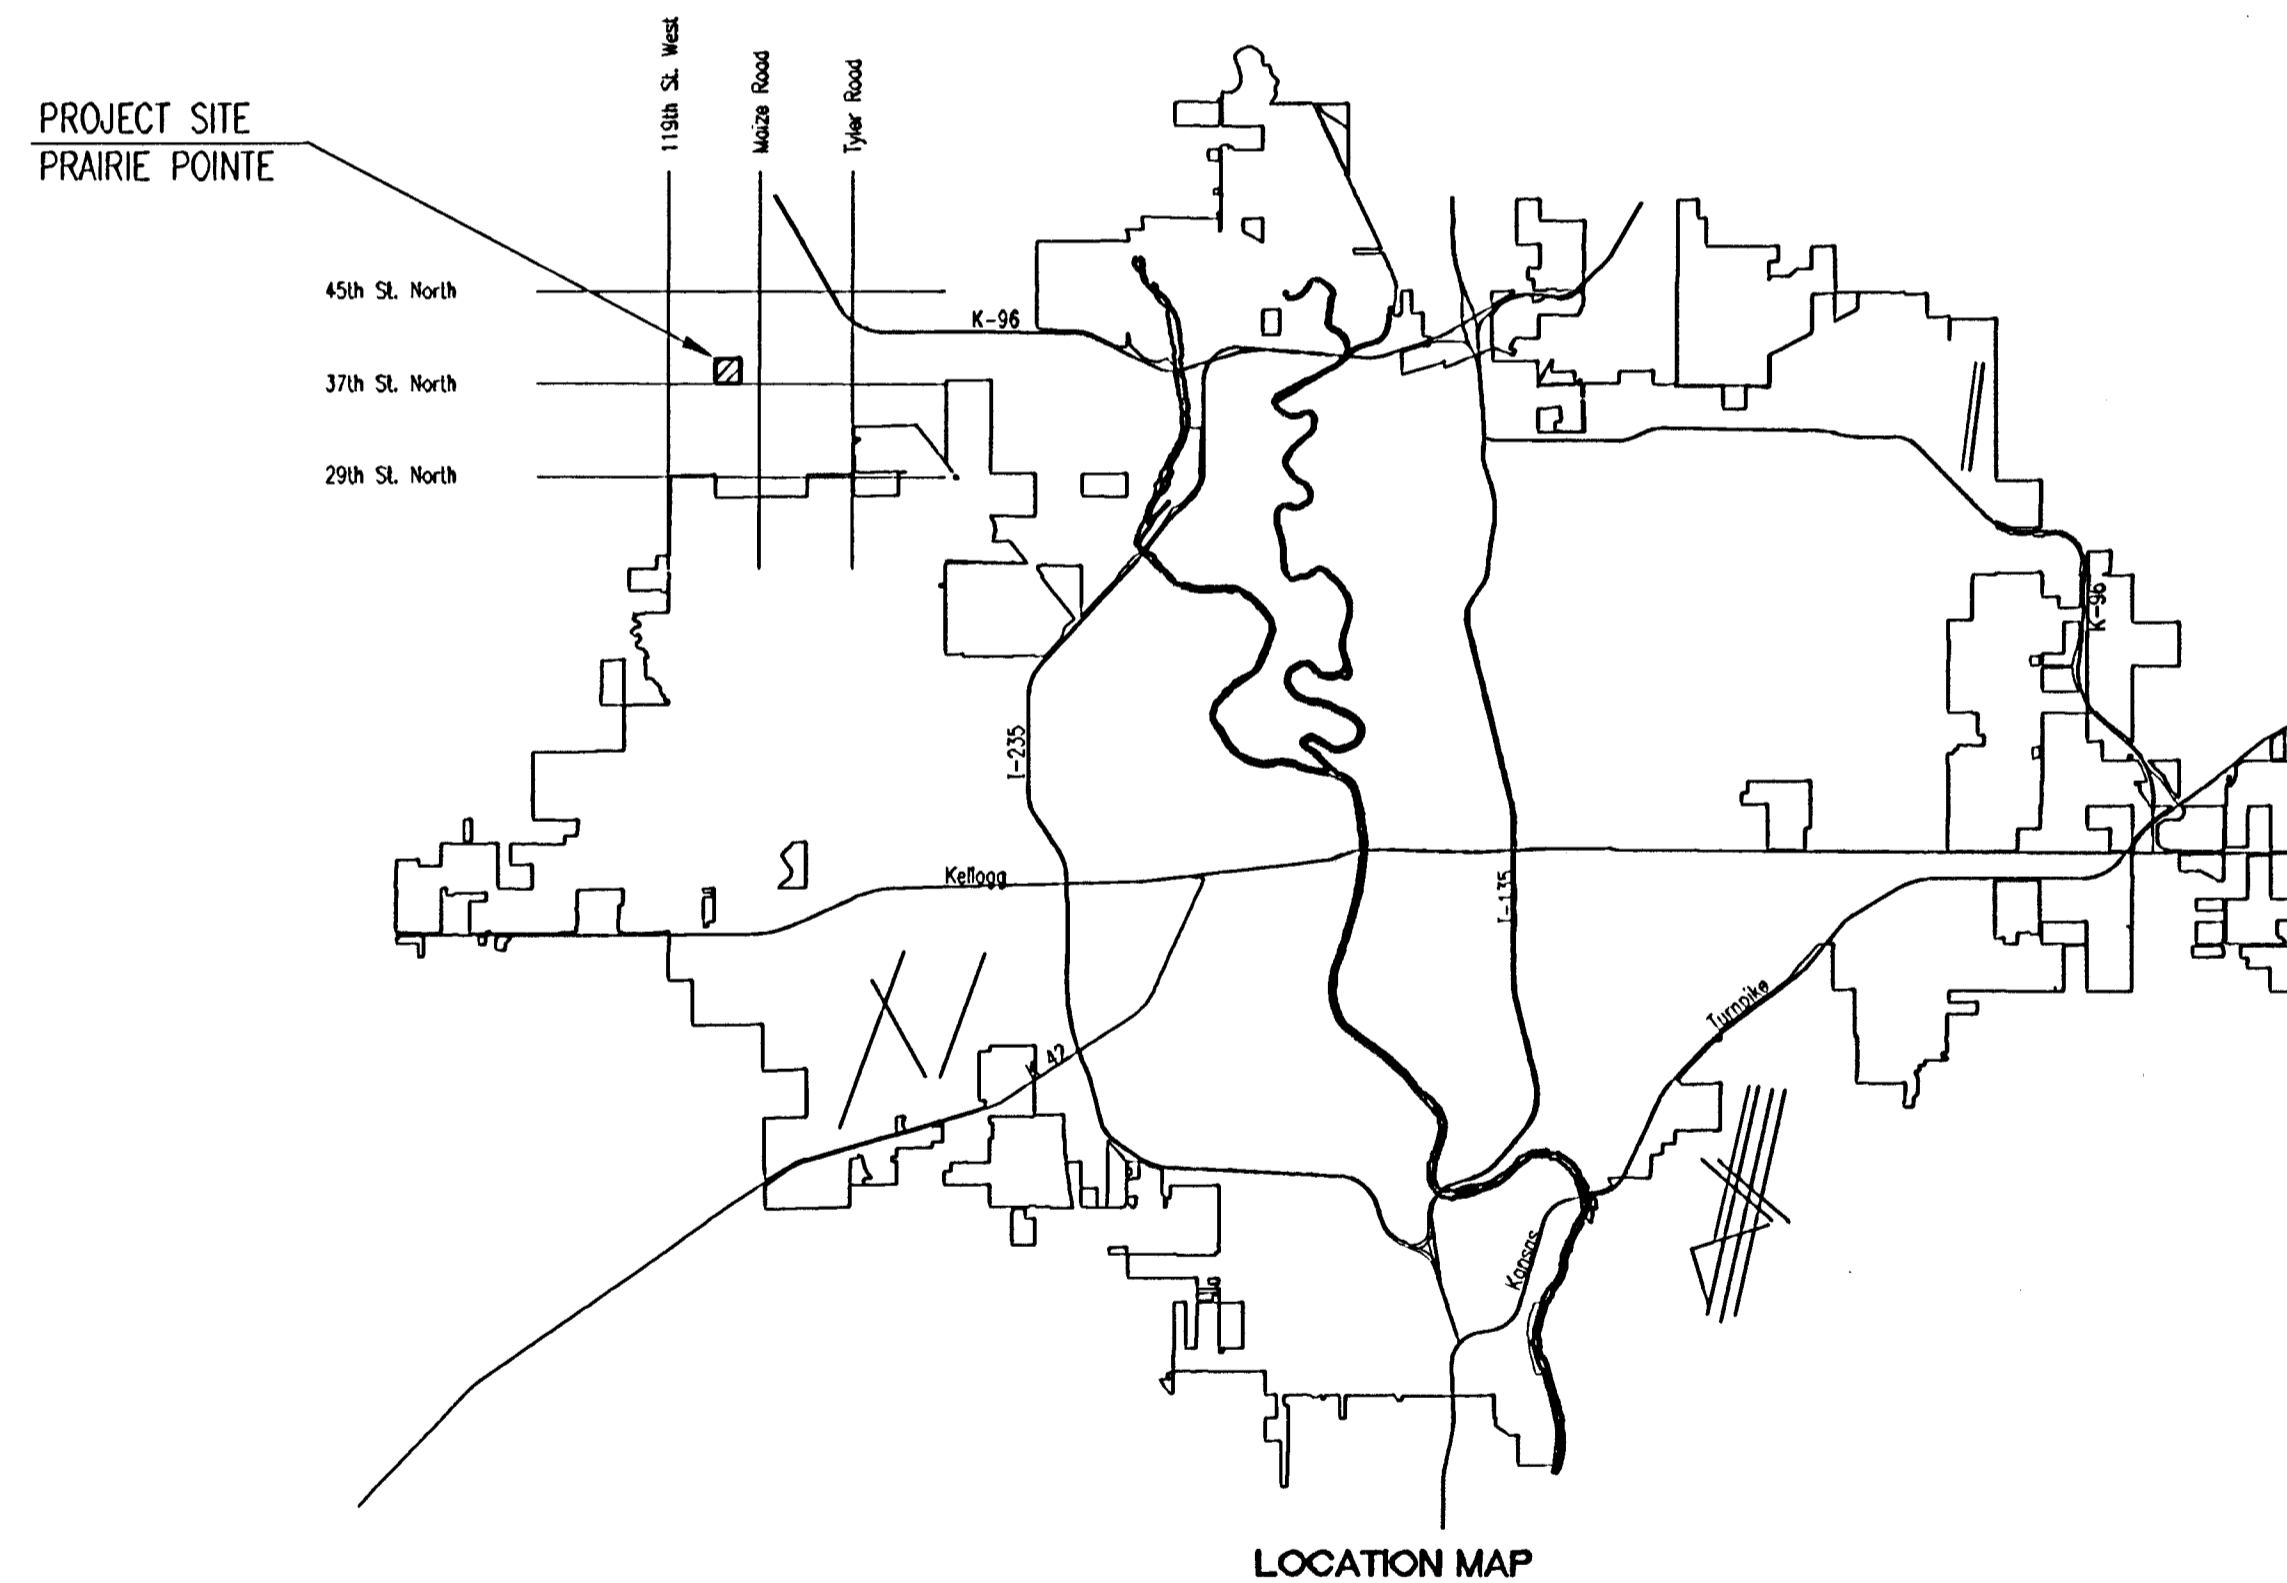

CONSTRUCTION SCHEDULE/SEQUENCE

THE CONTRACTOR FOR EACH OF THE FOLLOWING PRAIRIE POINTE PHASE 2 PROJECTS SHALL COORDINATE THEIR EFFORTS WITH OTHER CONTRACTORS PERFORMING WORK IN THIS AREA SUCH THAT ANY NECESSARY SIMULTANEOUS CONSTRUCTION CAN PROCEED CONCURRENTLY WITHOUT CAUSING UNDUE DELAYS SO THAT CONSTRUCTION CAN BE COMPLETED WITHIN THE TIME FRAMES AS NOTED.

SANITARY SEWER (468-83808)
THE CONTRACTOR SHALL COMPLETE, INCLUDING TESTING AND ACCEPTANCE, ALL WORK ON THE PROJECT BY DECEMBER 20, 2005.

WATER DISTRIBUTION SYSTEM (448-89951)
THE CONTRACTOR SHALL COMPLETE PRAIRIE POINTE - PHASE 2 WATERLINE CONSTRUCTION BY JANUARY 31, 2006.

STREETS/DRAINAGE (472-84042)
THE CONTRACTOR SHALL COMPLETE PRAIRIE POINTE - PHASE 2 STREETS/DRAINAGE CONSTRUCTION BY MARCH 31, 2006.

37TH STREET ASPHALT MAT PAVING (472-84044)
THE CONTRACTOR SHALL COMPLETE PRAIRIE POINTE - 37TH STREET ASPHALT MAT PAVING CONSTRUCTION BY DECEMBER 16, 2005.

SEPTEMBER 2005

PLANS PREPARED BY
PROFESSIONAL ENGINEERING CONSULTANTS, P.A.
ENGINEERS
WICHITA, KANSAS

