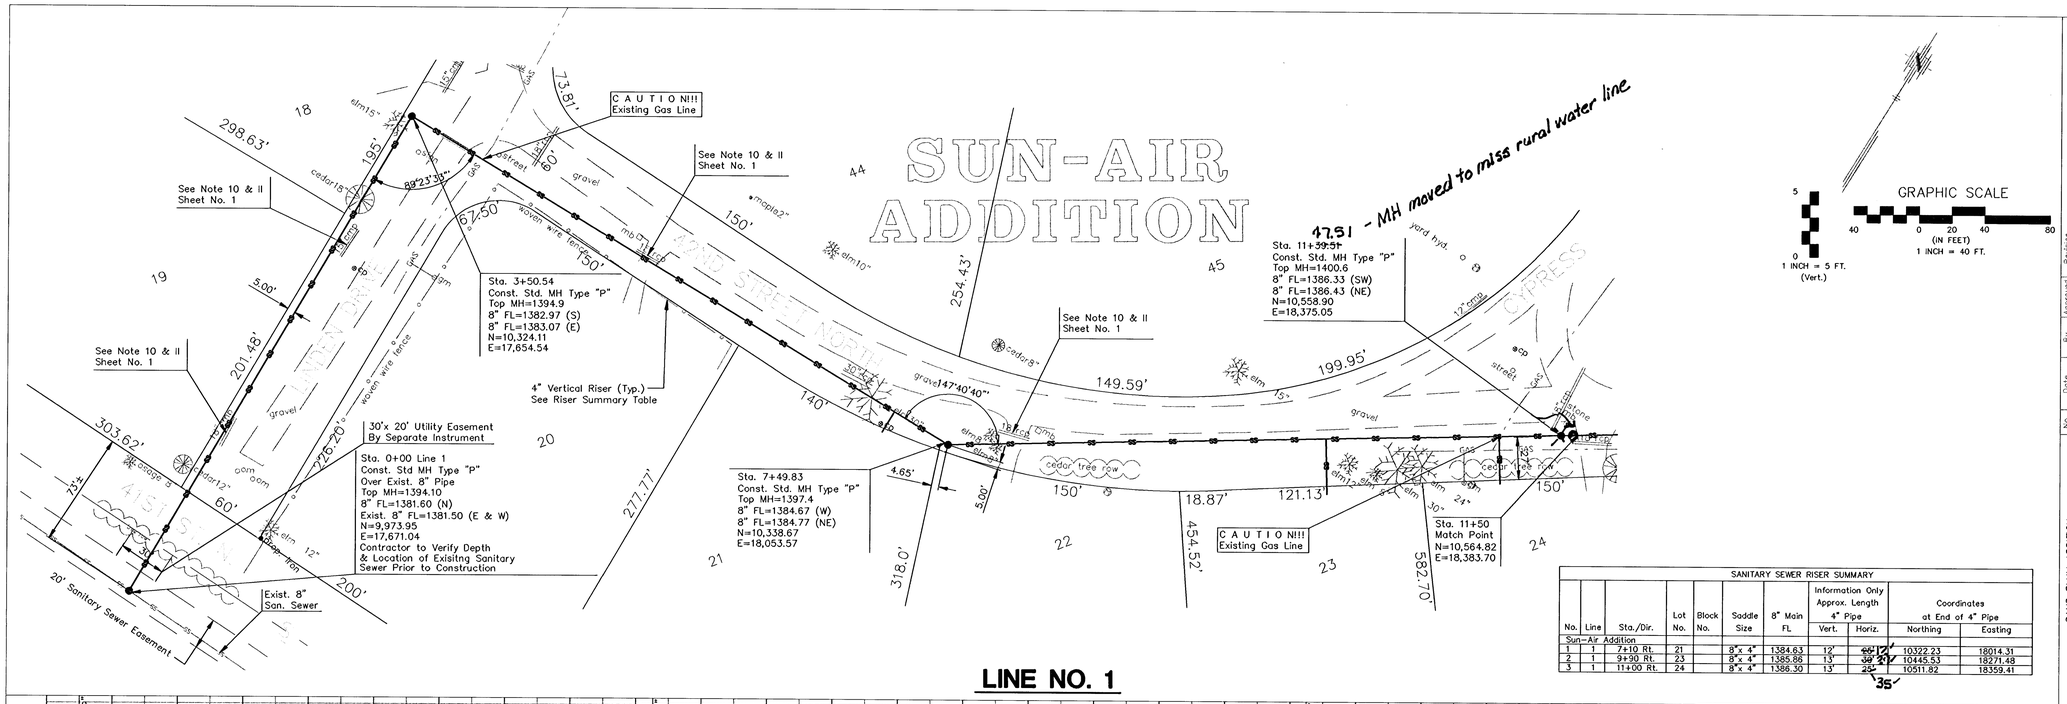

SANITARY SEWER RISER SUMMARY										
No.	Line	Sta./Dir.	Lot No.	Block No.	Saddle Size	8" Main FL	Information Only Approx. Length 4" Pipe Vert.	Horiz.	Coordinates at End of 4" Pipe Northing	Easting
Sun-Air Addition										
1	1	7+10 Rt.	21		8"x 4"	1384.63	12'	~~60'~~ 12'	10322.23	18014.31
2	1	9+90 Rt.	23		8"x 4"	1385.86	13'	~~39'~~ 20'	10445.53	18271.48
3	1	11+00 Rt.	24		8"x 4"	1386.30	13'	~~25'~~ 35'	10511.82	18359.41

LINE NO. 1

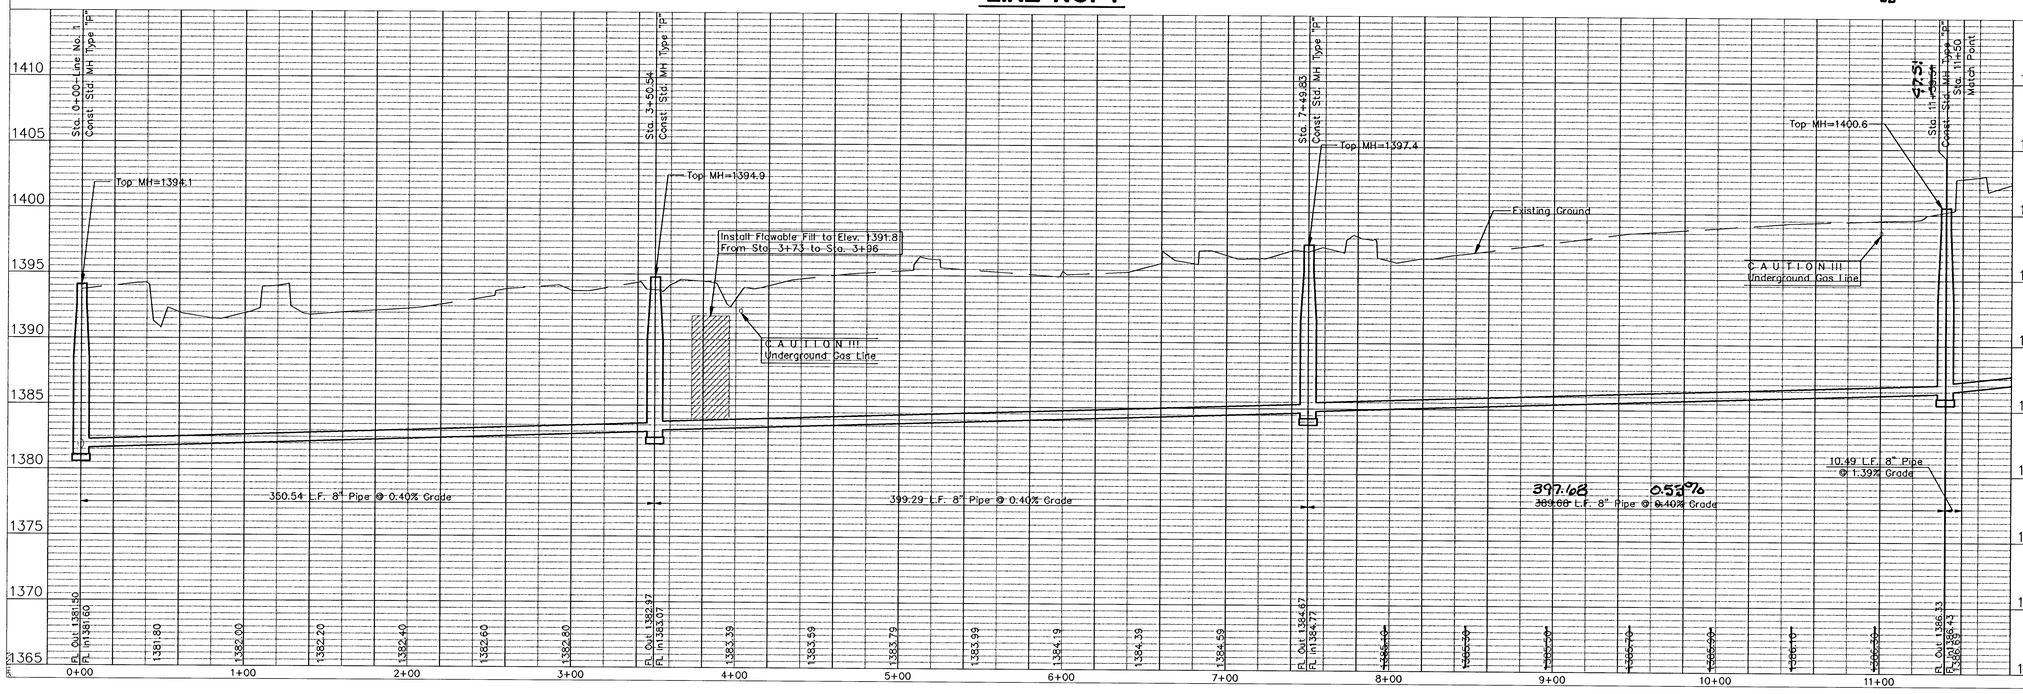

No.	Date	By	Approved	Revision

SAND PLUM ADDITION
SANITARY SEWER IMROVEMENTS
SEWER LINE NO. 1
CITY OF WICHITA, KANSAS
JAMES ARMOUR, P.E. - CITY ENGINEER
Proj# 468-83822 O.C.A.# 744073

POE & ASSOCIATES, INC.
CONSULTING ENGINEERS
3840 E. Central, Suite 200 ■ Wichita, KS 67208-4242
Phone 316/685-4114 ■ FAX 316/685-4444

FINAL

Designed By: T. Austin
Drawn By: S. Schmidt
Poe Job No.: 02153-03
Date: December 2004

Sheet 2 of 14

021\02153\02153-03\base-ss.dwg Tue Jan 04 08:03:39 2005 Steve Schmidt-Poe & Associates of Kansas, Inc.