


No.	Line	Sta./Dir.	Lot No.	Block No.	Saddle Size	8" Main FL	Information Only Approx. Length		Coordinates at End of 4" Pipe	
							Vert.	Horiz.	Northing	Eastng
4	1	12+75 Rt.	25		8" x 4"	1388.52	16'	26'	10614.84	18500.96
5	1	16+00 Lt.	26		8" x 4"	1393.12	17'	12'	10855.82	18670.81
6	1	16+50 Rt.	9		8" x 4"	1393.81	17'	10'	10905.70	18701.00
7	1	19+00 Rt.	11	2	8" x 4"	1395.65	19'	18'	11155.69	18706.88
8	1	21+28 Rt.	12	2	8" x 4"	1403.50	15'	14'	11298.67	18748.68
9	1	22+40 Rt.	13	2	8" x 4"	1403.96	18'	13'	11297.53	18683.68

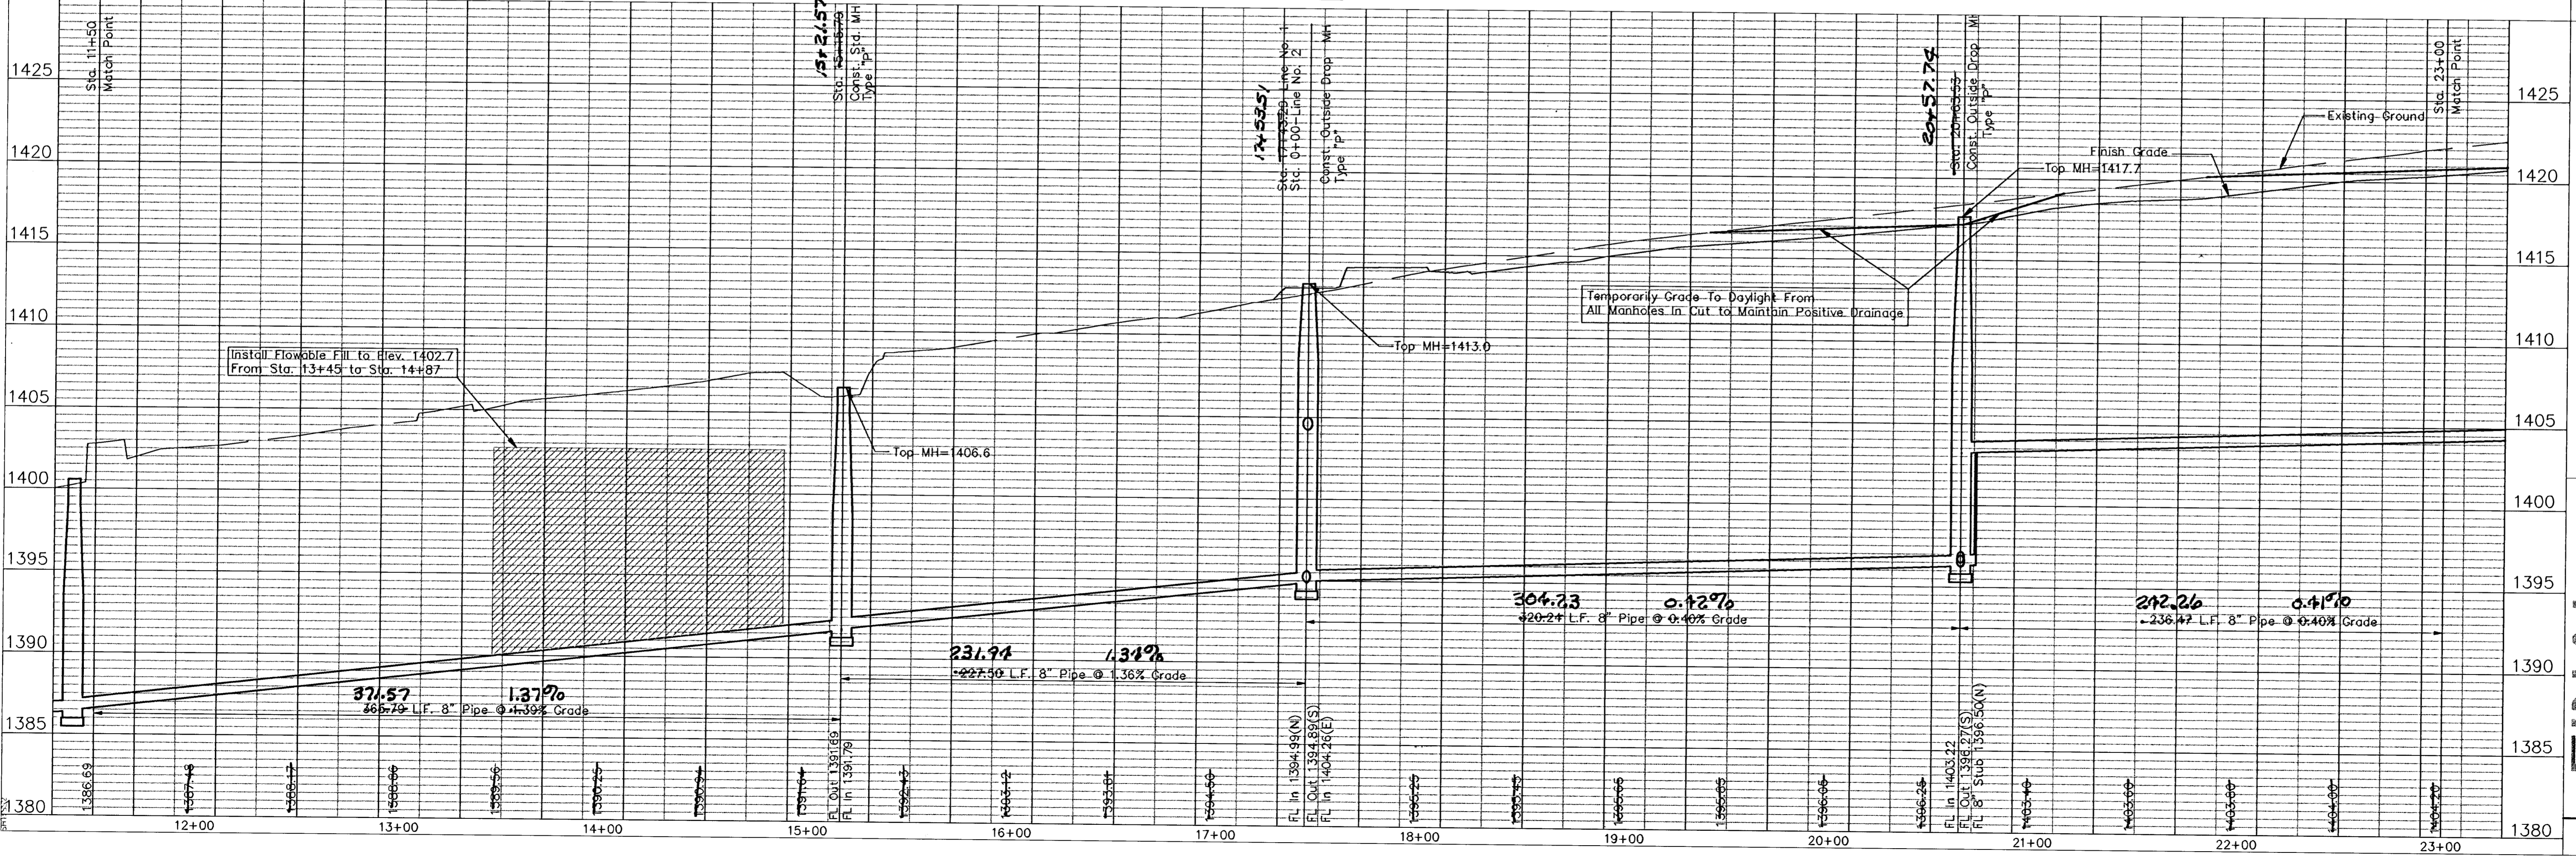

SAND PLUM ADDITION
SANITARY SEWER IMPROVEMENTS
SEWER LINE NO. 1

CITY OF WICHITA, KANSAS
JAMES ARMOUR, P.E. - CITY ENGINEER
Proj.# 468-83822 O.C.A.# 744073

POE & ASSOCIATES, INC.
CONSULTING ENGINEERS
9540 E. Central, Suite 200 • Wichita, KS 67208-4242
Phone 316-685-4114 • FAX 316-685-4444

FINAL

Designed By: T. Austin
Drawn By: S. Schmidt
Poc. Job No.: 02153-03
Date: December 2004

Sheet
3 of 14