



SANITARY SEWER RISER SUMMARY										
No.	Line	Sta./Dir.	Lot No.	Block No.	Saddle Size	8" Main FL	Information Only Approx. Length 4" Pipe		Coordinates at End of 4" Pipe	
							Vert.	Horiz.	Northing	Easting
Sand Plum Addition										
10	1	23+28 RL	15	2	8" x 4"	1404.30	16'	13' 20"	11296.69	18948.67
11	1	24+00 RL	15	2	8" x 4"	1404.90	16'	13' 20"	11295.45	19073.67
12	1	25+00 RL	16	2	8" x 4"	1405.30	17'	13' 20"	11294.46	19137.66
13	1	26+00 RL	17	2	8" x 4"	1405.70	13'	13' 20"	11293.47	19273.66
14	1	27+00 RL	18	2	8" x 4"	1406.20	15'	13' 20"	11292.47	19353.66
15	1	29+00 RL	2	1	8" x 4"	1406.80	12'	13' 20"	11290.99	19523.65

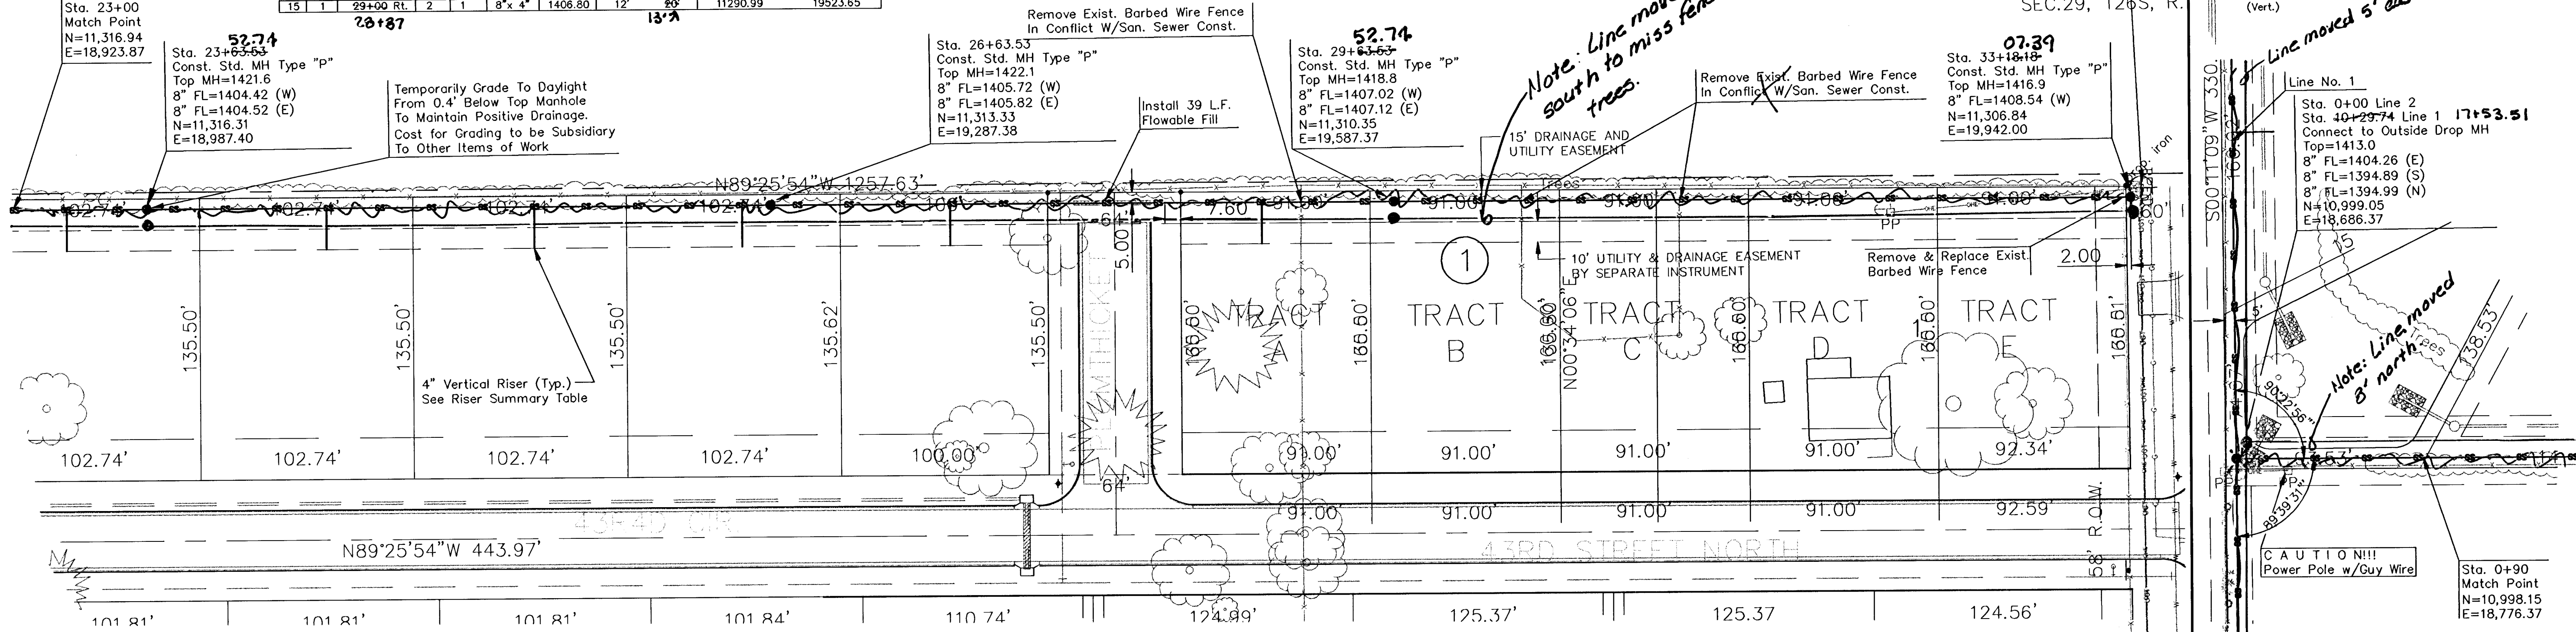

LINE NO. 1

LINE NO. 2

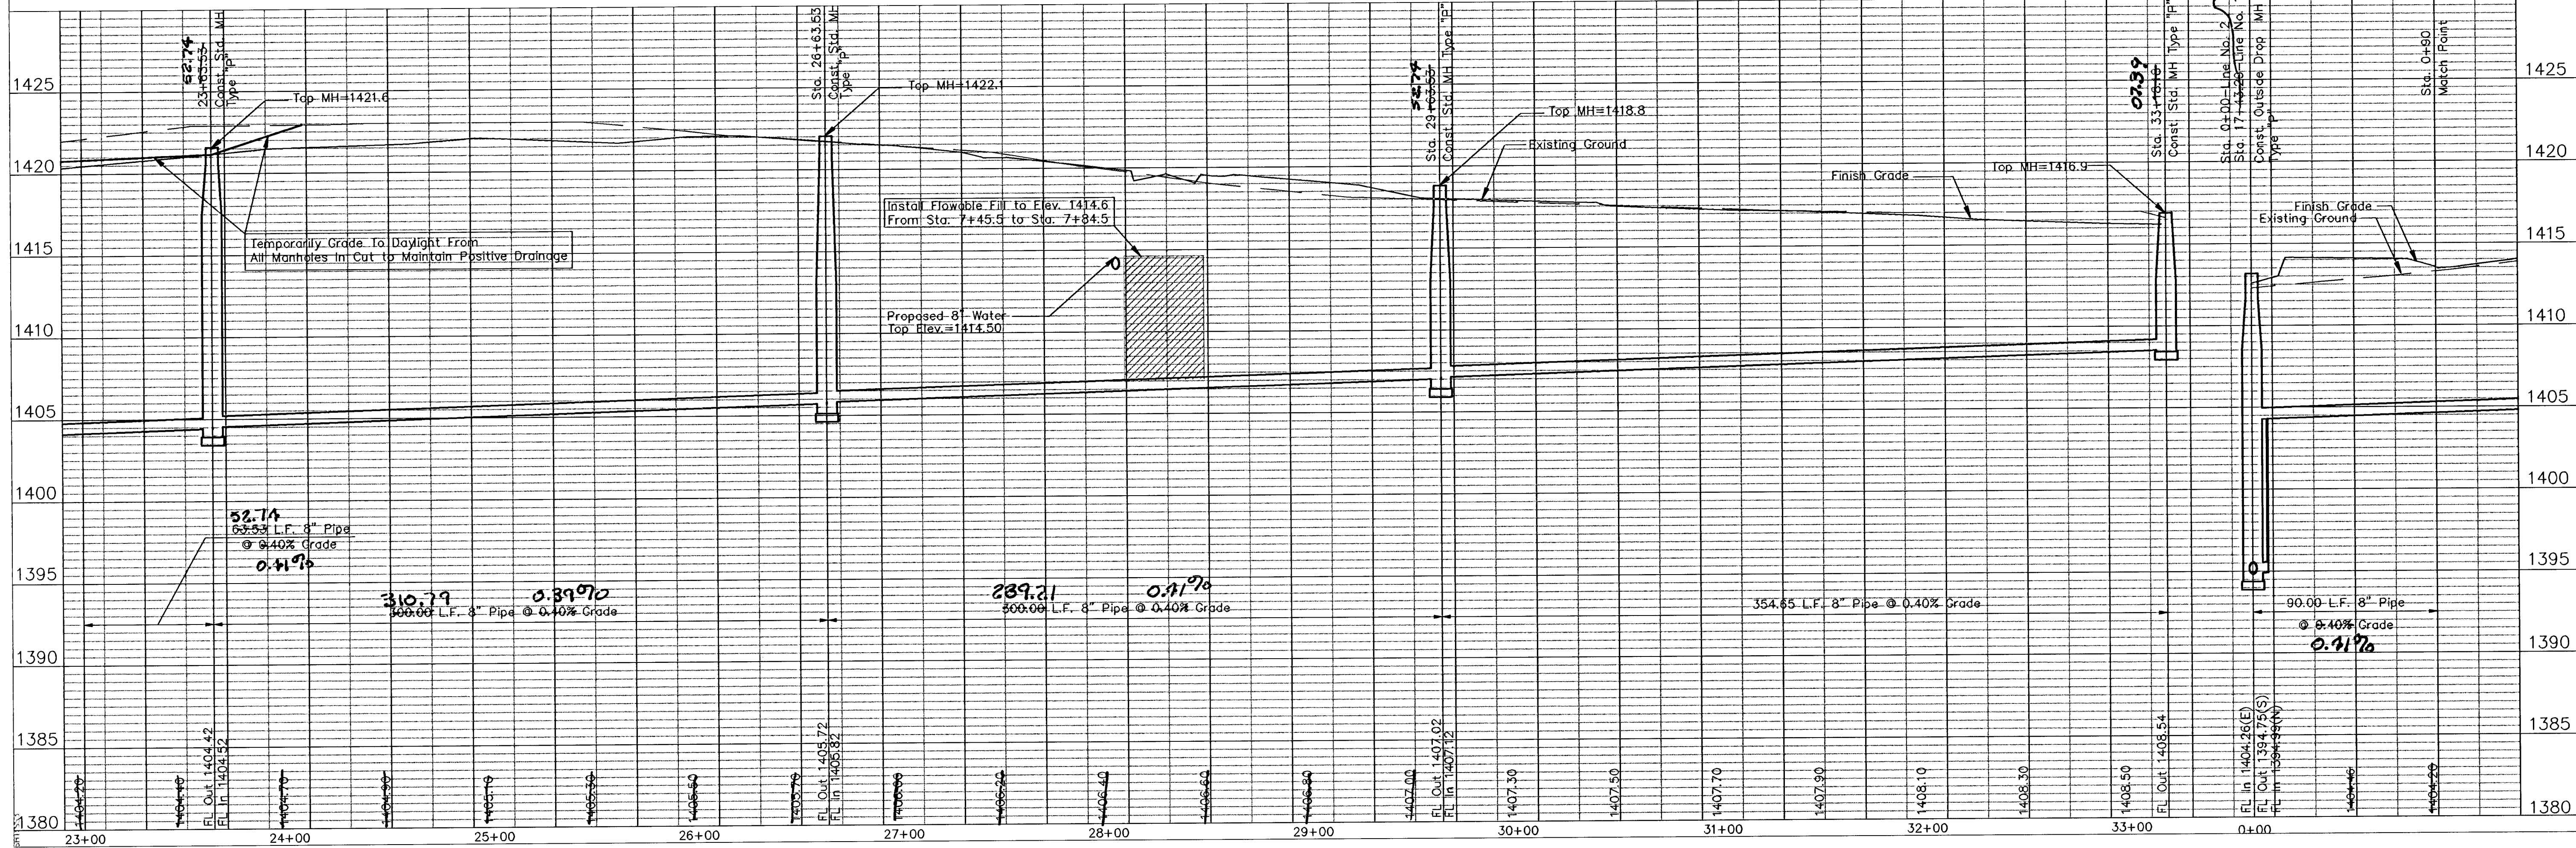

POE & ASSOCIATES, INC.
CONSULTING ENGINEERS
5940 E. Central, Suite 200 • Wichita, KS 67208-4242
Phone 316/685-4114 • FAX 316/685-4444

FINAL

Designed By: T. Austin
Drawn By: S. Schmidt
Poe Job No.: 02153-03
Date: December 2004

Sheet
4 of 14