



SANITARY SEWER RISER SUMMARY										
No.	Line	Sta./Dir	Lot No.	Block No.	Saddle Size	8" Main FL	Information Only Approx. Length 4" Pipe		Coordinates at End of 4" Pipe	
							Vert.	Horiz.	Northing	Easting
16	2	4+40.00	8	2	8" x 4"	1405.96	14'	0"	11015.08	19086.55
17	2	4+85.00	7	2	8" x 4"	1406.31	15'	0"	11014.24	19171.55
18	2	5+80.00	6	2	8" x 4"	1406.69	15'	0"	11013.29	19266.54
19	2	5+95.00	5	2	8" x 4"	1407.26	15'	0"	11012.10	19366.54
20	2	6+10.00	4	2	8" x 4"	1407.70	13'	0"	11011.01	19466.53

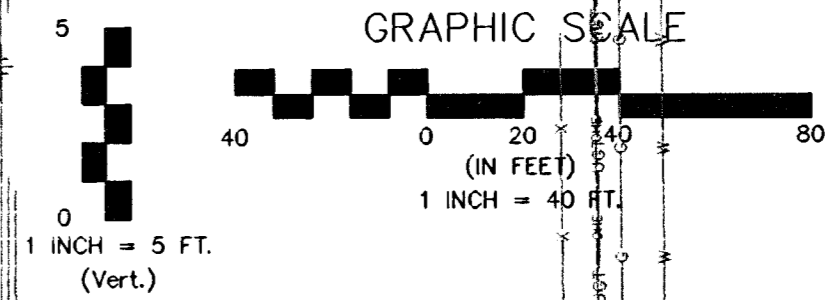


LINE NO. 2

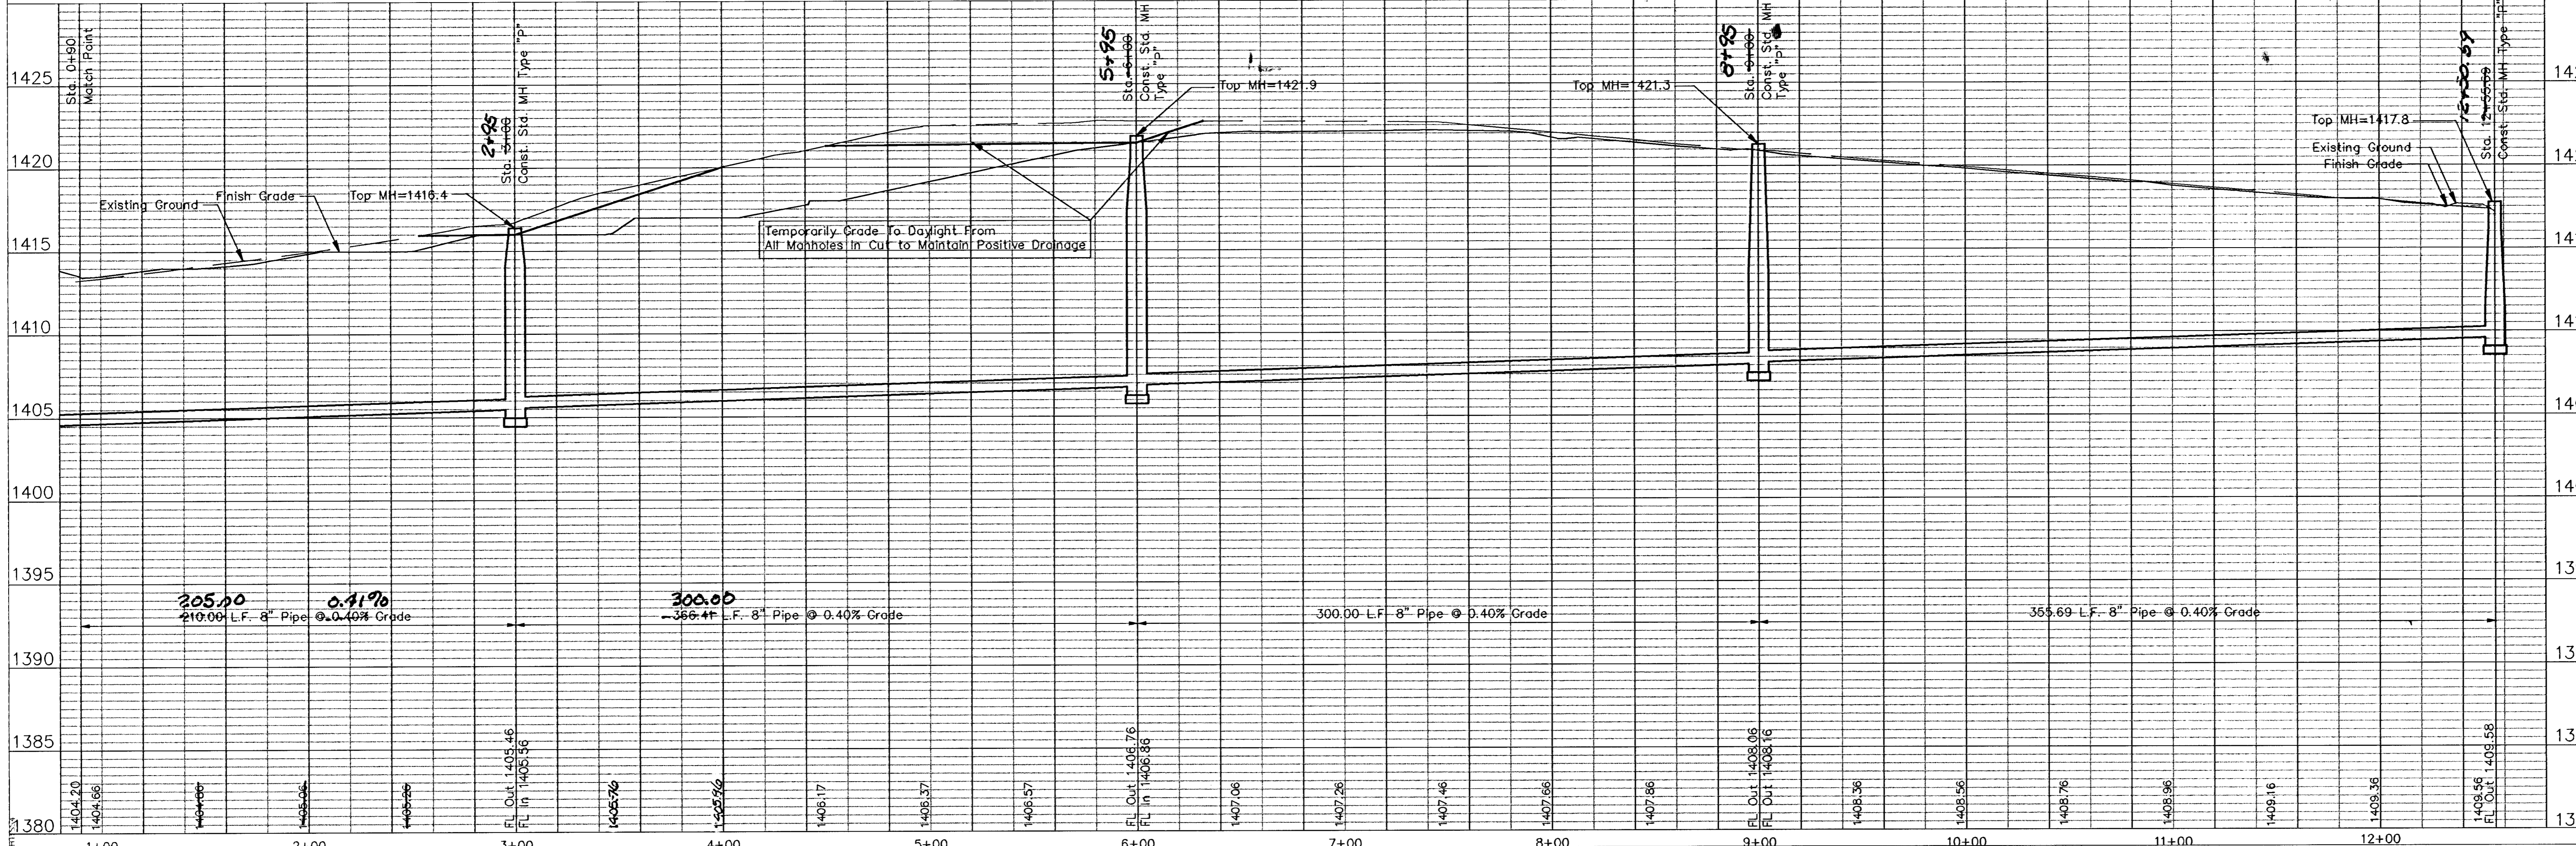

No. _____ Date _____ By _____ Approval _____
 SAND PLUM ADDITION
 SANITARY SEWER IMPROVEMENTS
 SEMER LINE NO. 2
 CITY OF WICHITA, KANSAS
 JAMES ARMOUR, P.E. - CITY ENGINEER
 Proj.# 468-83822 O.C.# 74073

POE & ASSOCIATES, INC.
 CONSULTING ENGINEERS
 5840 E. Central, Suite 200 • Wichita, KS 67208-4242
 Phone 316-858-4114 • FAX 316-858-4444

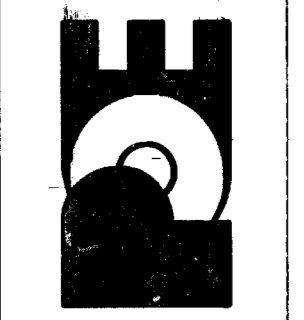

FINAL
 Designed By: T. Austin
 Drawn By: S. Schmidt
 P.O. Job No.: 021531-03
 Date: December 2004
 Sheet 5 of 14