
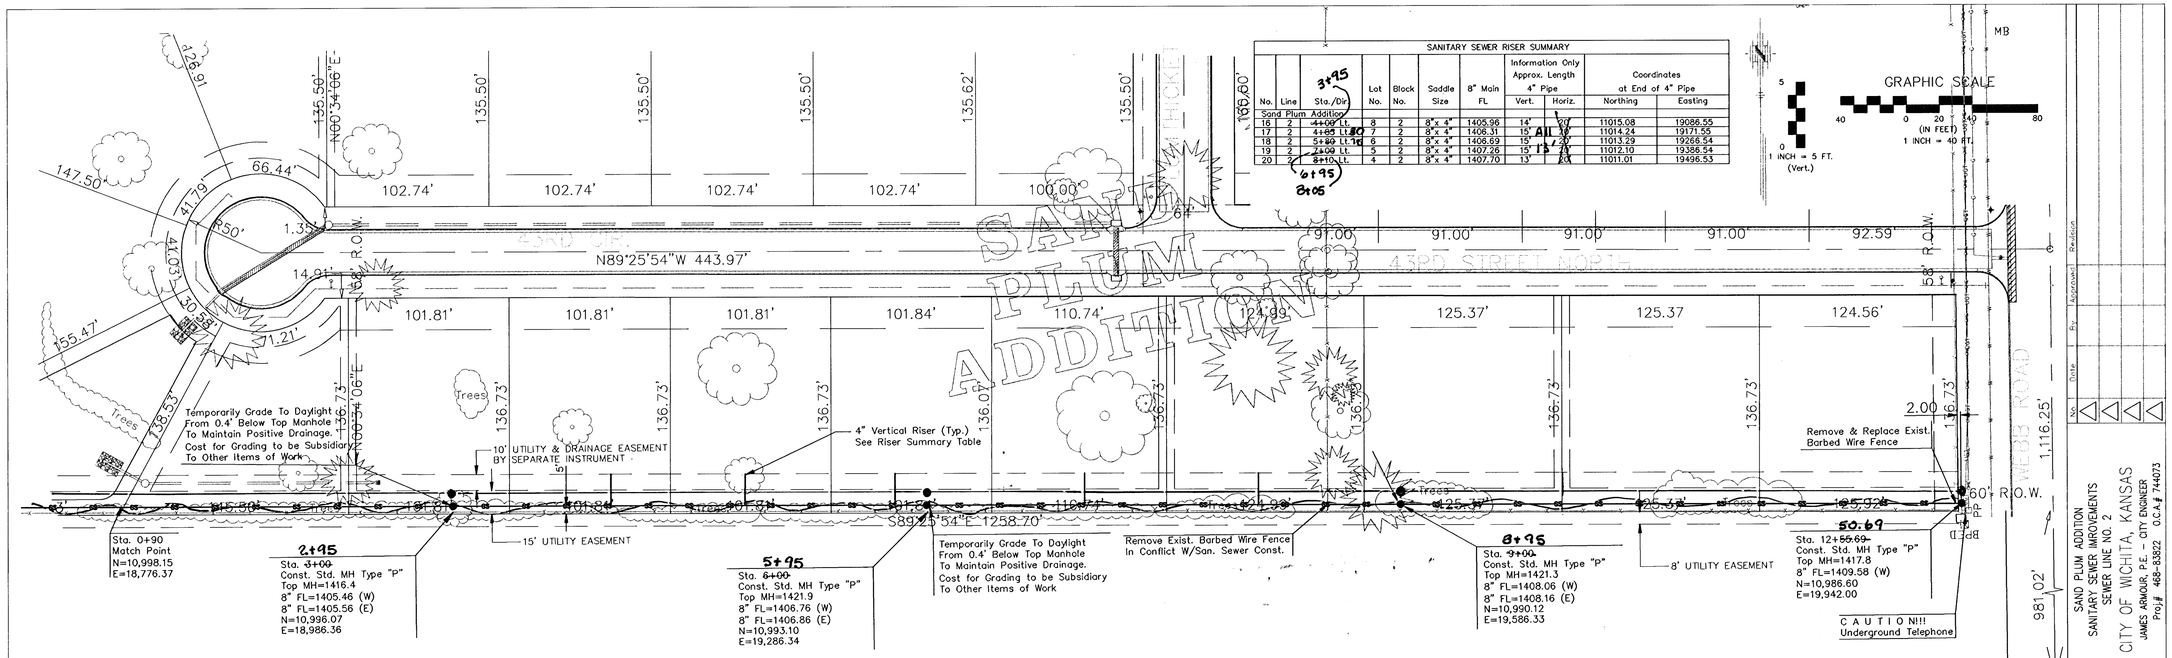


LINE NO. 2

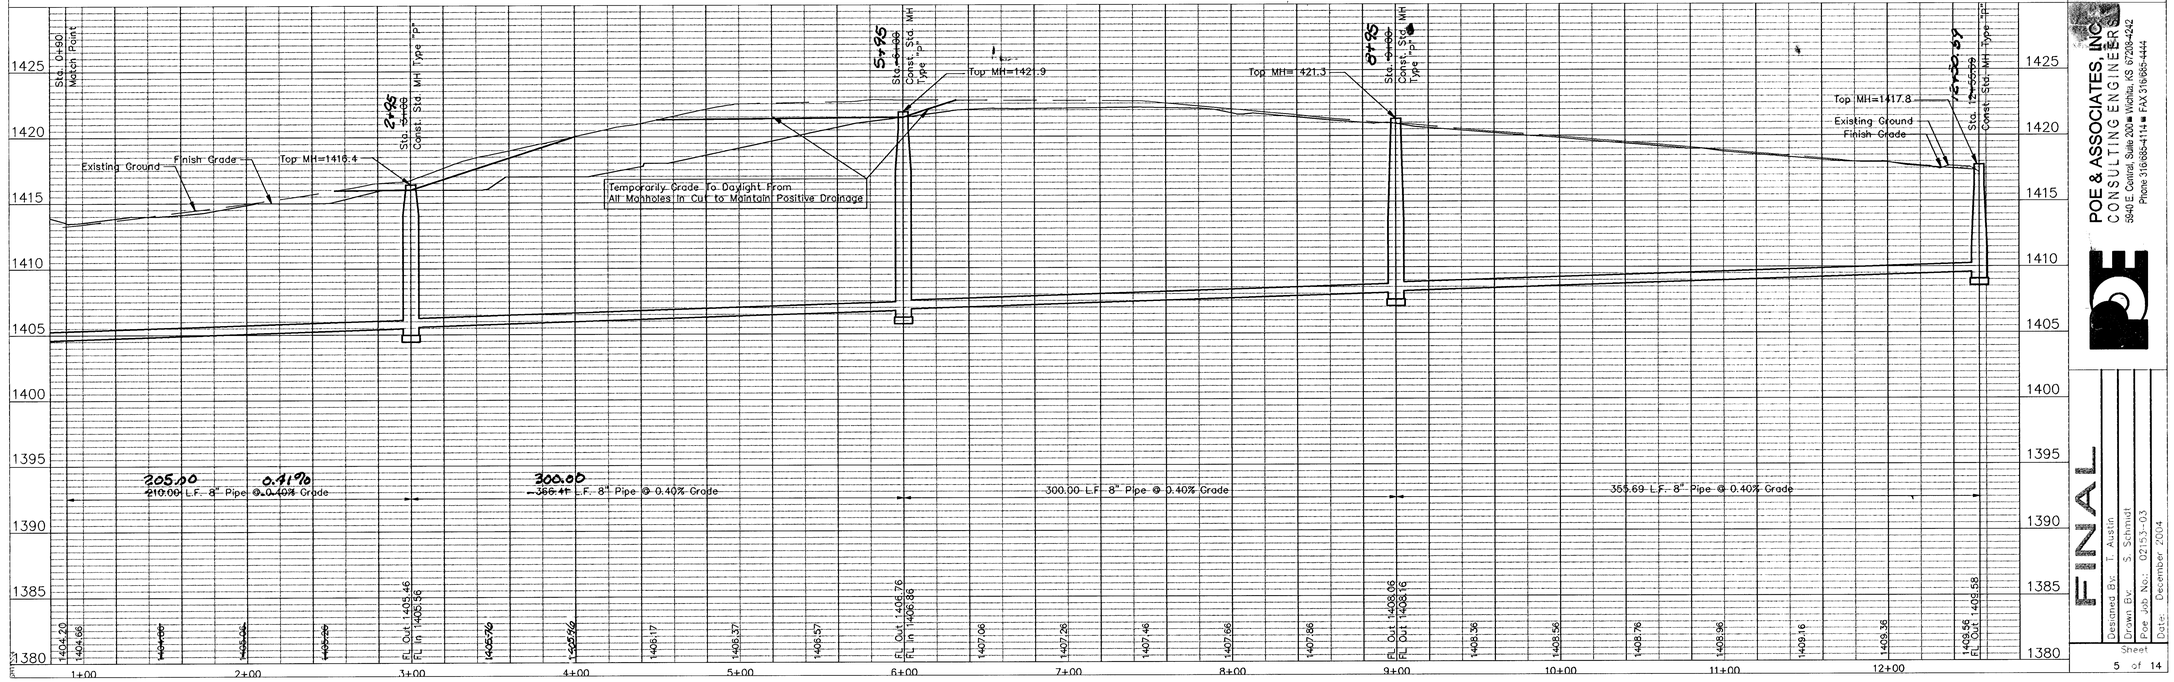

POE & ASSOCIATES, INC.
CONSULTING ENGINEERS
3840 E. Central, Suite 200 ■ Wichita, KS 67208-4242
Phone 316/685-4114 ■ FAX 316/685-4444

FINAL
Designed By: T. Austin
Drawn By: S. Schmidt
Poe Job No.: 02153-03
Date: December 2004
Sheet 5 of 14

I:\2021\02153\02153-03\base-ss.dwg Tue Jan 04 08:03:50 2005 Steve Schmidt-Poe & Associates of Kansas, Inc.