


RIGHT-OF-WAY VACATION EXHIBIT



SAND PLUM ADDITION

WICHITA, SEDGWICK COUNTY, KANSAS

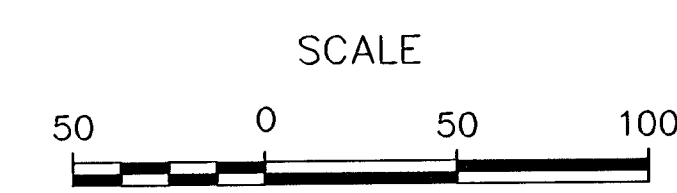

LEGEND

- = Right-of-Way to be Vacated
- = Proposed Right-of-Way

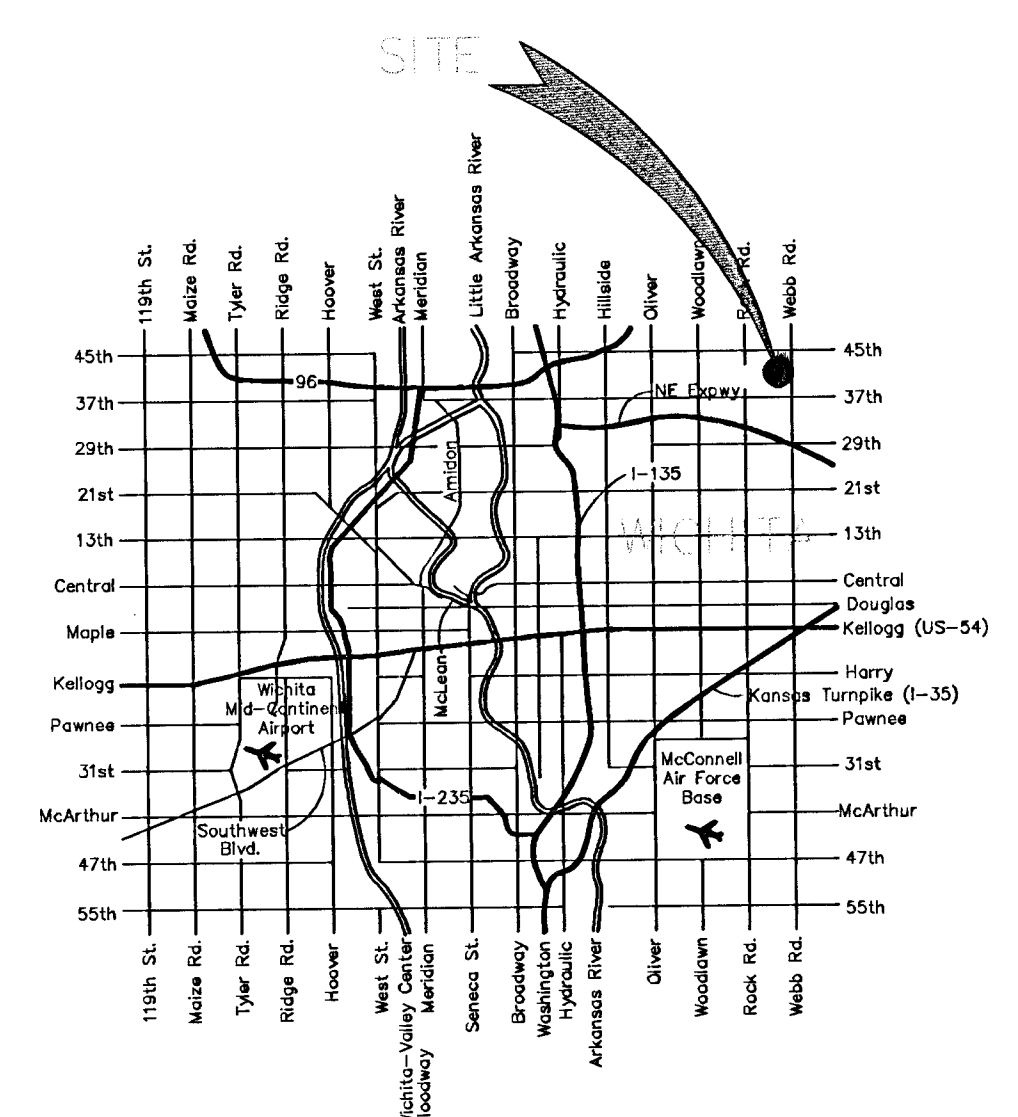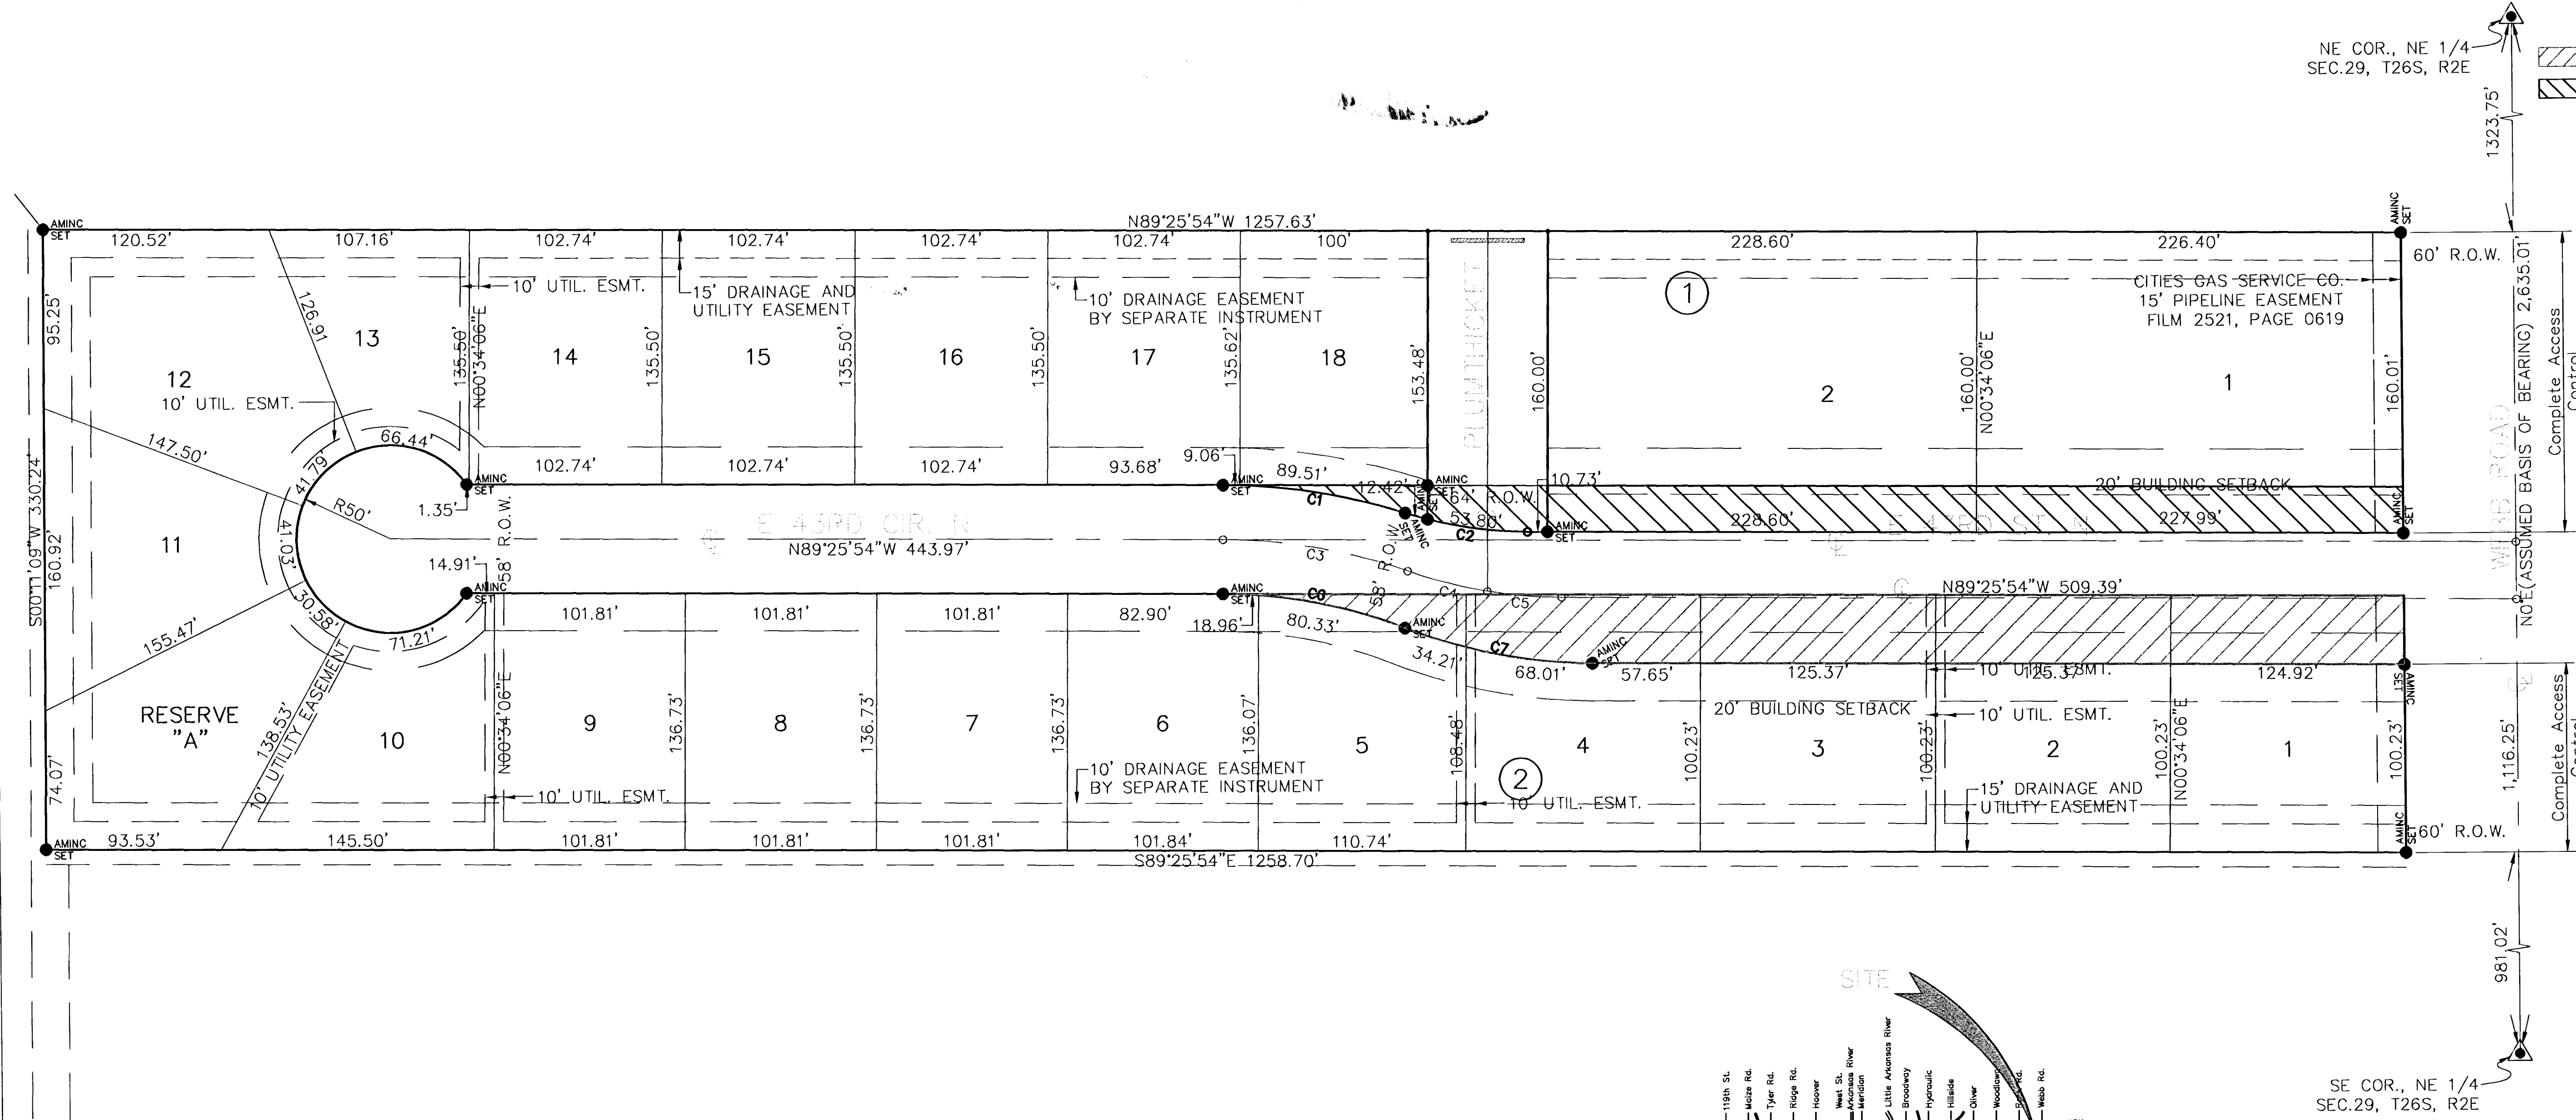

VICINITY MAP

FINAL	
Designed By: T. Austin	
Drawn By: S. Schmidt	
Poe Job No.: 02153-03	
Date: December 2004	
POE & ASSOCIATES, INC. CONSULTING ENGINEERS 5840 E. Central, Suite 200 • Wichita, KS 67208-4242 Phone 316/685-4114 • FAX 316/685-4444	
SAND PLUM ADDITION SANITARY SEWER IMPROVEMENTS VACATION EXHIBIT CITY OF WICHITA, KANSAS JAMES ARMOUR, P.E. - CITY ENGINEER Proj.# 468-83822 O.C.A.# 744073	
No.	1
Date	
By	
Approved	
Revision	

02102153 02153-03 ss-vacate.dwg Tue Jan 04 08:08:16 2005 Steve Schmidt-Poe & Associates of Kansas, Inc.