


SEWER SERVICE TABLE

NUMBER	TYPE	LOCATION			STATION\ DIRECTION	FOR INFORMATION ONLY	
		LOT NO.	BLOCK NO.	LINE NO.		APPROXIMATE LENGTH 4" PIPE	
						VERTICAL	HORIZONTAL
1	8" x 4" Tee Saddle	8	D	1	0+20/Lt. 94	17'	18' 11"
2	8" x 4" Tee Saddle	7	D	1	1+03/Lt. 69.3	17'	18' 16.4'
3	8" x 4" Tee Saddle	8	D	1	2+41/Lt. 51.3	17'	15'
4	8" x 4" Tee Saddle	5	D	1	3+12/Lt. 14.7	18'	19'
5	8" x 4" Tee Saddle	4	D	1	3+26/Lt. 97.3	18'	23'
6	8" x 4" Tee Saddle	3	D	1	4+71/Lt. 78.2	15'	18' 17'
7	8" x 4" Tee Saddle	2	D	1	5+12/Lt. 46.2	15'	18' 16'
8	8" x 4" Tee Saddle	1	D	1	6+18/Lt. 19.4	15'	18' 16.3'
9	8" x 4" Tee Saddle	12	B	1	11+43/Rt. 40.3	11'	14' 13.5'
10	8" x 4" Tee Saddle	11	B	1	12+19/Rt. 15.9	11'	10' 9.6'
11	8" x 4" Tee Saddle	10	B	1	12+07/Rt. 41.0	10'	8' 5.5'
12	8" x 4" Tee Saddle	9	B	1	13+70/Rt. 70.8	8'	8' 16'
13	8" x 4" Tee Saddle	5	B	1	18+84/Rt. 83.5	9'	4' 5'
14	8" x 4" Tee Saddle	4	B	1	17+53/Rt. 53.9	9'	8' 7'
15	8" x 4" Tee Saddle	11	E	2	1+30/Lt. 28.9	11'	10' 11.3'
16	8" x 4" Tee Saddle	10	E	2	2+08/Lt. 10.9	10'	10' 11.9'
17	8" x 4" Tee Saddle	9	E	2	2+88/Lt. 83.6	10'	10' 9.7'
18	8" x 4" Tee Saddle	8	E	2	3+61/Lt. 63.1	10'	10' 10.8'
19	8" x 4" Tee Saddle	7	E	2	4+36/Lt. 31.5	10'	10' 9.6'
20	8" x 4" Tee Saddle	13	A	3	1+81/Rt. 81.2	8'	18' 14'
21	8" x 4" Tee Saddle	12	A	3	2+24/Rt. 22.2	8'	18' 14'
22	8" x 4" Tee Saddle	11	A	3	3+05/Rt. 03.3	6'	18' 14'
23	8" x 4" Tee Saddle	10	A	3	4+04/Rt. 01.3	6'	15'
24	8" x 4" Tee Saddle	5	A	4	1+13/Rt. 10.1	6'	18' 11.0'
25	8" x 4" Tee Saddle	4	A	4	2+58/Rt. 61.1	6'	15'
26	8" x 4" Tee Saddle	3	A	4	4+00/Rt. 00.1	5'	15'
27	8" x 4" Tee Saddle	9	C	5	0+28/Lt. 27.3	11'	18' 14.8'
28	8" x 4" Tee Saddle	1	C	5	0+40/Rt. 32.4	10'	8' 7.4'
29	8" x 4" Tee Saddle	13	B	6	0+14/Lt. 22.0	10'	18' 16'
30	8" x 4" Tee Saddle	14	B	6	0+86/Lt. 90.2	10'	18' 19'
31	8" x 4" Tee Saddle	8	B	1	14+22/Rt. 22.3	10'	8' 6'
32	8" x 4" Tee Saddle	7	B	1	13+38/Rt. 32.3	10'	8' 6'
33	8" x 4" Tee Saddle	6	B	1	16+03/Rt. 03.3	10'	8' 6'
34	4" Riser Assy.	3	B	1	18+13.37/Rt. 13.2	10'	8' 6' (NE)
35	8" x 4" Tee Saddle	2	B	1	19+32/Rt. 31.1	9'	28' 26'
36	8" x 4" Tee Saddle	1	B	1	20+34/Rt. 34.7	9'	18' 15'

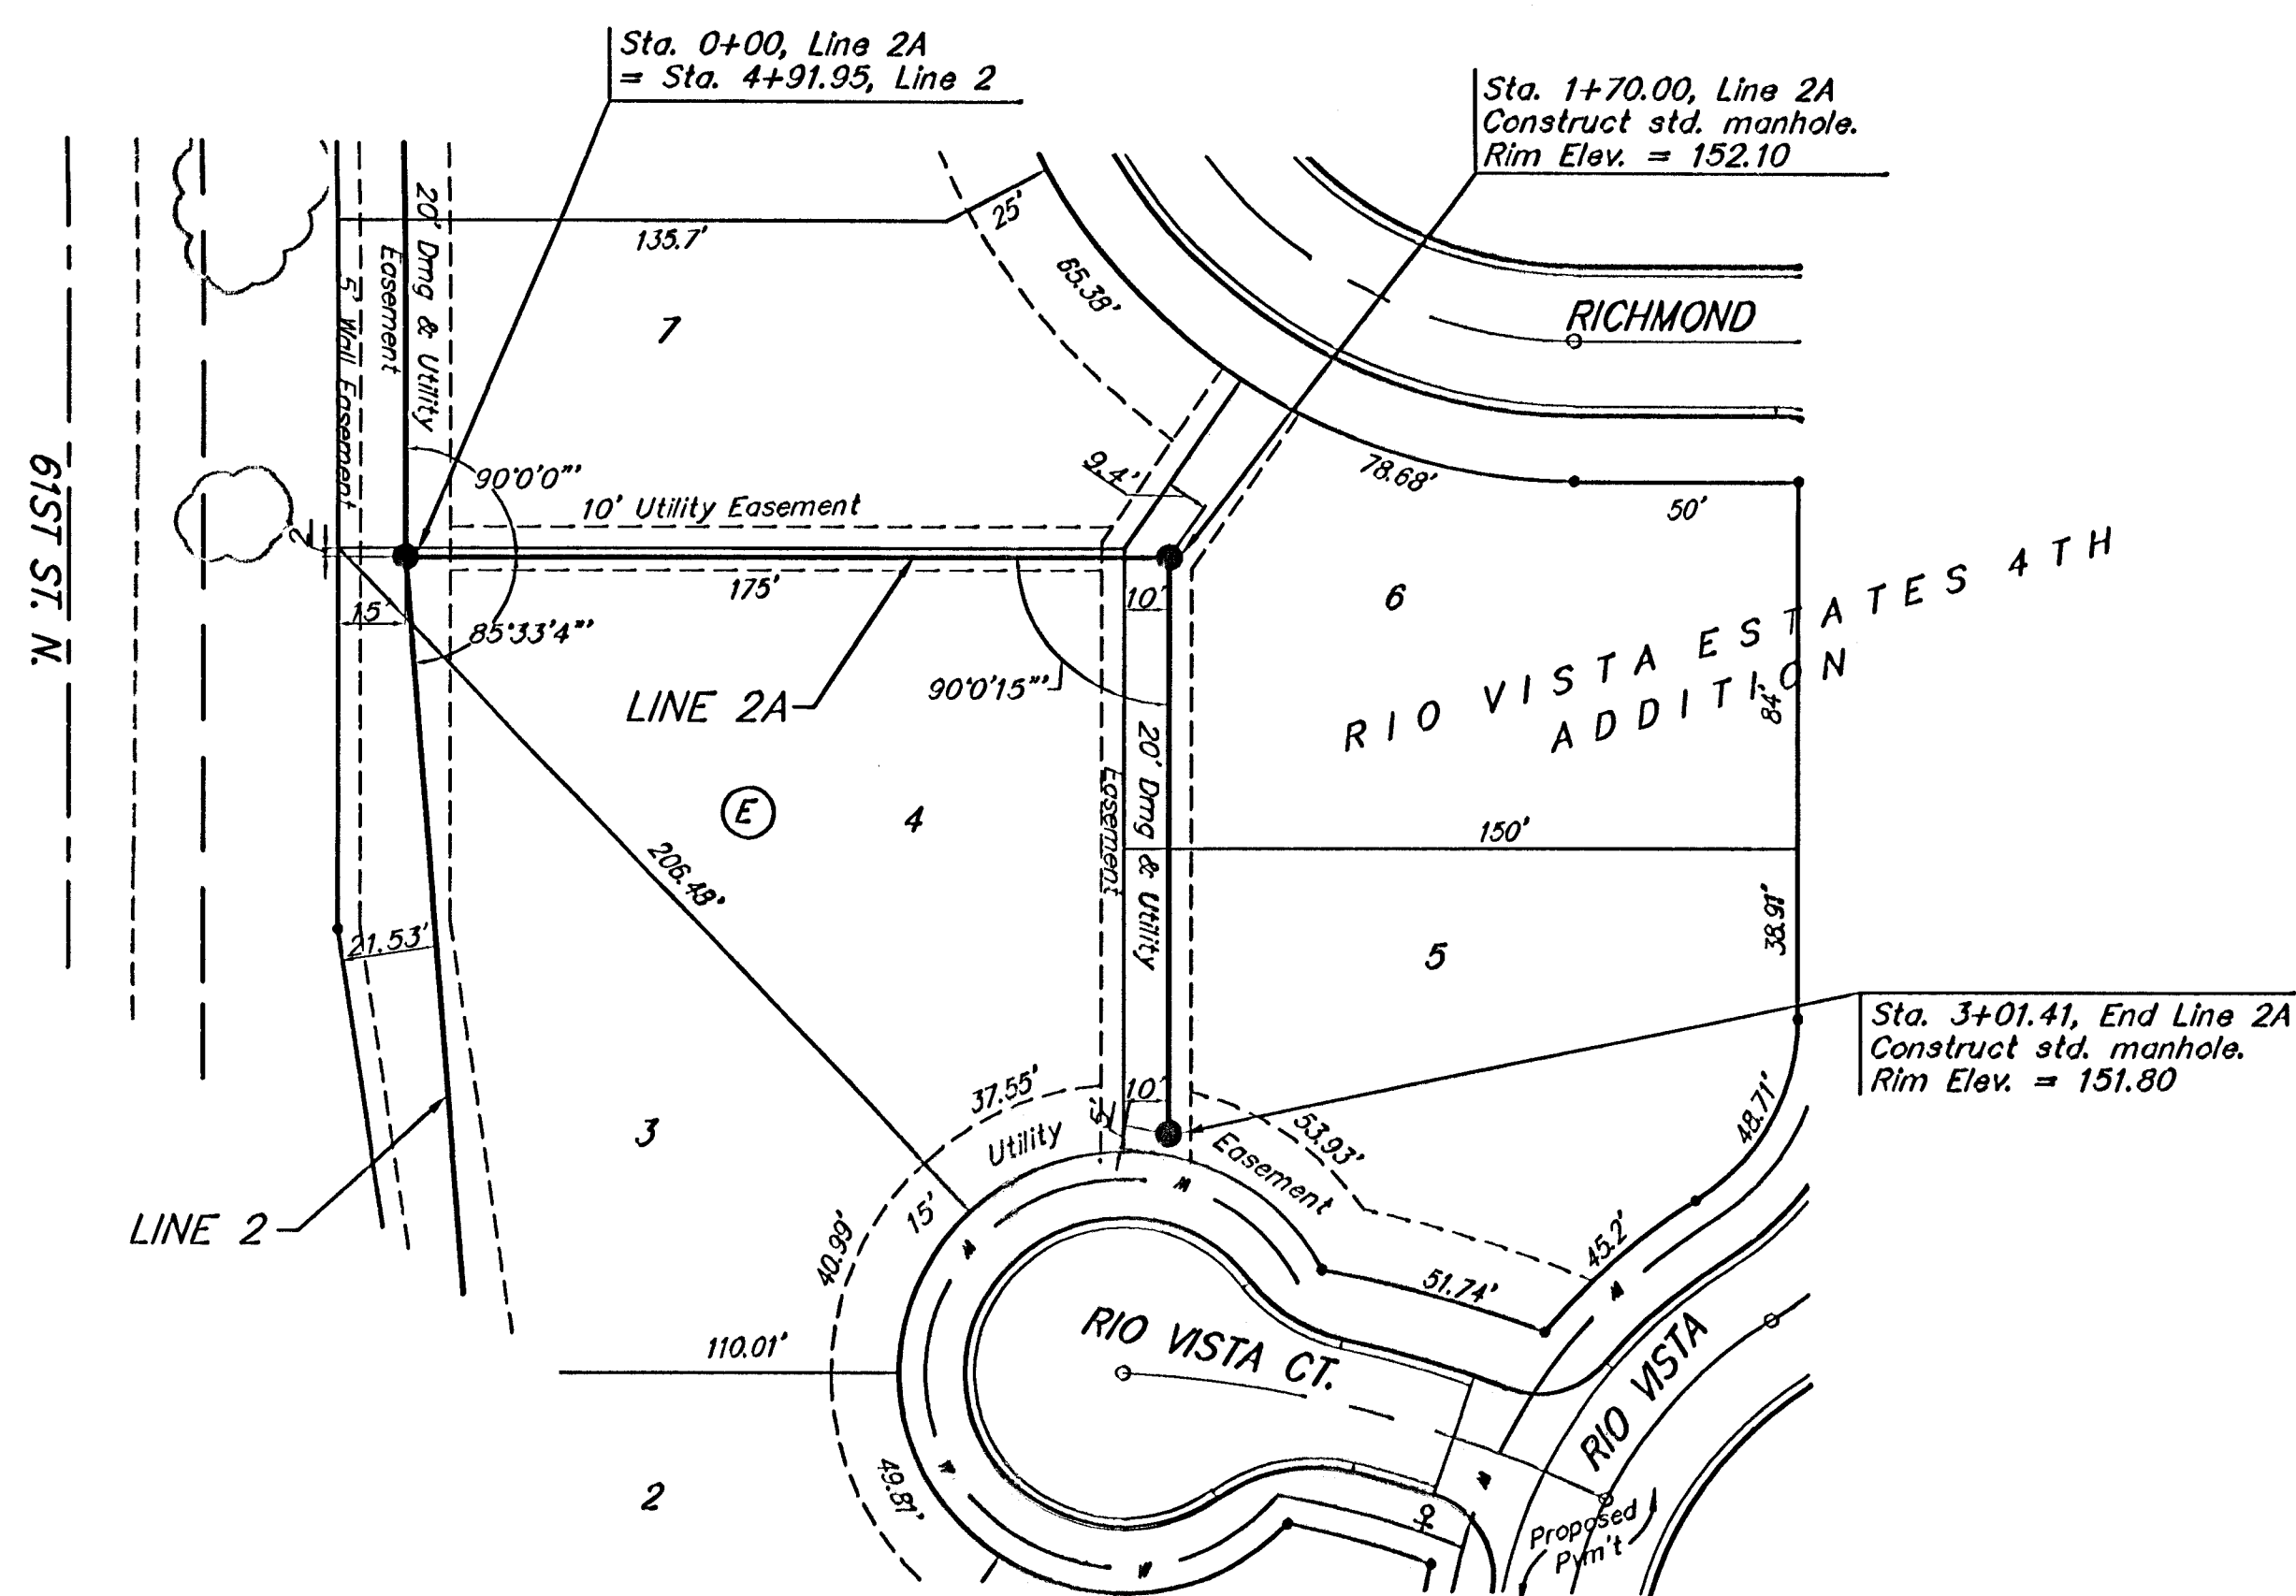

Scale: 1" = 40' Horizontal
1" = 5' Vertical
• = Iron


BENCHMARK:
R.R. SPIKE IN HLP, 150' E. & 30'
S. OF THE S.W. COR., S.E. 1/4,
SEC. 12-26-11W.
ELEV. = 1338.98 M.S.L.
ELEV. = 151.58 City Datum

"0" IN OPEN, TOP FLANGE OF
FIRE HYDRANT AT THE S.W.
CORNER OF 61ST ST. N. &
MERIDIAN AVE.
ELEV. = 1339.16 M.S.L.
ELEV. = 151.78 City Datum

Denotes Trees to be
Removed by the
Sanitary Sewer Contractor

SEWER SERVICE TABLE - See Sheet 6

NOTE: Vertical Riser Pipe shall be extended to 2' minimum above
ground water elevation and 4' maximum below proposed ground
elevation.

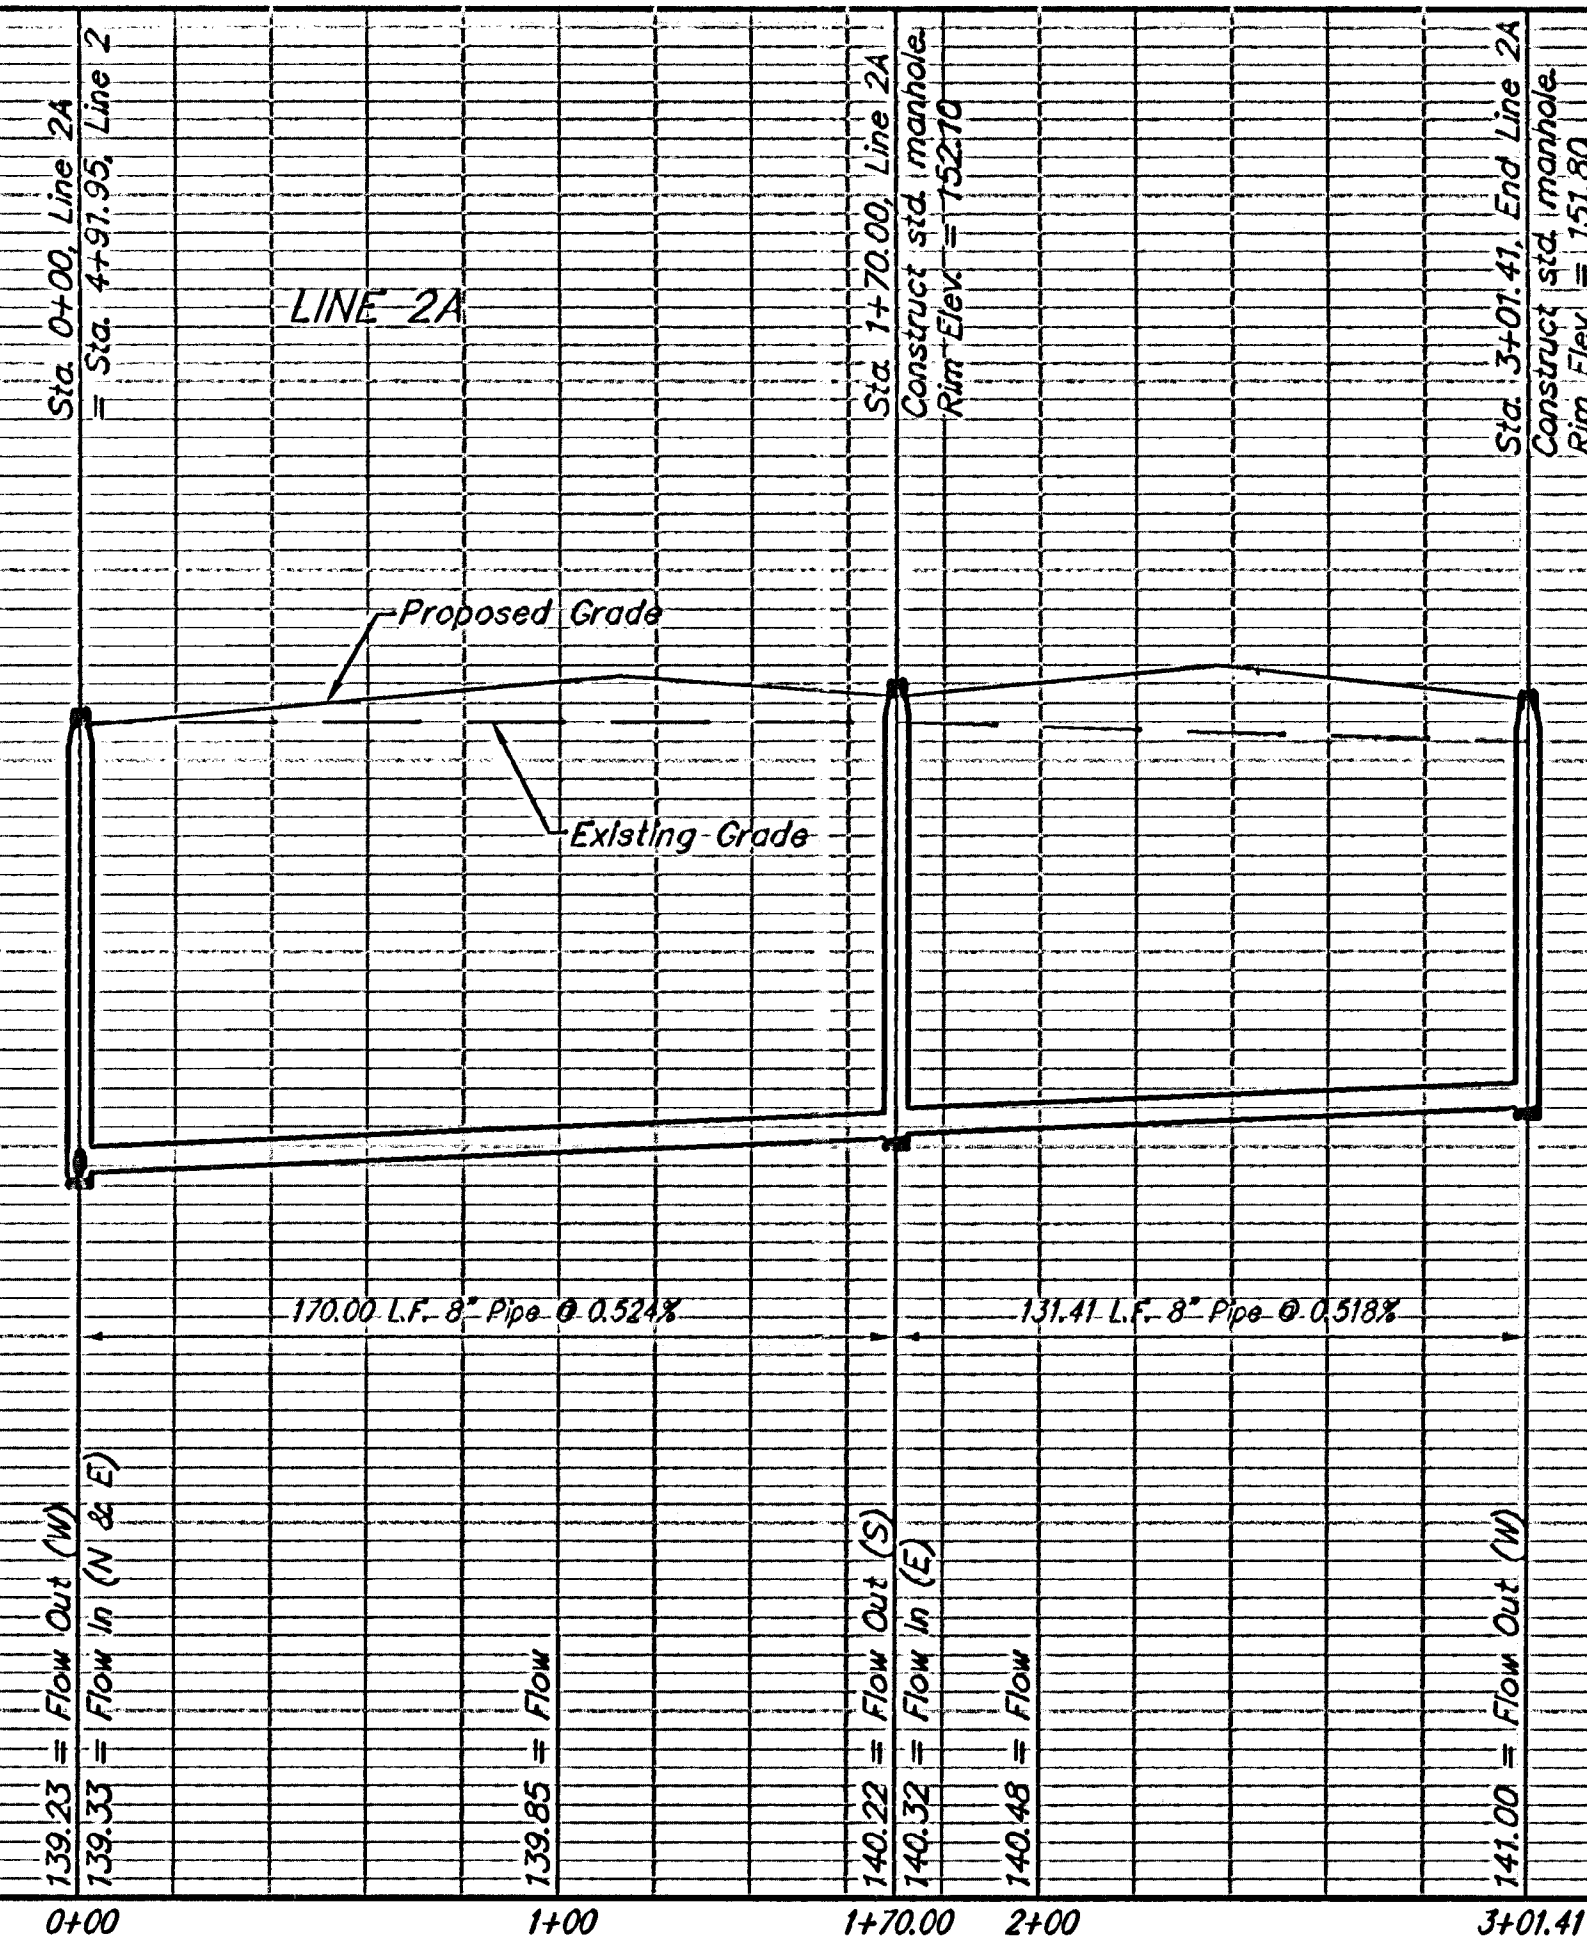

Baughman		Rio Vista Estates 4th Addition	
Line 2A		Sanitary Sewer Improvements	
Baughman Company, P.A. 315 E. 11th St., Wichita, KS 67211 P316-262-7771 F316-262-0149		ENGINEERING SURVEYING PLANNING LANDSCAPE ARCHITECTURE	
PROJECT NUMBER 468-81842	DESIGN MVS	DRAWN MVS	DATE 06/05
REVISIONS	APPROVED	SCALE Noted	SHEET 6 OF 19

F:\eng\Rio Vista\ss.dwg

05-03-B202