


BENCHMARK:
R.R. SPIKE IN HLP, 150' E. & 30'
S. OF THE S.W. COR., S.E. 1/4,
SEC. 12-26-1W.
ELEV. = 1338.96 M.S.L.
ELEV. = 151.56 City Datum

"0" IN OPEN, TOP FLANGE OF
FIRE HYDRANT AT THE S.W.
CORNER OF 61ST. ST. N. &
MERIDIAN AVE.
ELEV. = 1339.16 M.S.L.
ELEV. = 151.76 City Datum

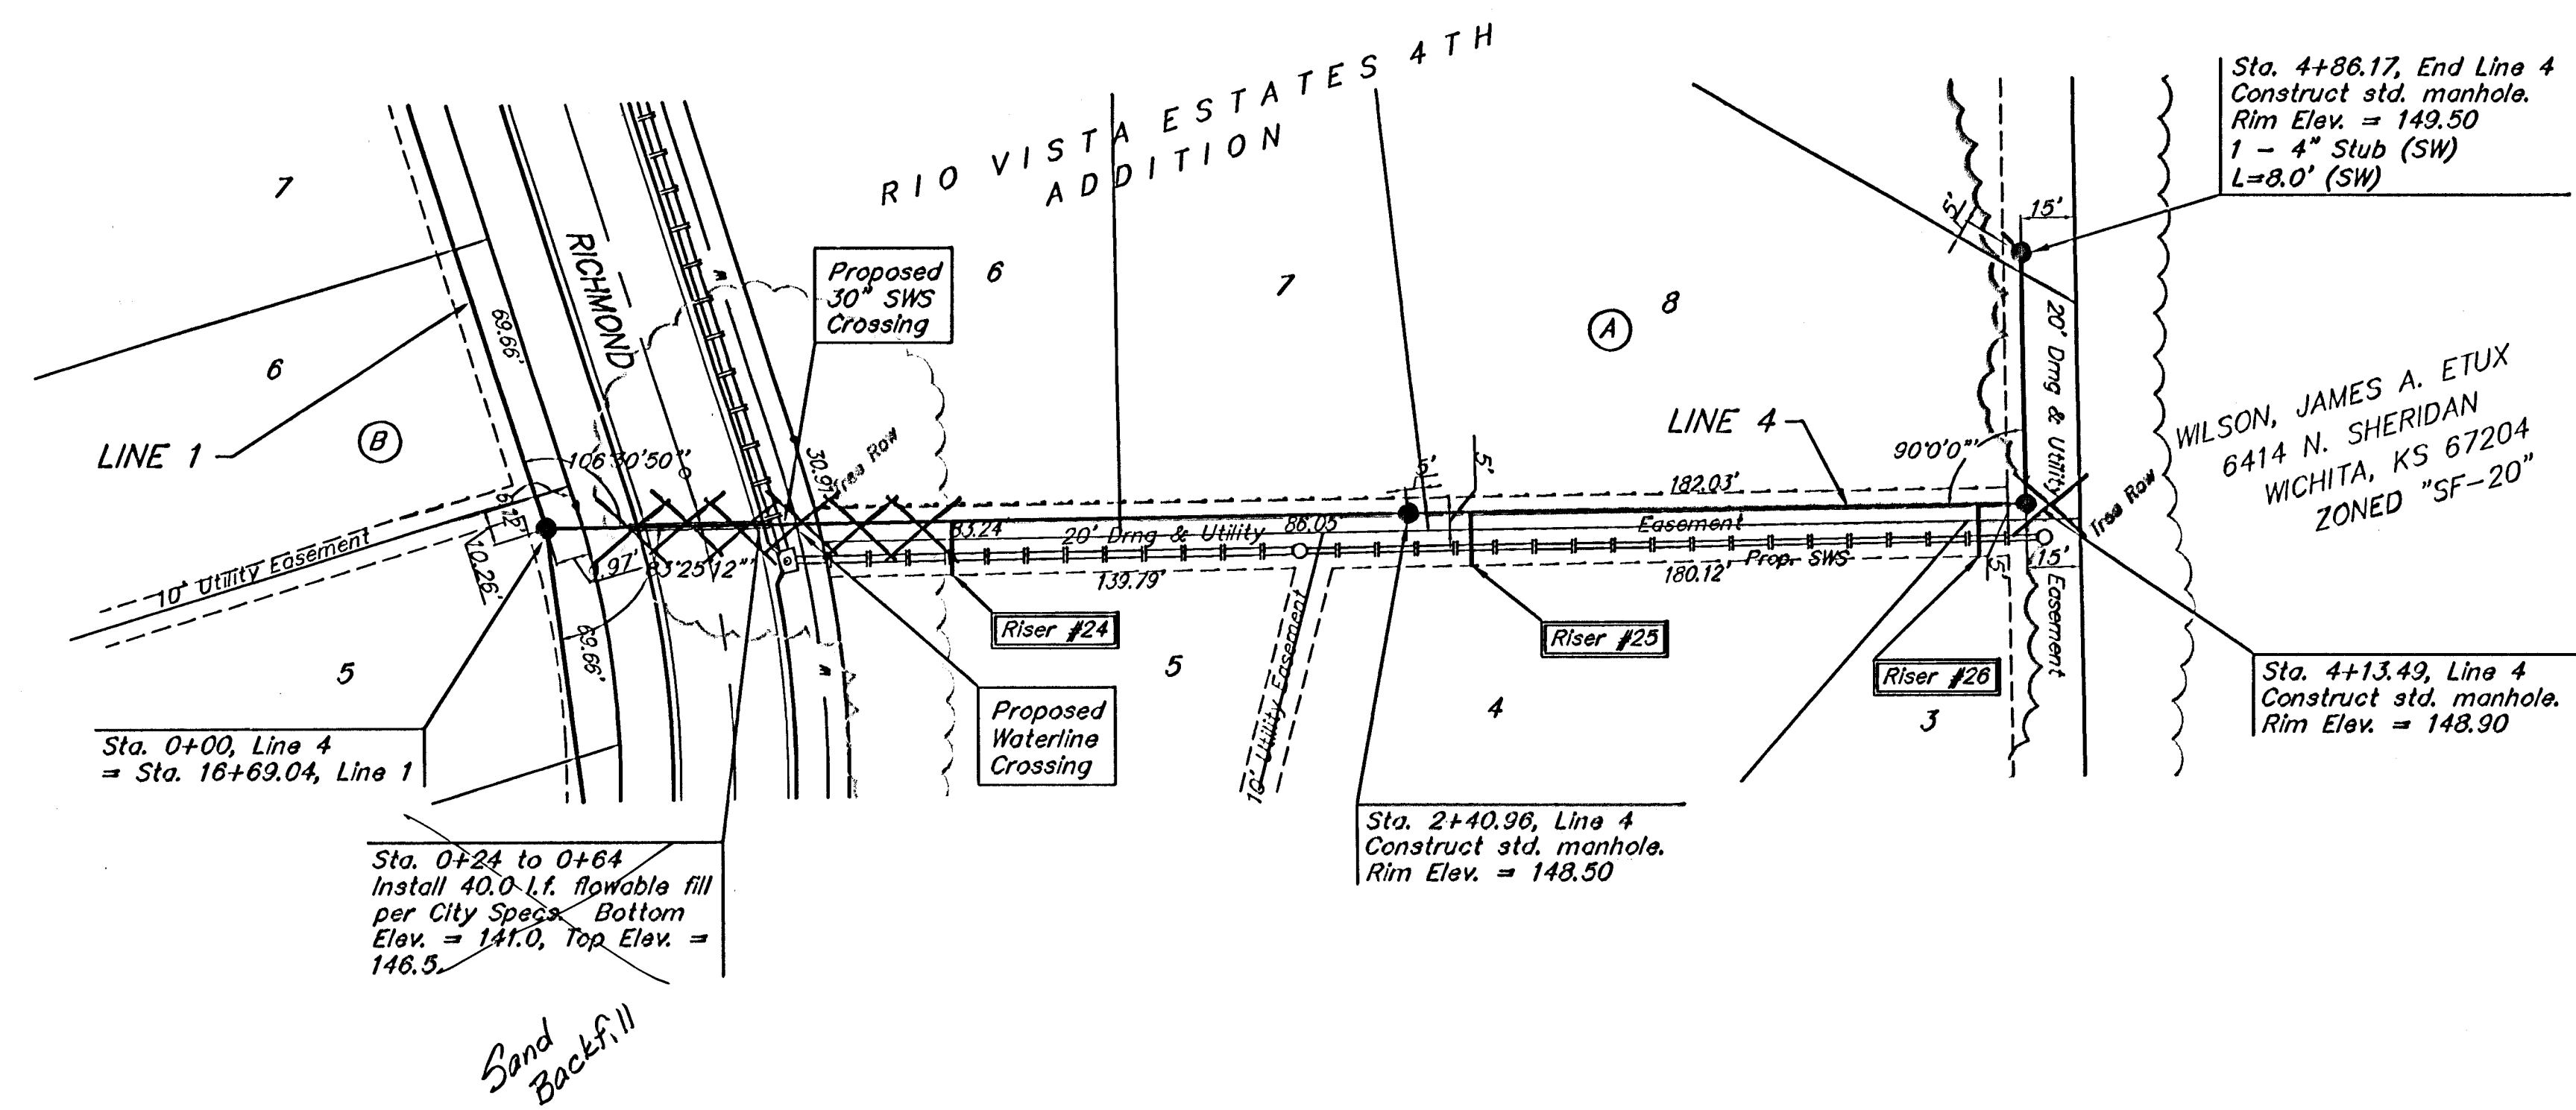

Scale: 1" = 40' Horizontal
1" = 5' Vertical
• = Iron

Denotes Trees to be
Removed by the
Sanitary Sewer Contractor

SEWER SERVICE TABLE - See Sheet 6

LINE 4

Stationing and Elevations:

- Sta. 0+00, Line 4 = Sta. 16+69.04, Line 1
- Sta. 2+40.96, Line 4: Construct std. manhole. Rim Elev. = 148.50
- Sta. 4+13.49, Line 4: Construct std. manhole. Rim Elev. = 148.90
- Sta. 4+86.17, End Line 4: Construct std. manhole. Rim Elev. = 149.50
- 1 - 4" Stub (SW) L=8.0' (SW)

Proposed Waterline Crossing:

- Proposed 30" SWS Crossing
- Proposed Waterline Crossing

Flow Data:



