
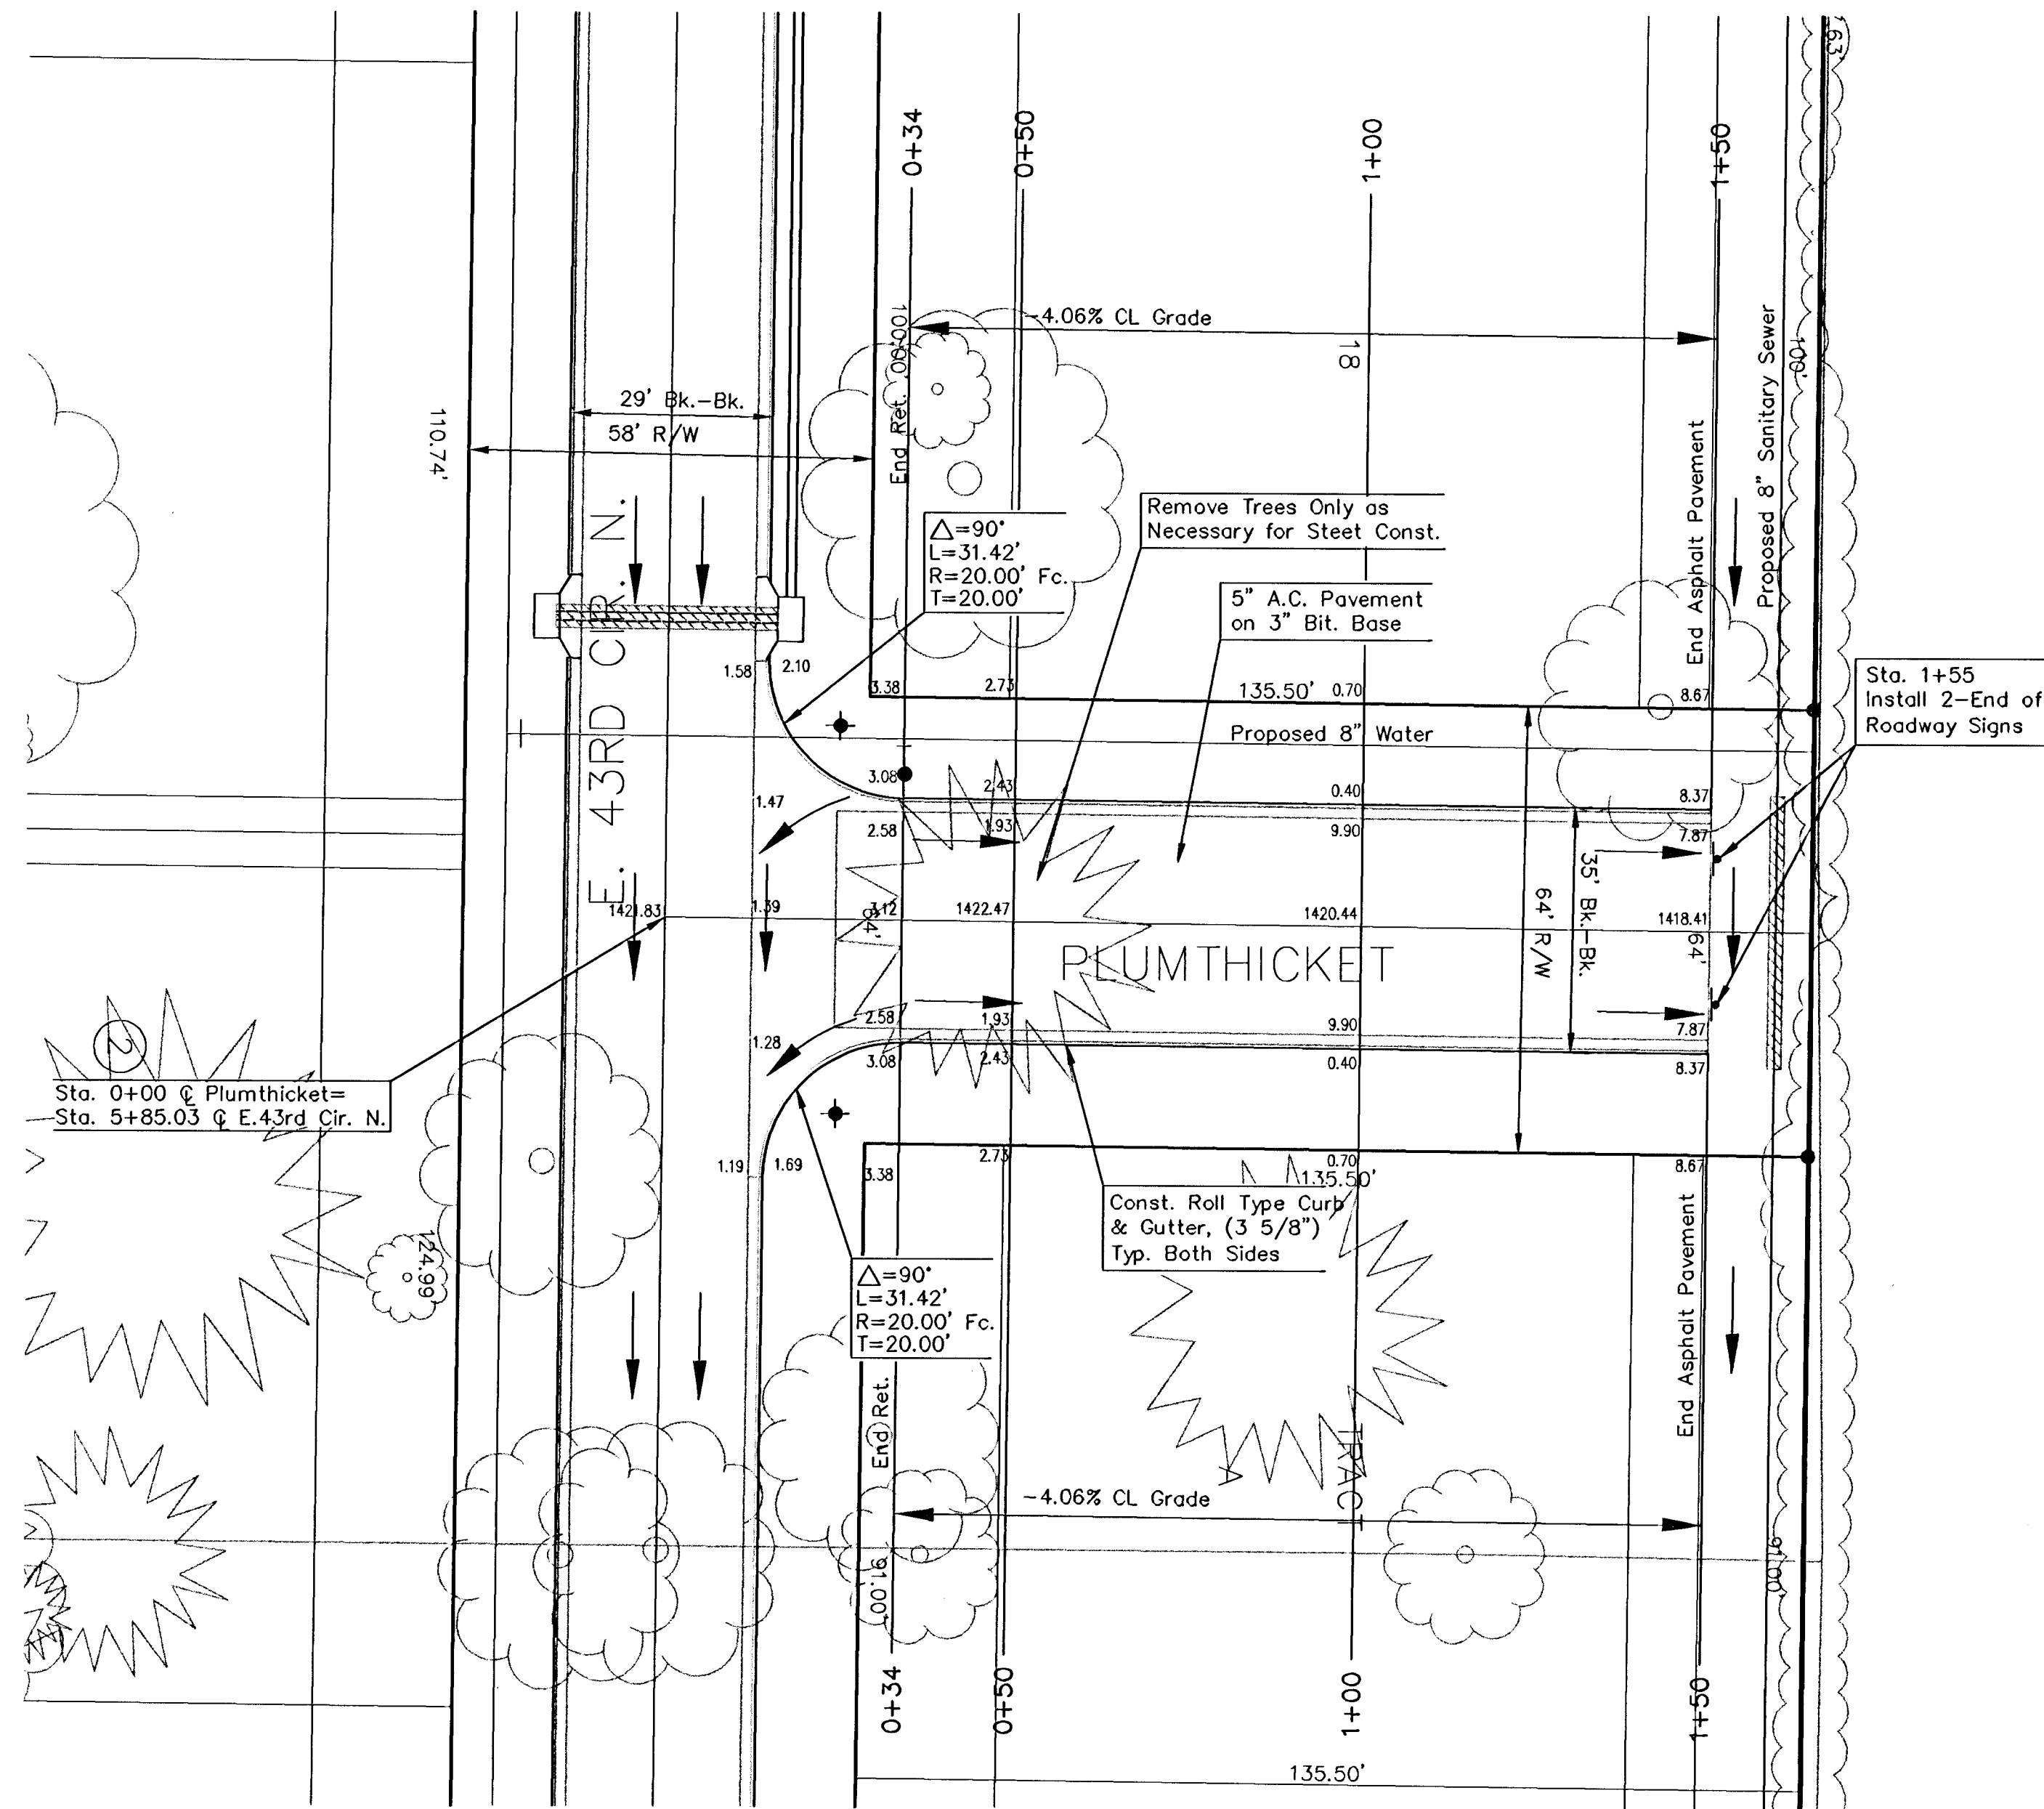


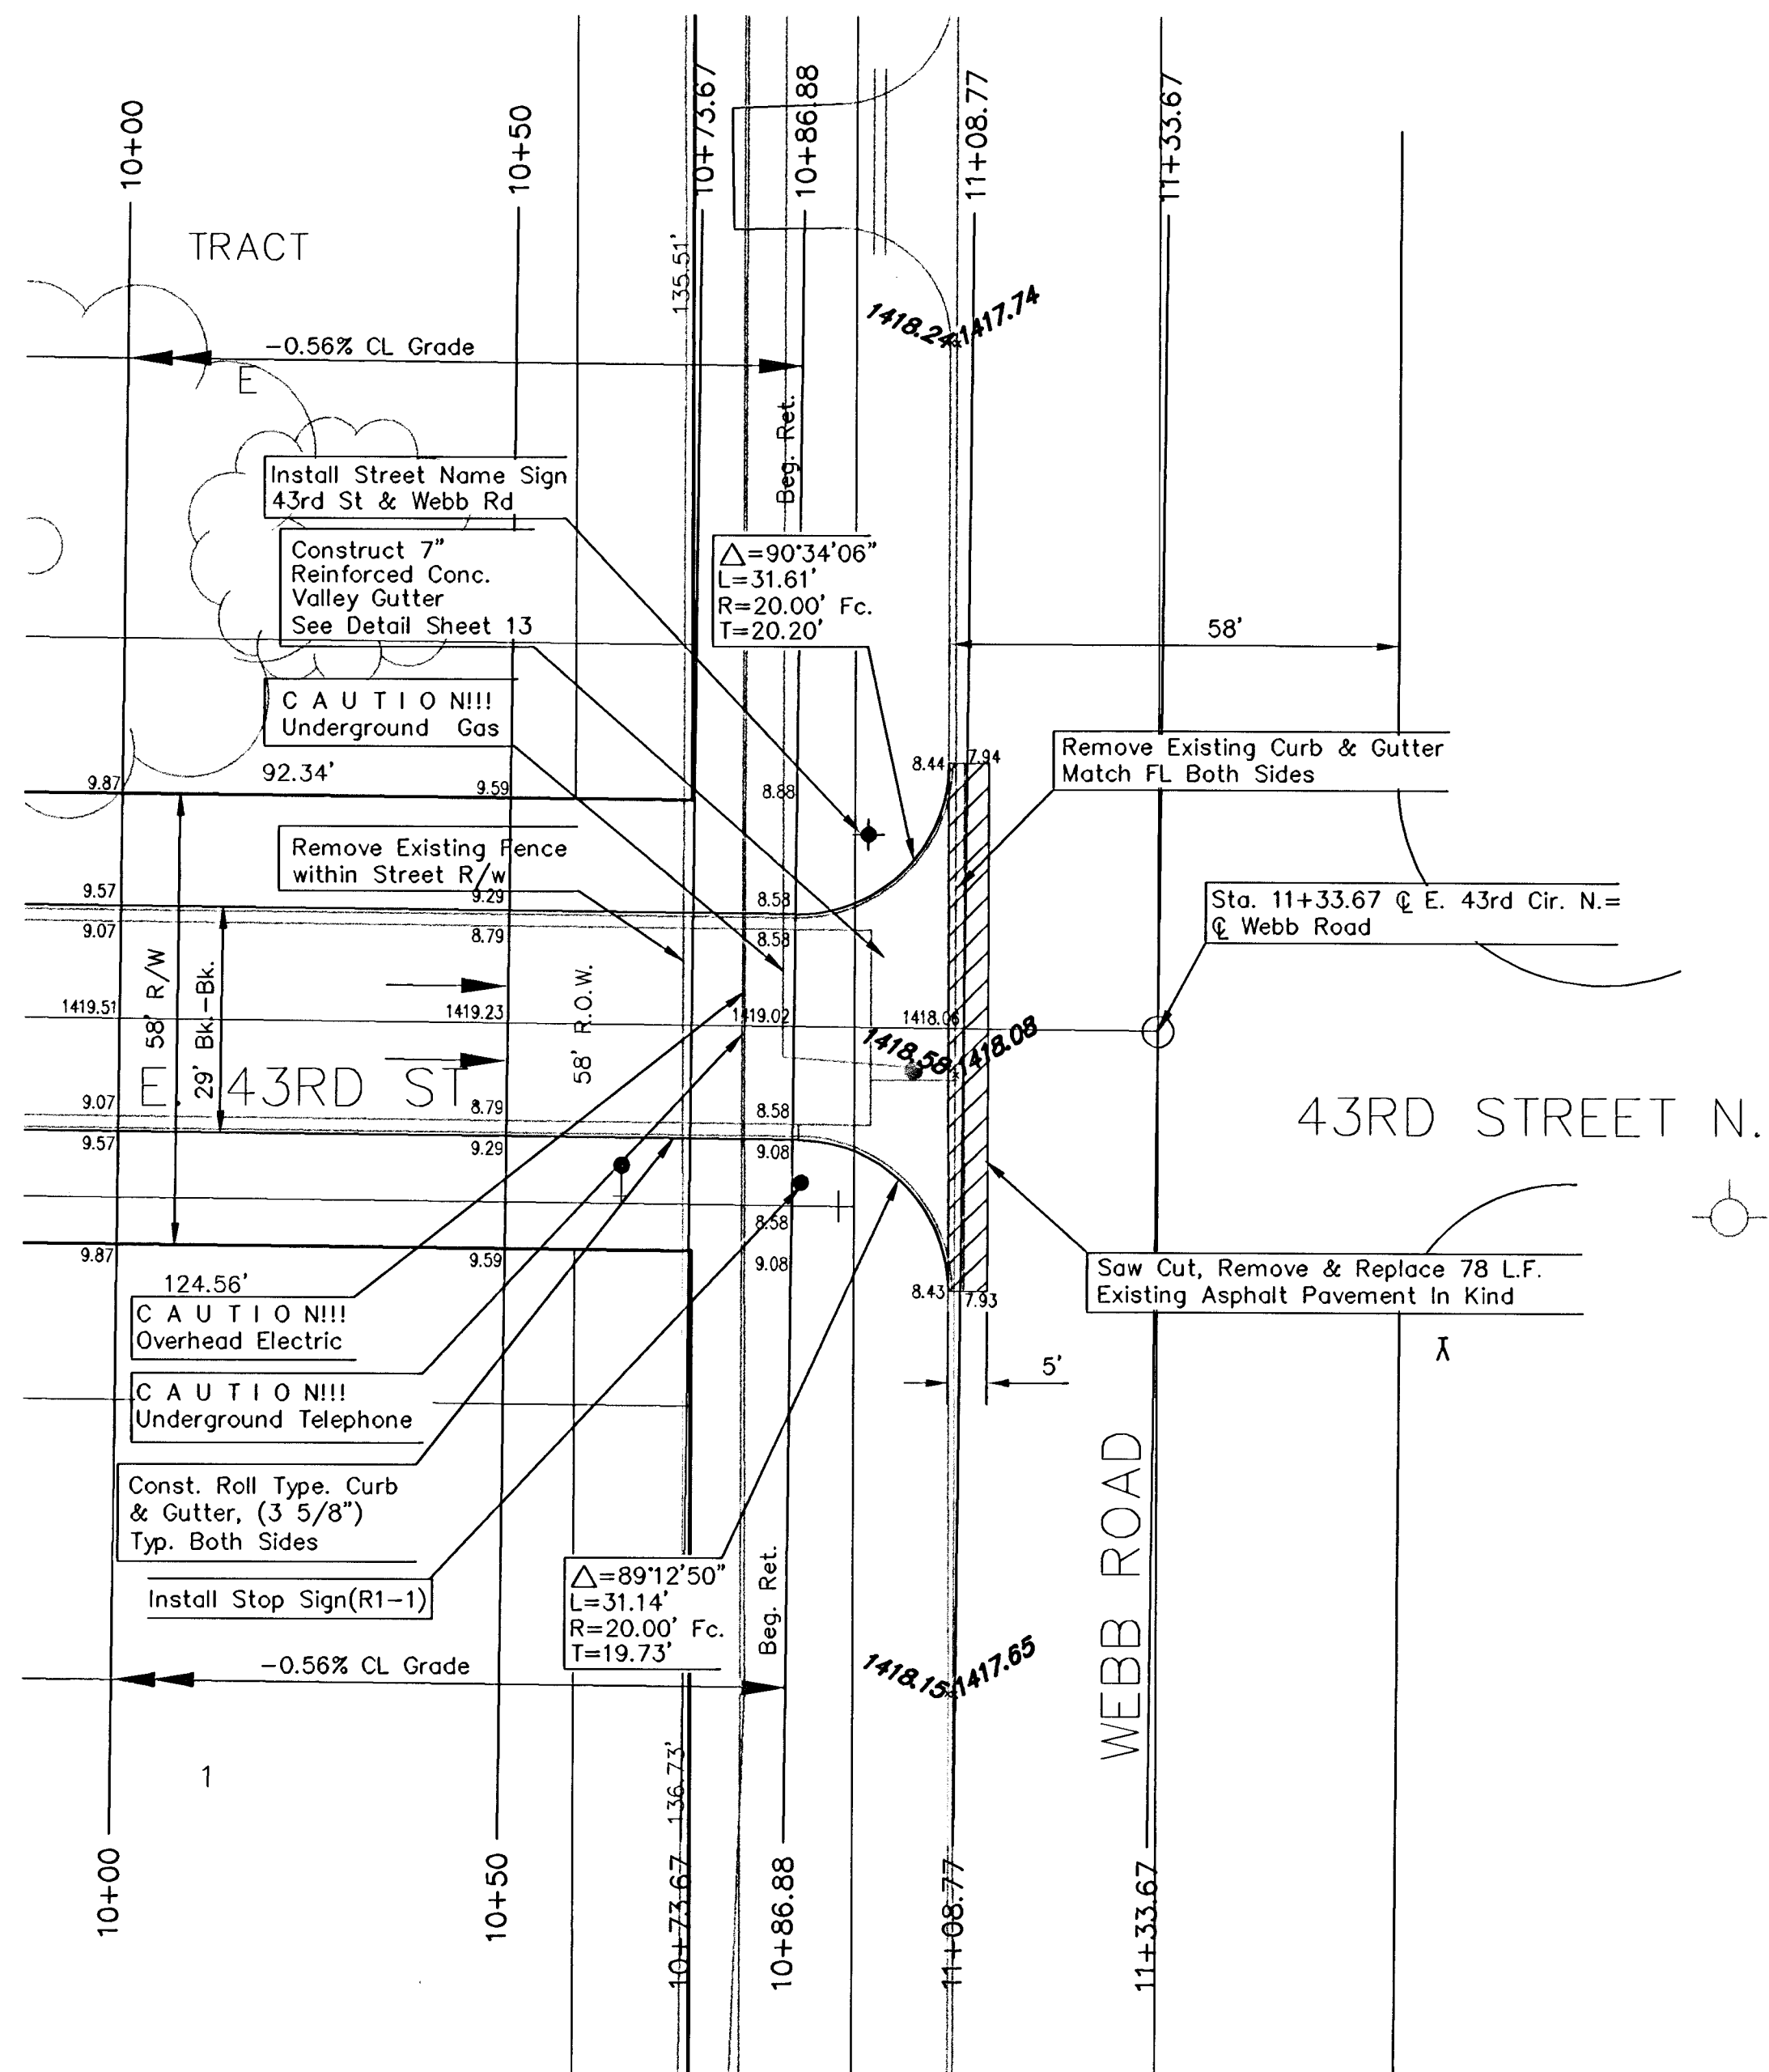

Subtract 0.25' From All Top of Curb Elevations

	PROJECT NUMBER 472-84027				AM NO. 02153-05	SHEET 6 OF 35
	DESIGN TA	DRAWN SS	FILE pav3a	DATE 12/23/04	SCALE Graphic	
SANDPLUM ADDITION						REVISED
E. 43RD ST./PLUMTHICKET WICHITA, KANSAS						