

HAWTHORNE PHASE 1
STORM WATER SEWER PLANS
PLAN AND PROFILE

HAWTHORNE THIRD ADDITION

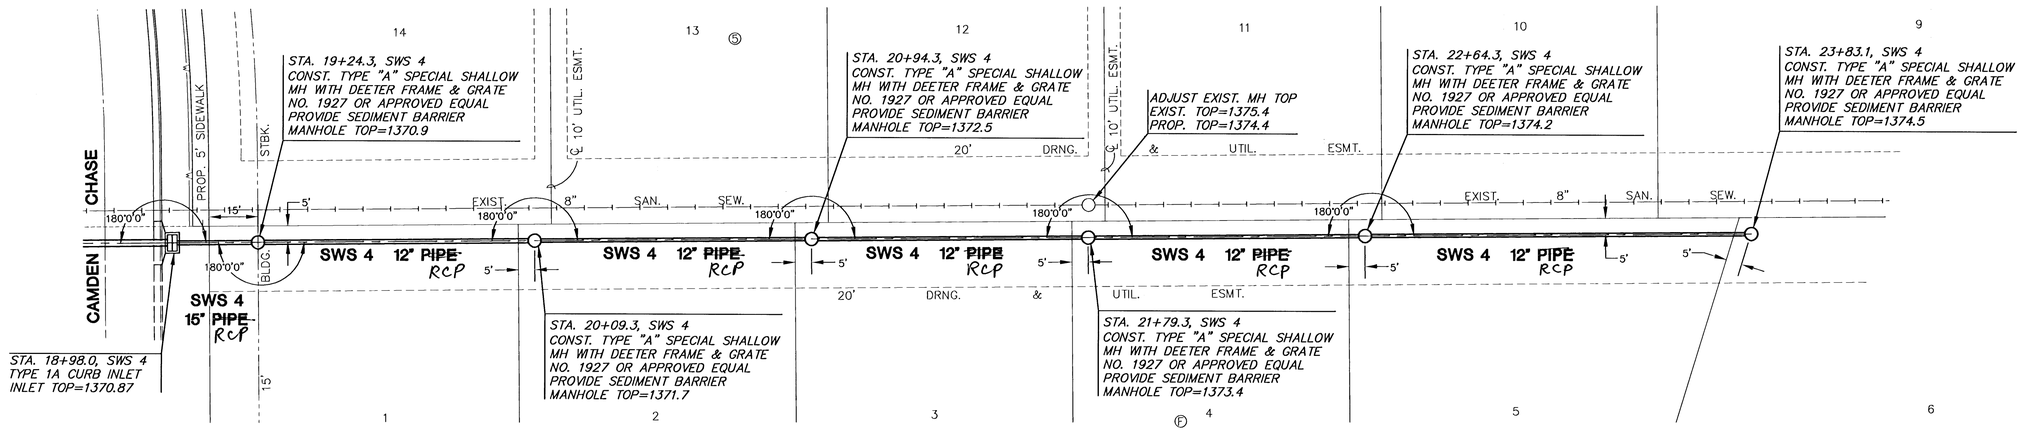

SCALE: 1"=20'
20 10 0 20

HAWTHORNE THIRD ADDITION

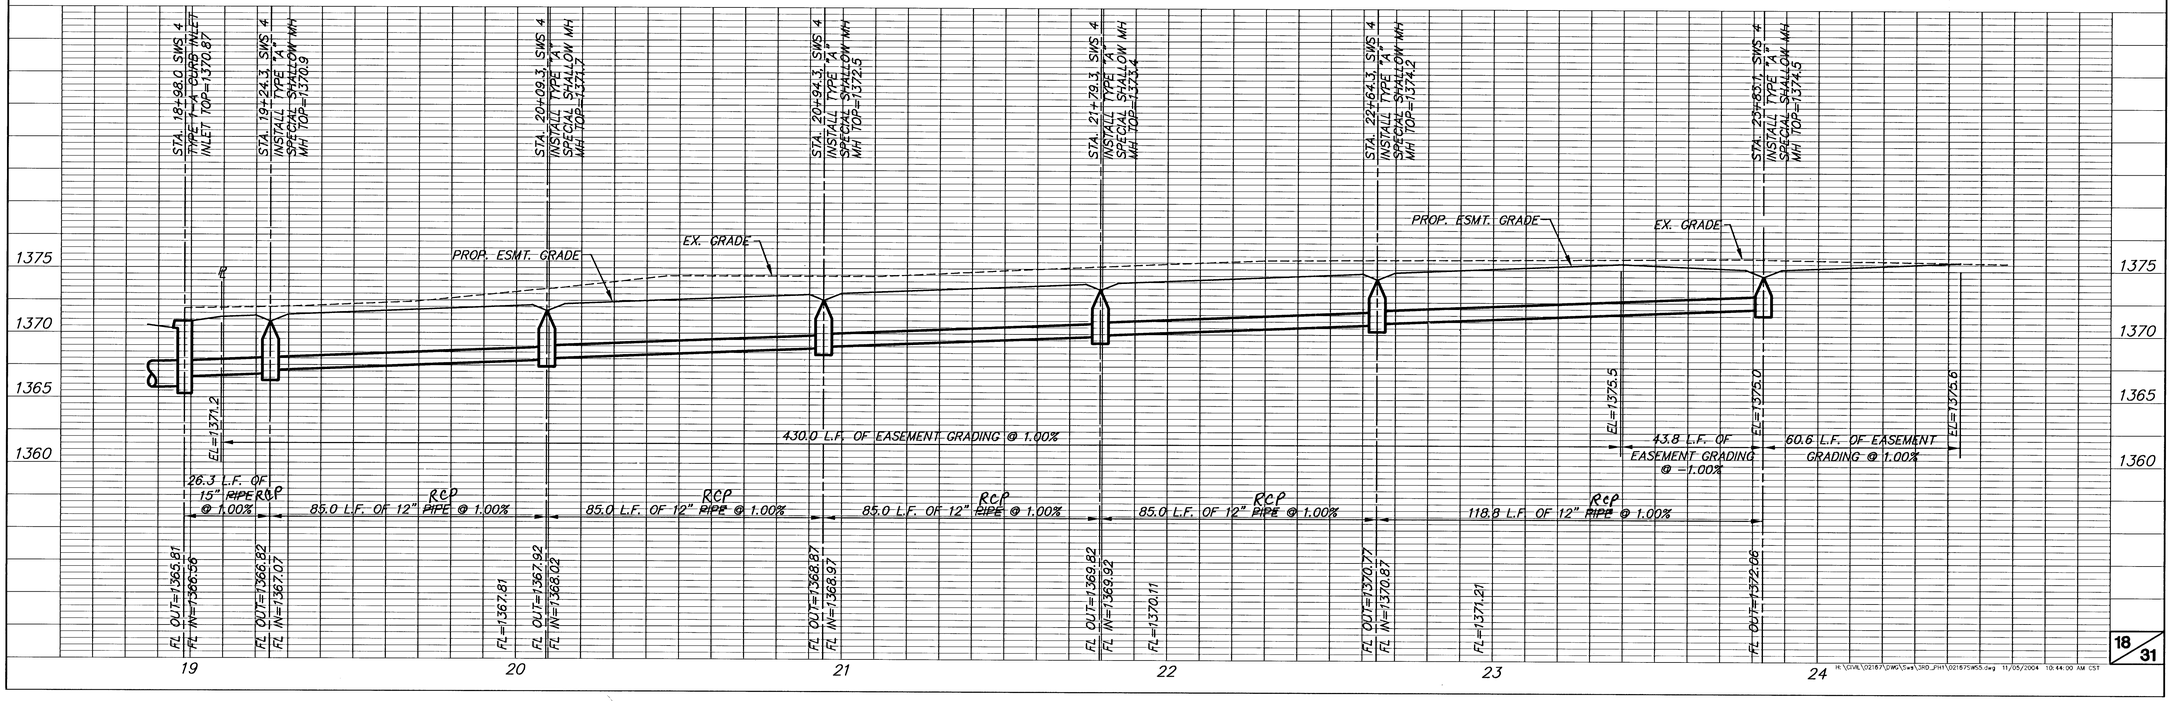

H:\CIVIL\021671\DWGS\ss\3RD_PH1\021675ss5.dwg 11/05/2004 10:44:00 AM CST