

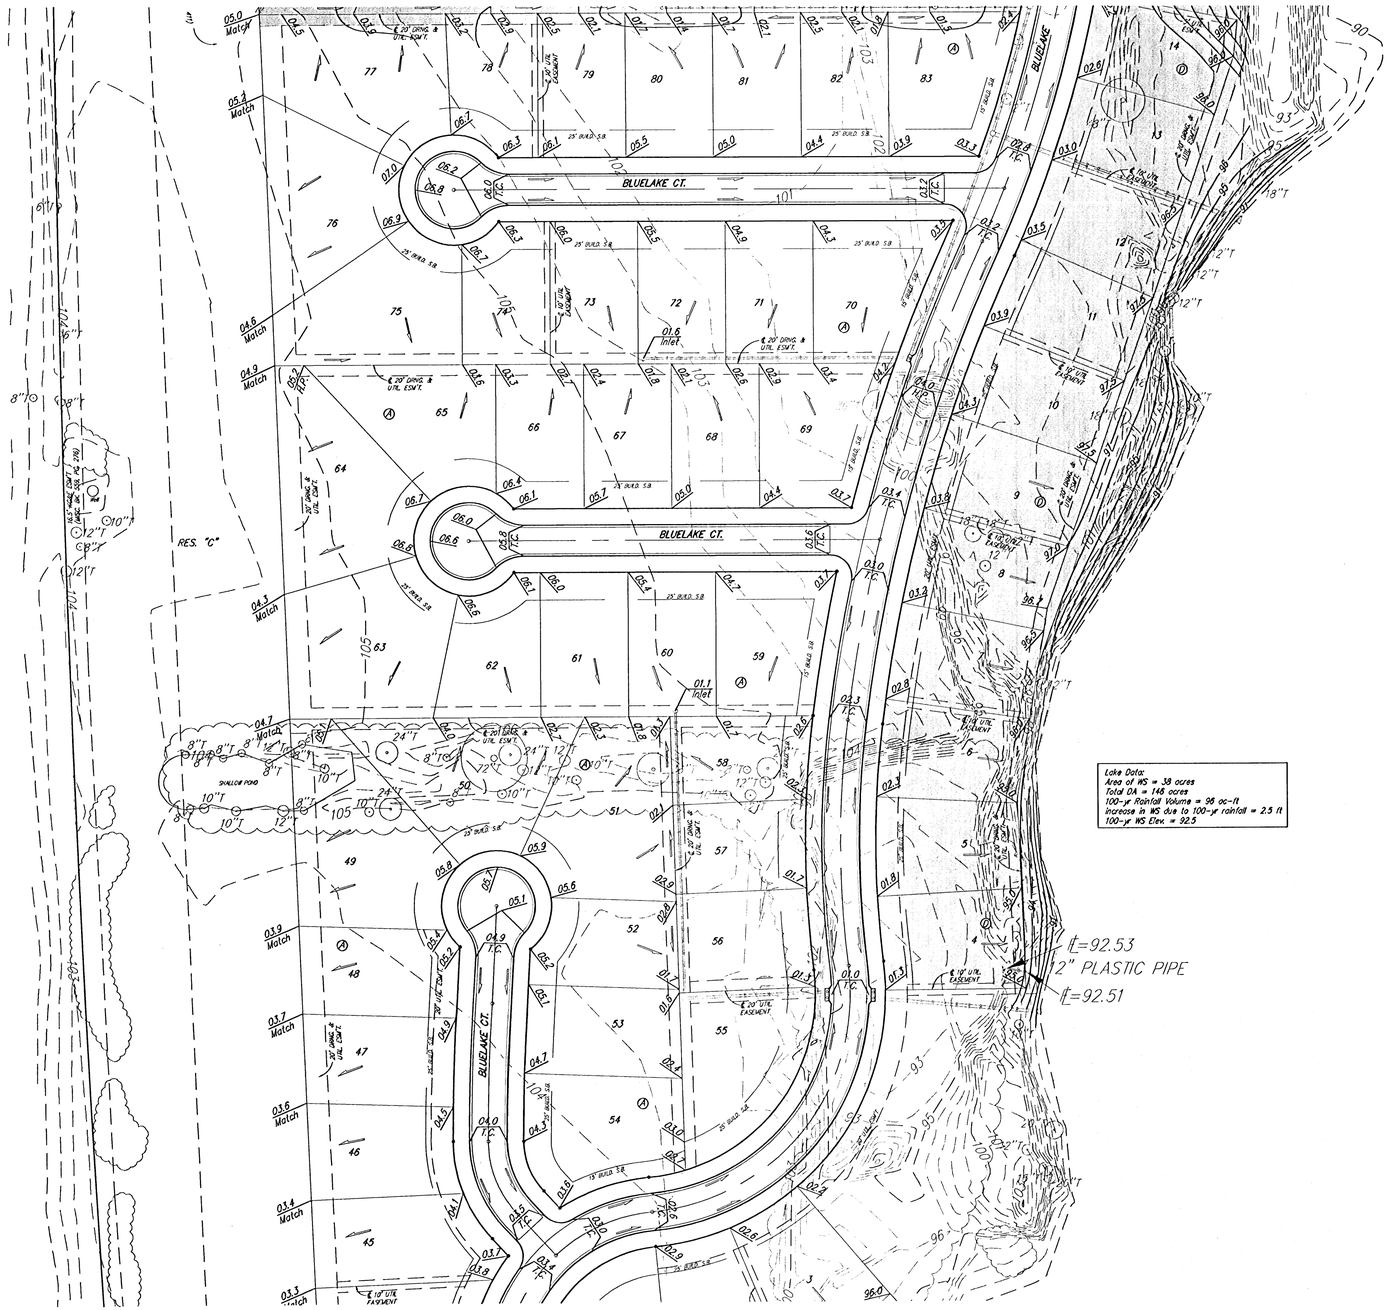


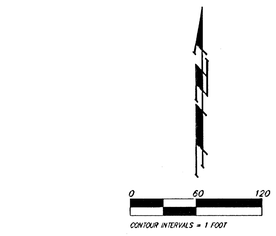

Area to be graded

144 Existing Grade

144 Proposed Grade

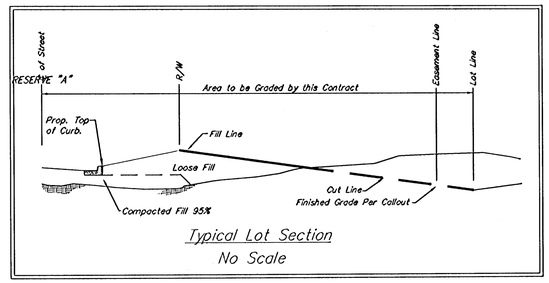

Typical Lot Section

No Scale

Benchmarks:
Hoover and MacArthur (39th St. South)
COW Bench Mark. NE corner of intersection.
41.60 ft North of center line.
69.00 ft East of center line.
20.00 ft East of guy pole.
79.80 ft NE of Section corner iron.

City 121.22 ft
MSL 1308.62 ft

Big Ditch and MacArthur
COW Bench Mark. West bound lane, east end of bridge.
East of Hoover.

City 116.52 ft
MSL 1303.92 ft

BLUE LAKE ADDITION

MASS GRADING

WICHITA, KANSAS

BAUGHMAN COMPANY P.A.
ENGINEERING, SURVEYING, & PLANNING
316-262-7271 • 315 ELLIS • WICHITA, KANSAS 67211

PROJECT NUMBER					SHEET 42 OF 75
DESIGN BLG	DRAWN BLG	APPROVED	DATE 5-03-04	SCALE noted	

pre_grade.dwg