



TYPICAL PAVEMENT SECTION

- NOTES:**
- ① Contractor is Responsible for installing 150mm Topsoil Within Areas that will be Planted (Prior to the Installation of Landscaping). Paid for as "Placing Topsoil" (cu. m.).
 - ② 150 mm Subgrade Compaction (Type B) (MR-90) in Cut Sections is *SUBSIDIARY* to Other Earthwork Items.

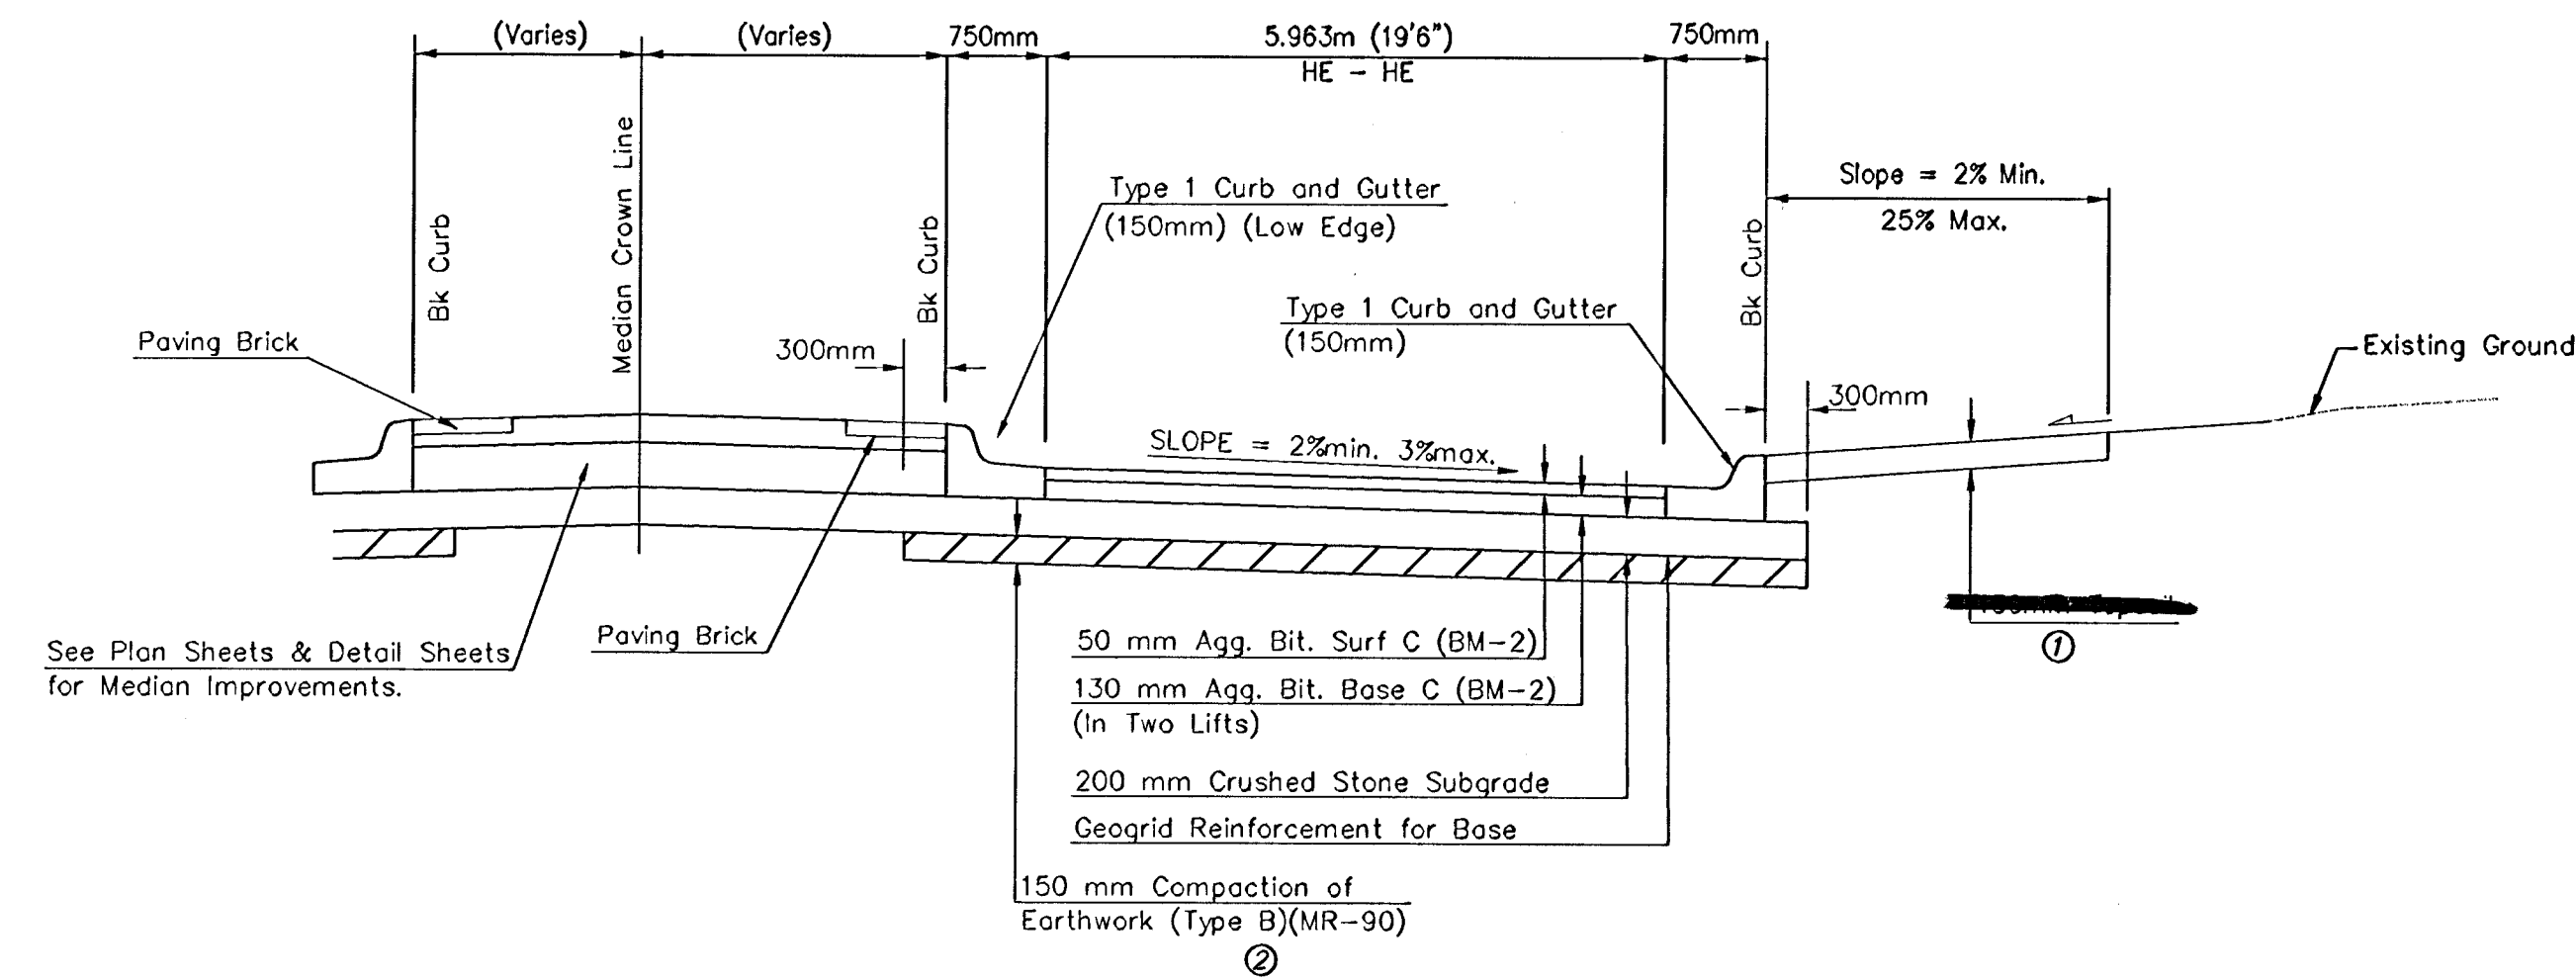

**TYPICAL SECTION (N. MCLEAN BLVD - FREE RIGHT LANE)
AT B.L. "A" STA. 0+500.000 (PERPENDICULAR TO CURB)**

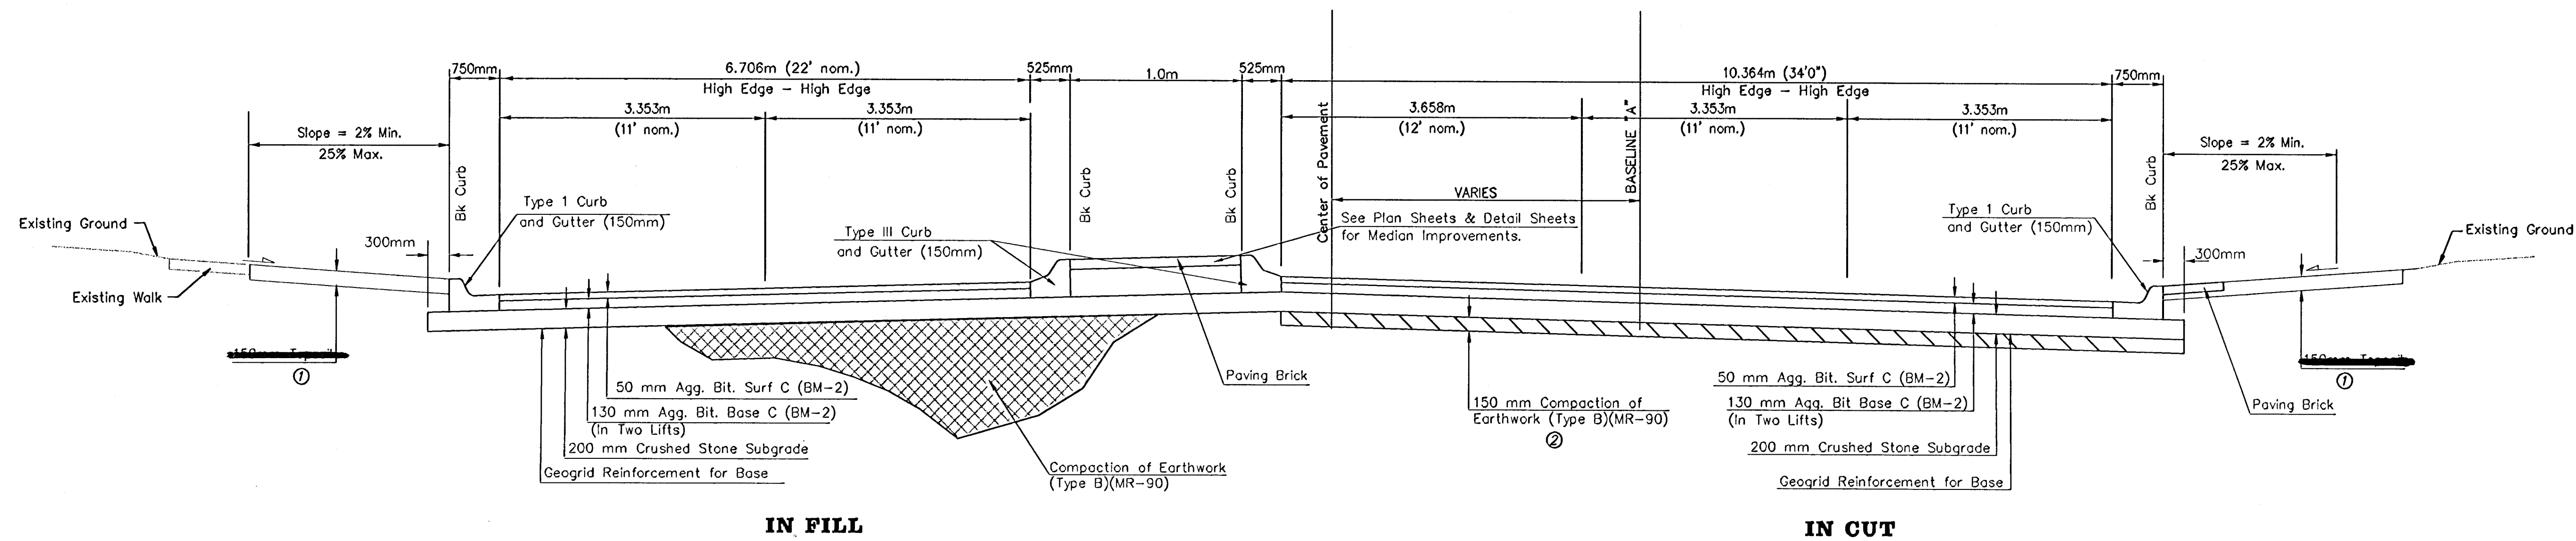

**TYPICAL SECTION (S. MCLEAN BLVD)
AT B.L. "A" STA. 0+475.000 (PERPENDICULAR TO CURB)**

METRIC

DESIGN	DATE	CITY PROJECT NUMBER	BAUGHMAN PROJECT NUMBER
JFB/JMN	JULY99	472-78-245-82910	98-01-E965
DRAWN	SCALE	APPROVED	DIRECTOR
KWR	NONE	JFB	F. ENGI MCININT
			SHEET NUMBER
			TYPSEC.DWG

**CAPITAL IMPROVEMENT PROJECT
TYPICAL SECTIONS
N. McLEAN & S. McLEAN
CENTRAL & McLEAN INTERSECTION IMPROVEMENTS**

BAUGHMAN COMPANY P. A.
ENGINEERING, SURVEYING, & PLANNING
316-262-7271 • 315 ELLIS • WICHITA, KANSAS 67211

SHEET
4
OF
40