




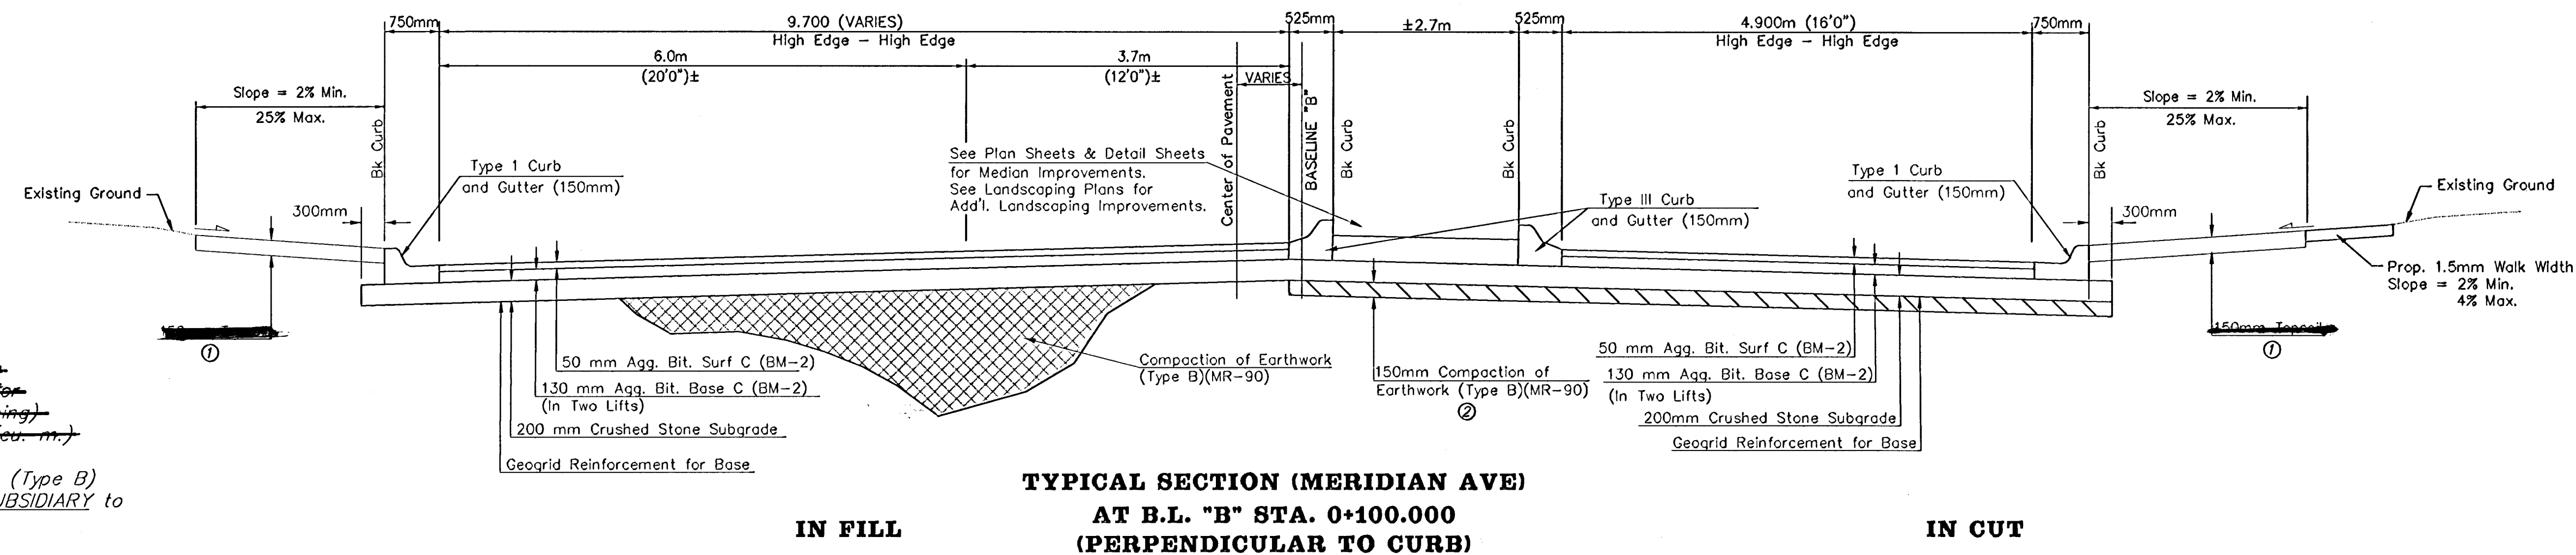


- NOTES:**
- Contractor is Responsible for installing 150mm Topsoil Within Areas that will be Planted (Prior to the Installation of Landscaping) - Paid for as "Placing Topsoil" (cu. m.)
 - 150 mm Subgrade Compaction (Type B) (MR-90) in Cut Sections is SUBSIDIARY to Other Earthwork Items.
 - Brick Color, Pattern, & Style as Per Brick Crosswalk Plan on Sheet 15. Paving Brick by PAVESTONE PAVERS or Approved Equal.
 - Reinforcing Steel & Mesh to be SUBSIDIARY to bid item "Concrete Pavement (200mm)(UNIF)(AE)"

PAVING BRICK CROSSWALK DETAIL "A"

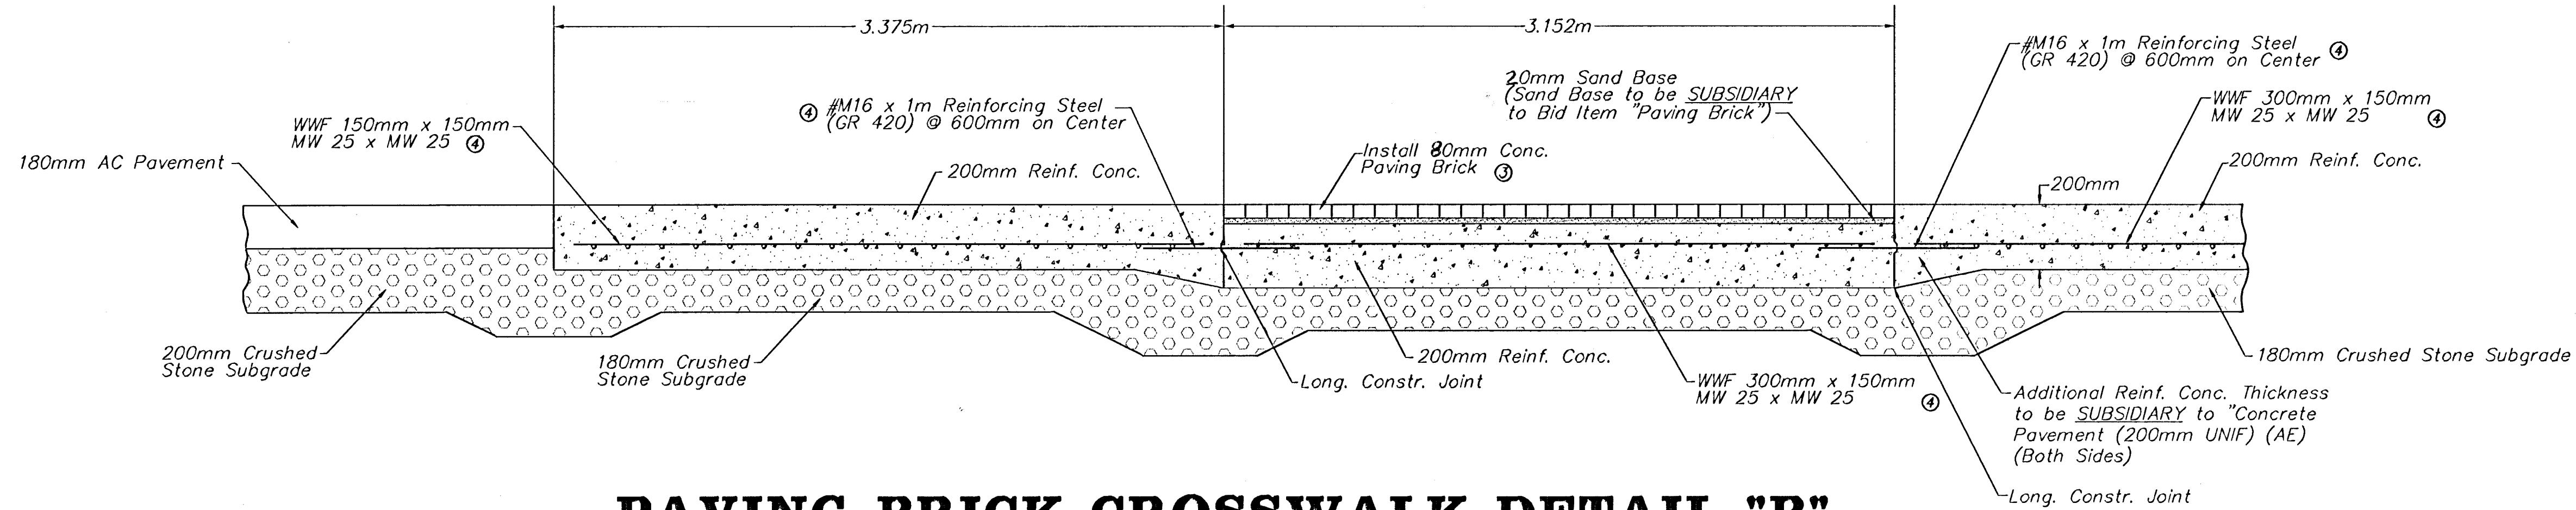

PAVING BRICK CROSSWALK DETAIL "B"

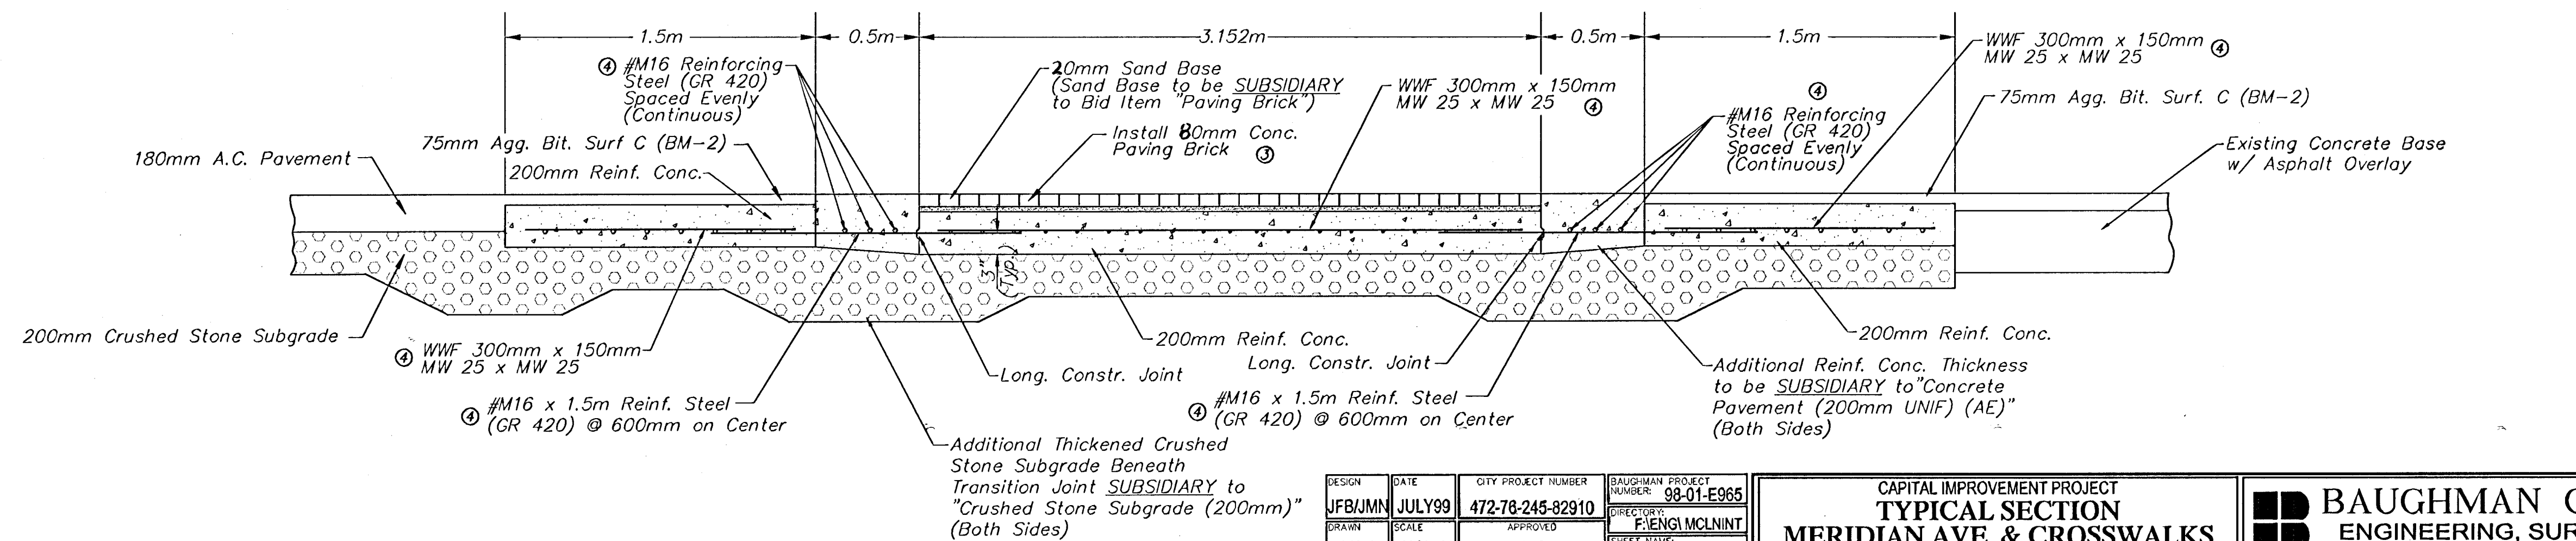

METRIC

DESIGN	DATE	CITY PROJECT NUMBER	BAUGHMAN PROJECT NUMBER
DRAWN	SCALE	APPROVED	DIRECTOR
KWR	NONE	JFB	F. ENGLISH
			SHEET NUMBER
			TYPSEC2.DWG

CAPITAL IMPROVEMENT PROJECT
TYPICAL SECTION
MERIDIAN AVE. & CROSSWALKS
CENTRAL & MCLEAN INTERSECTION IMPROVEMENTS

BAUGHMAN COMPANY P. A.
ENGINEERING, SURVEYING, & PLANNING
315-262-7271 • 315 ELLIS • WICHITA, KANSAS 67211

SHEET
OF
40