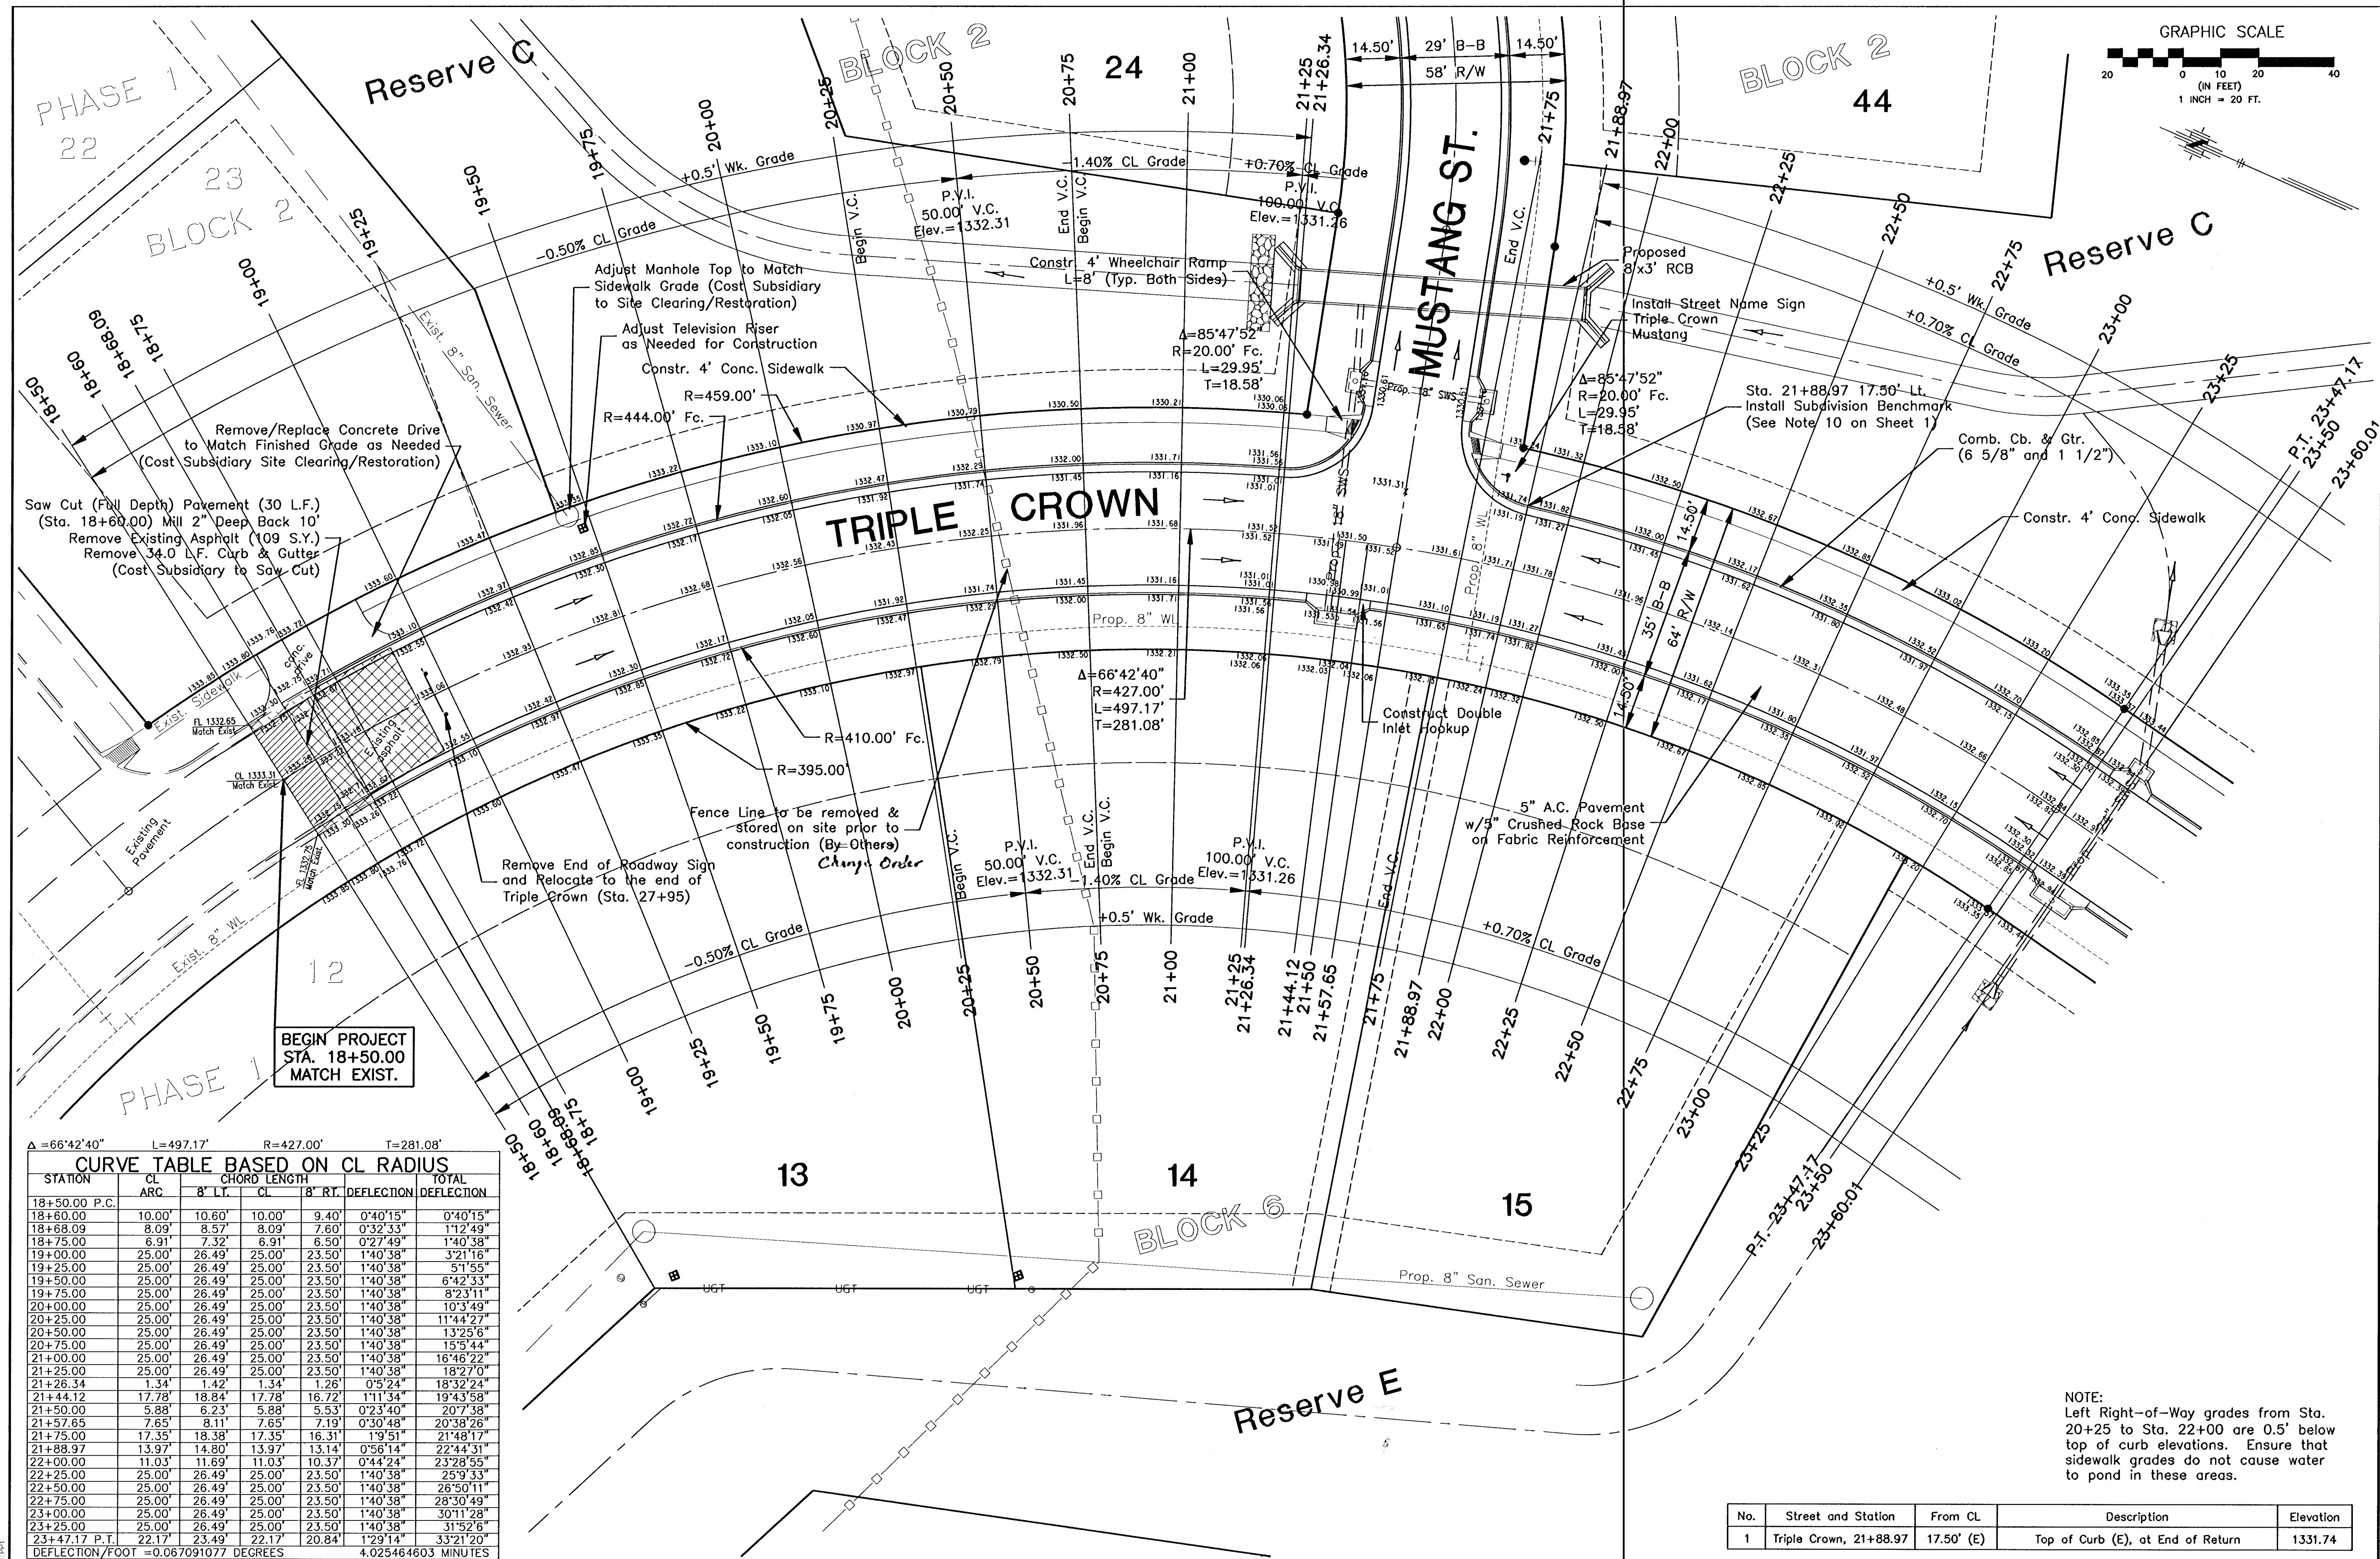


Δ = 66°42'40" L = 497.17' R = 427.00' T = 281.08'

CURVE TABLE BASED ON CL RADIUS						
STATION	CL	CHORD LENGTH	8' RT.	DEFLECTION	TOTAL	DEFLECTION
18+50.00 P.C.						
18+60.00	10.00'	10.60'	10.00'	9.40'	0°40'15"	0°40'15"
18+68.09	8.09'	8.57'	8.09'	7.60'	0°32'33"	1°12'49"
18+75.00	6.91'	7.32'	6.91'	6.50'	0°27'49"	1°40'38"
19+00.00	25.00'	26.49'	25.00'	23.50'	1°40'38"	3°21'16"
19+25.00	25.00'	26.49'	25.00'	23.50'	1°40'38"	5°1'55"
19+50.00	25.00'	26.49'	25.00'	23.50'	1°40'38"	6°42'33"
19+75.00	25.00'	26.49'	25.00'	23.50'	1°40'38"	8°23'11"
20+00.00	25.00'	26.49'	25.00'	23.50'	1°40'38"	10°3'49"
20+25.00	25.00'	26.49'	25.00'	23.50'	1°40'38"	11°44'27"
20+50.00	25.00'	26.49'	25.00'	23.50'	1°40'38"	13°25'6"
20+75.00	25.00'	26.49'	25.00'	23.50'	1°40'38"	15°5'44"
21+00.00	25.00'	26.49'	25.00'	23.50'	1°40'38"	16°46'22"
21+25.00	25.00'	26.49'	25.00'	23.50'	1°40'38"	18°27'0"
22+25.00	25.00'	26.49'	25.00'	23.50'	1°40'38"	25°9'33"
22+50.00	25.00'	26.49'	25.00'	23.50'	1°40'38"	26°50'11"
22+75.00	25.00'	26.49'	25.00'	23.50'	1°40'38"	28°30'49"
23+00.00	25.00'	26.49'	25.00'	23.50'	1°40'38"	30°11'28"
23+25.00	25.00'	26.49'	25.00'	23.50'	1°40'38"	31°52'6"
