


LINE NO. 2

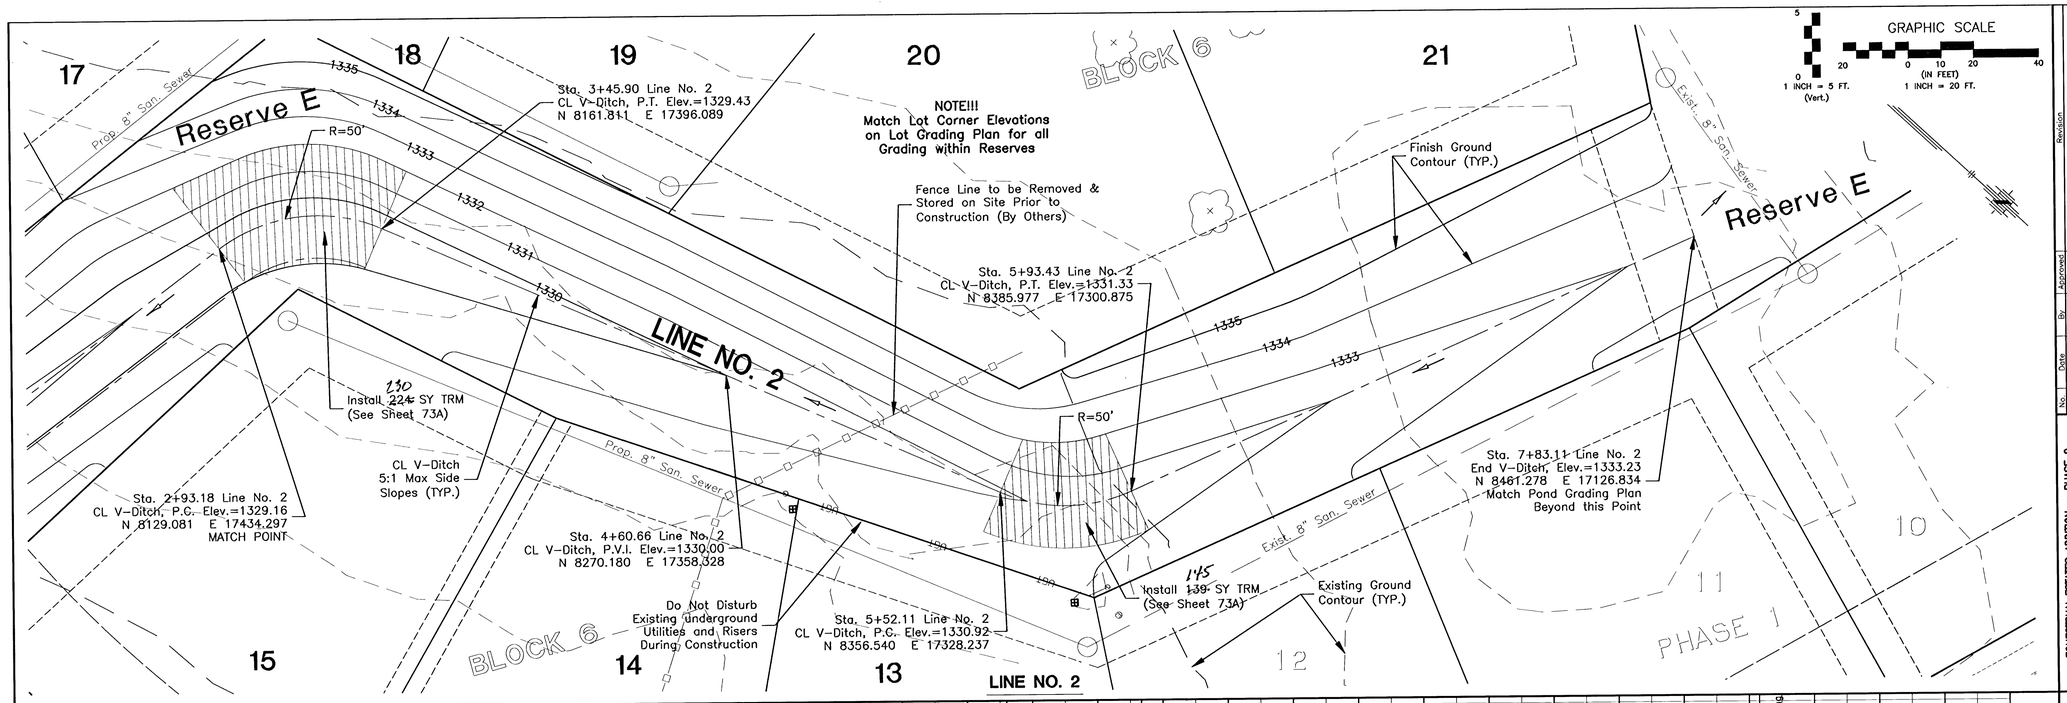


| No. | Date | By | Approved | Revision |
|---|---|---|---|---|
| | | | | |

EQUESTRIAN ESTATES ADDITION - PHASE 2
STORM WATER SEWER
LINE NUMBER 2
CITY OF WICHITA, KANSAS
JAMES L. ARMOUR, P.E. - CITY ENGINEER
C.O.W. Proj.# 472-83430 O.C.A.# 765969


POE & ASSOCIATES, INC.
CONSULTING ENGINEERS
5940 E. Central, Suite 200 ■ Wichita, KS 67208-4242
Phone 316/685-4114 ■ FAX 316/685-4444


FINAL

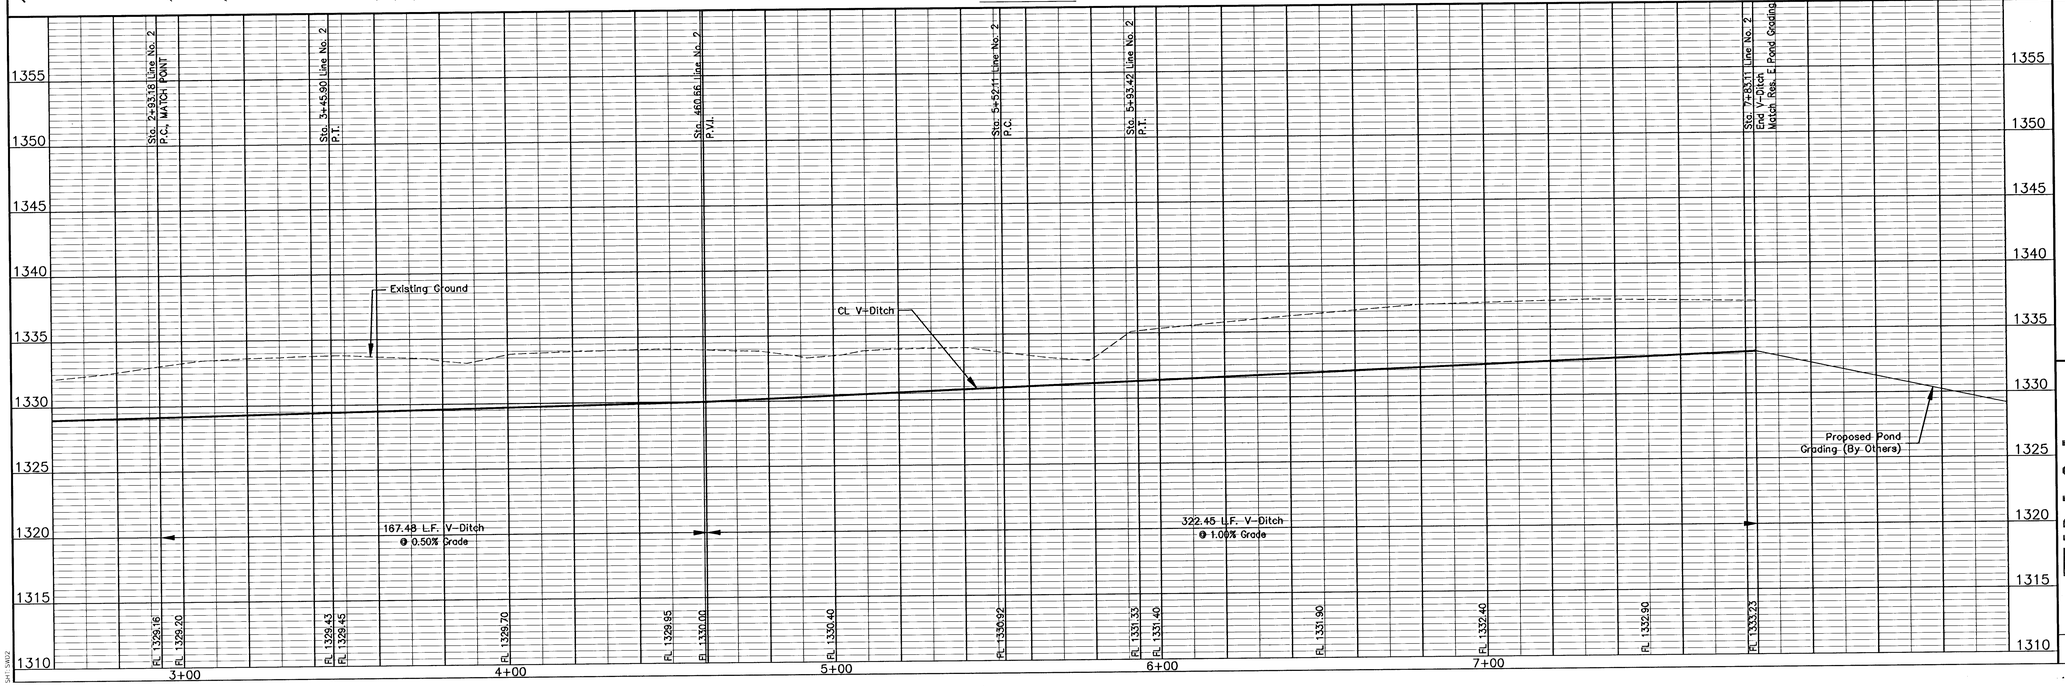Designed By: JMU/JPD
Drawn By: JPD
Poe Job No.: 16944
Date: January 2006