
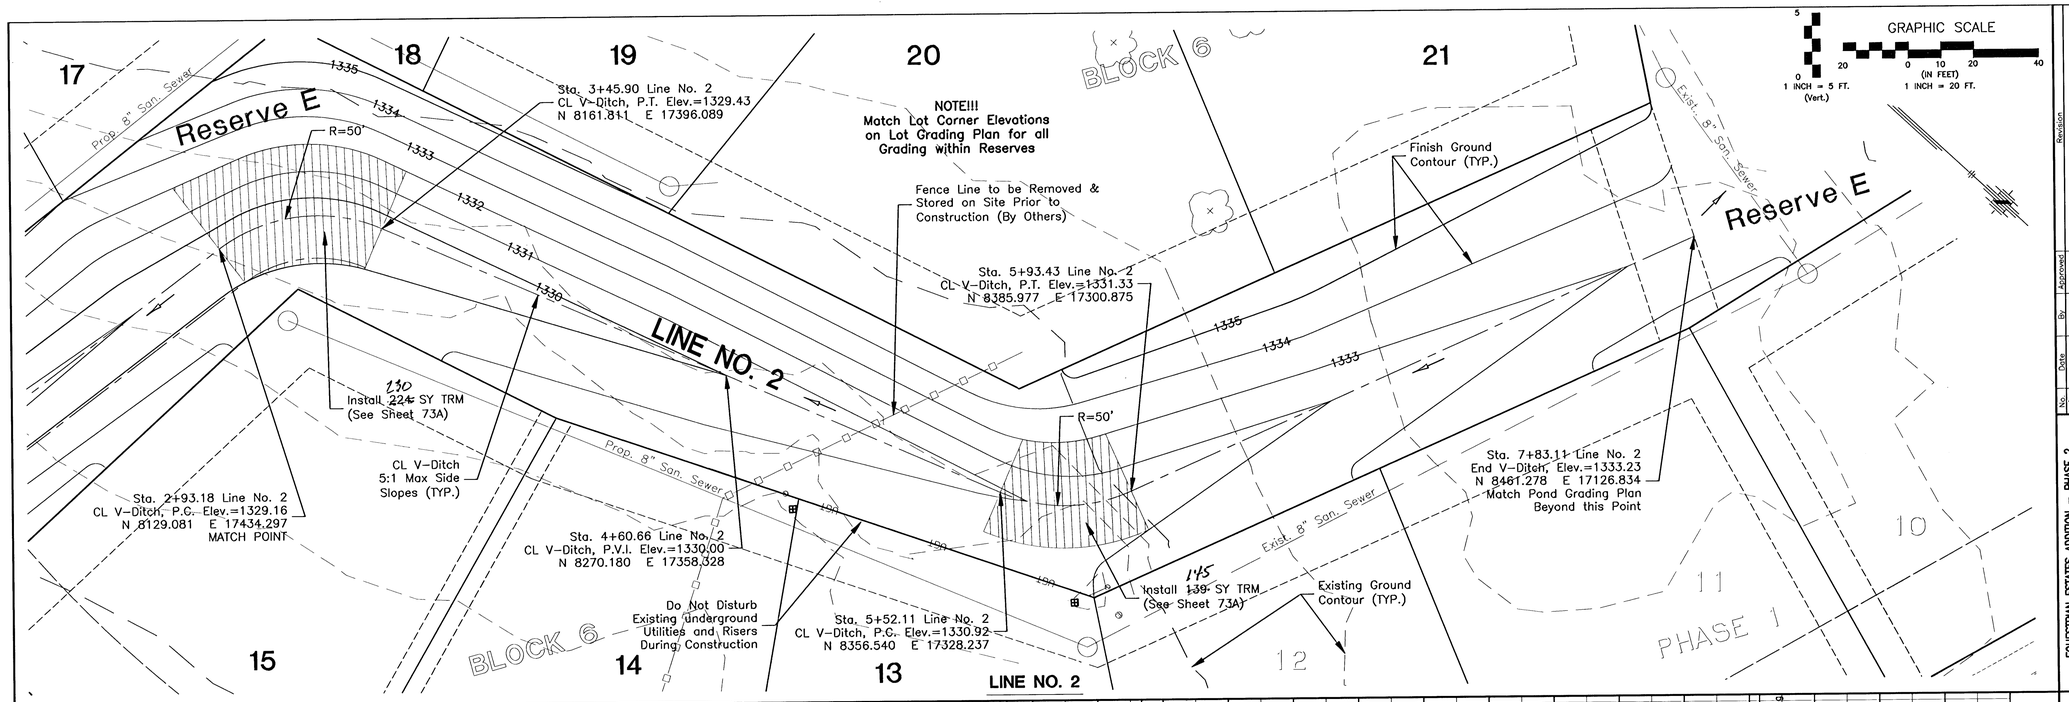


GRAPHIC SCALE

0 20 0 10 20 40 (IN FEET)

1 INCH = 5 FT. (Vert.) 1 INCH = 20 FT.

LINE NO. 2

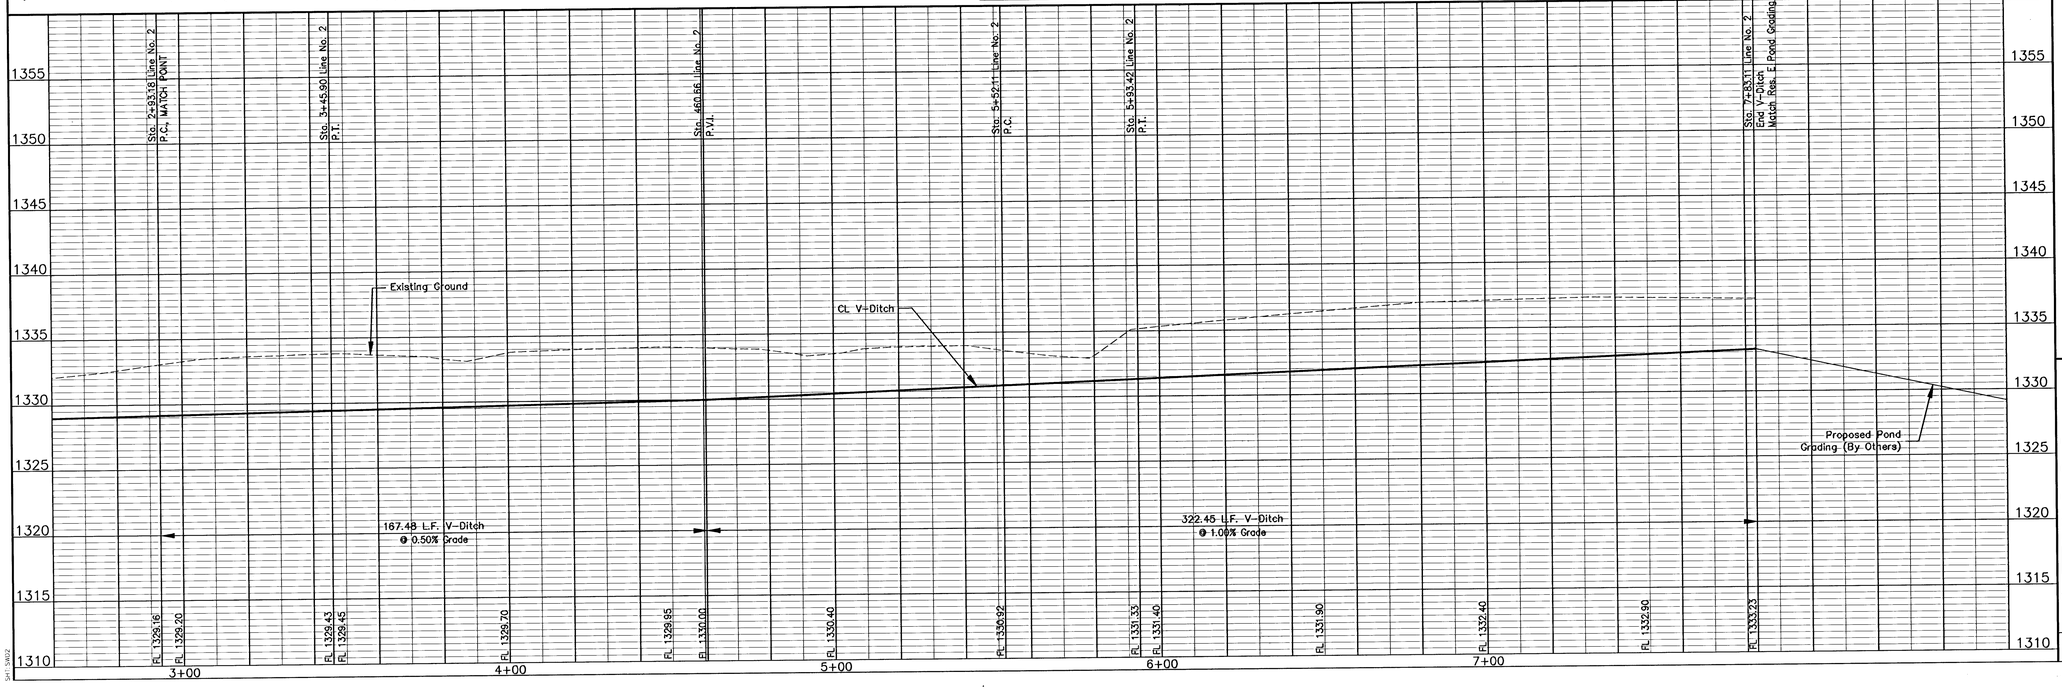

No.	Date	By	Approved	Revision

EQUESTRIAN ESTATES ADDITION - PHASE 2
STORM WATER SEWER
LINE NUMBER 2
CITY OF WICHITA, KANSAS
JAMES L. ARMOUR, P.E. - CITY ENGINEER
C.O.W. Proj.# 472-83430 O.C.A.# 765969

POE & ASSOCIATES, INC.
CONSULTING ENGINEERS
5940 E. Central, Suite 200 ■ Wichita, KS 67208-4242
Phone 316/685-4114 ■ FAX 316/685-4444

FINAL

Designed By: JMU/JPD
Drawn By: JPD
Poe Job No.: 16964J
Date: January 2006

Sheet
15 of 78