
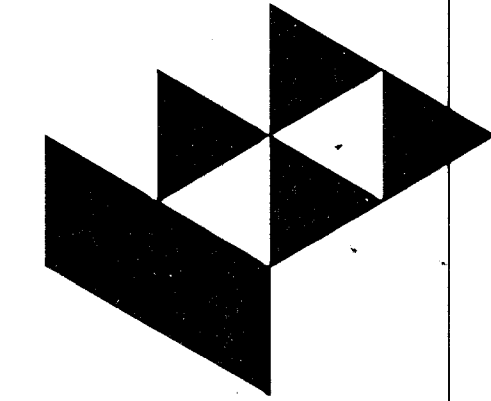


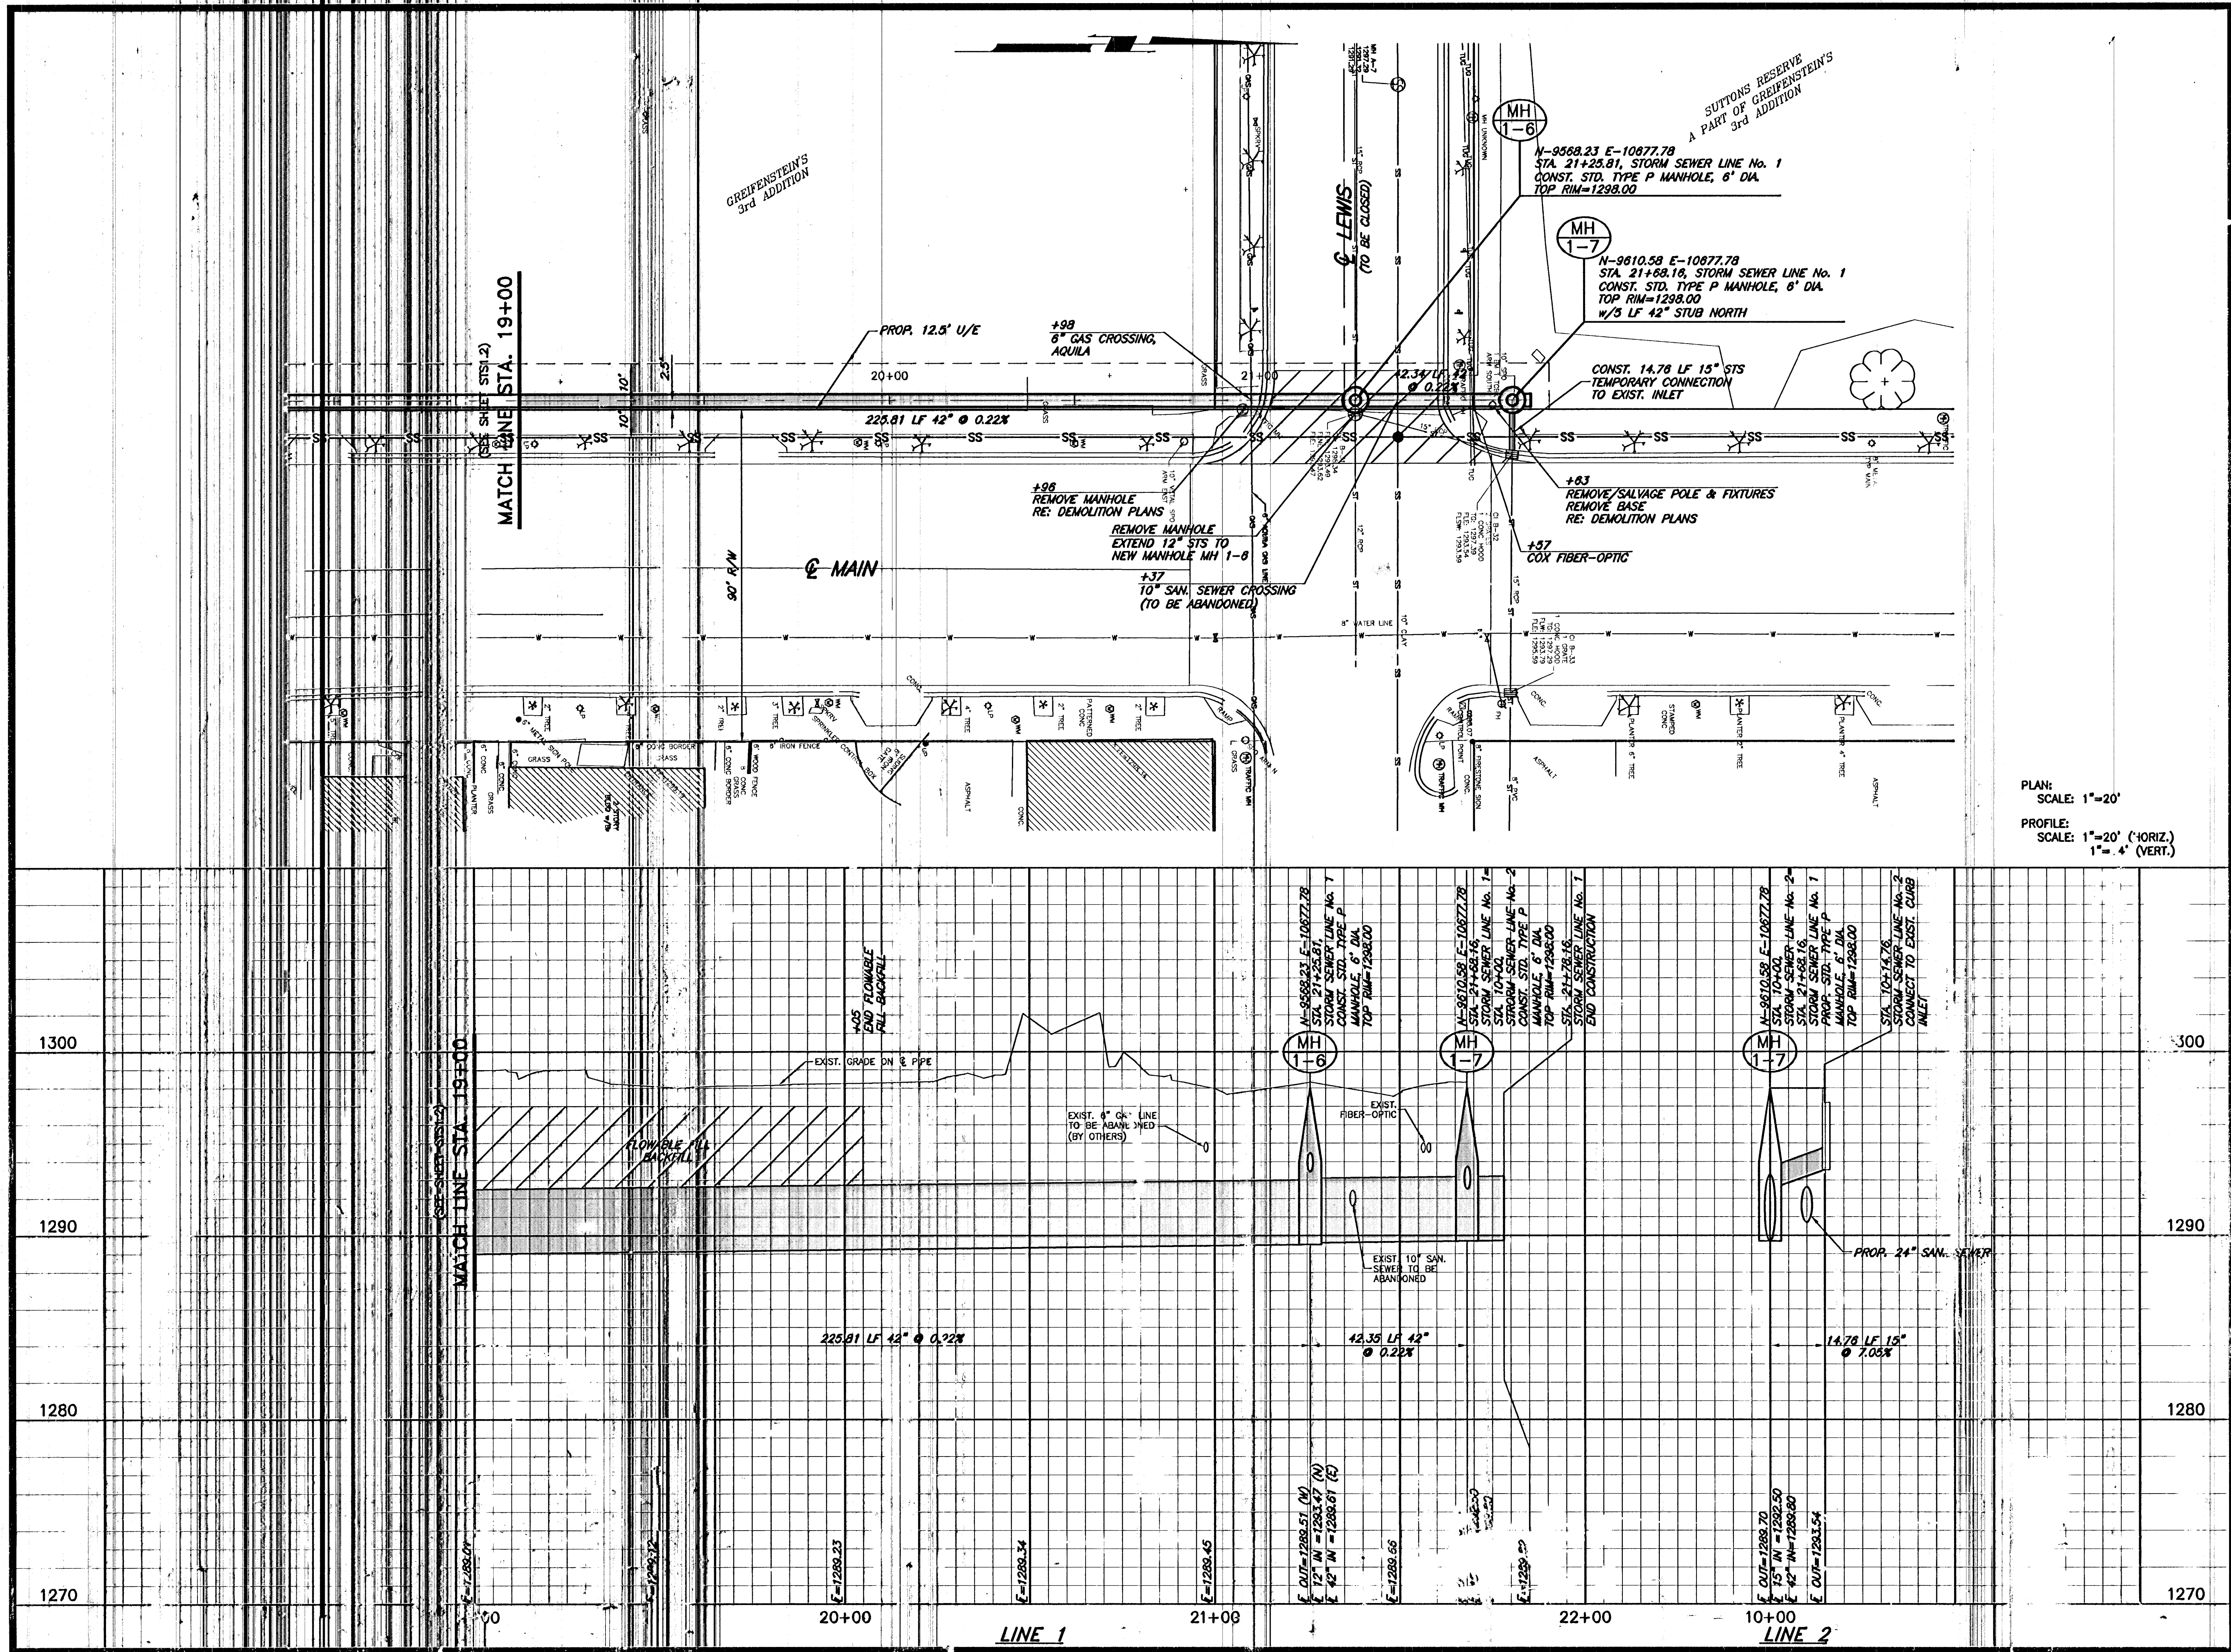

GossenLivingston

Architecture
420 South Emporia
Wichita, KS 67202
Tel: (316) 265-9367
Fax: (316) 265-5649
Email: architecture@glj.net

© 2005 Gossen Livingston Associates, Inc.


The drawing and information herein is the exclusive property of Gossen Livingston Associates, Inc. and is not to be copied or used in any way without the prior written consent of Gossen Livingston Associates, Inc. All drawings, specifications, ideas, designs and arrangements appearing herein constitute the original and unpublished work of art.

Gossen Livingston Associates, Inc.



Johnson & Associates, Inc.
100 E. California Ave., 7th Floor
Oklahoma City, OK 73104
(405) 235-8075 FAX (405) 235-8078

Certificate of Authorization #E-1128 EXP. DATE: 12-31-2008

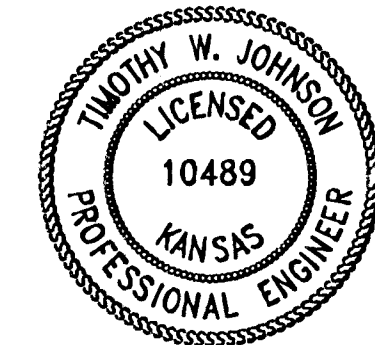

WICHITA
WATERWALK

**PUBLIC
IMPROVEMENTS
PHASE 2
PACKAGE 1**

Work	Date	Description

STORM SEWER No. 1

Job No.	ST1.3
Date	12-30-05
Drawn	SE
Checked	22
	24