



6:\CTVAL\9210\9210-3A.DWG Tue May 11 15:27:48 1995

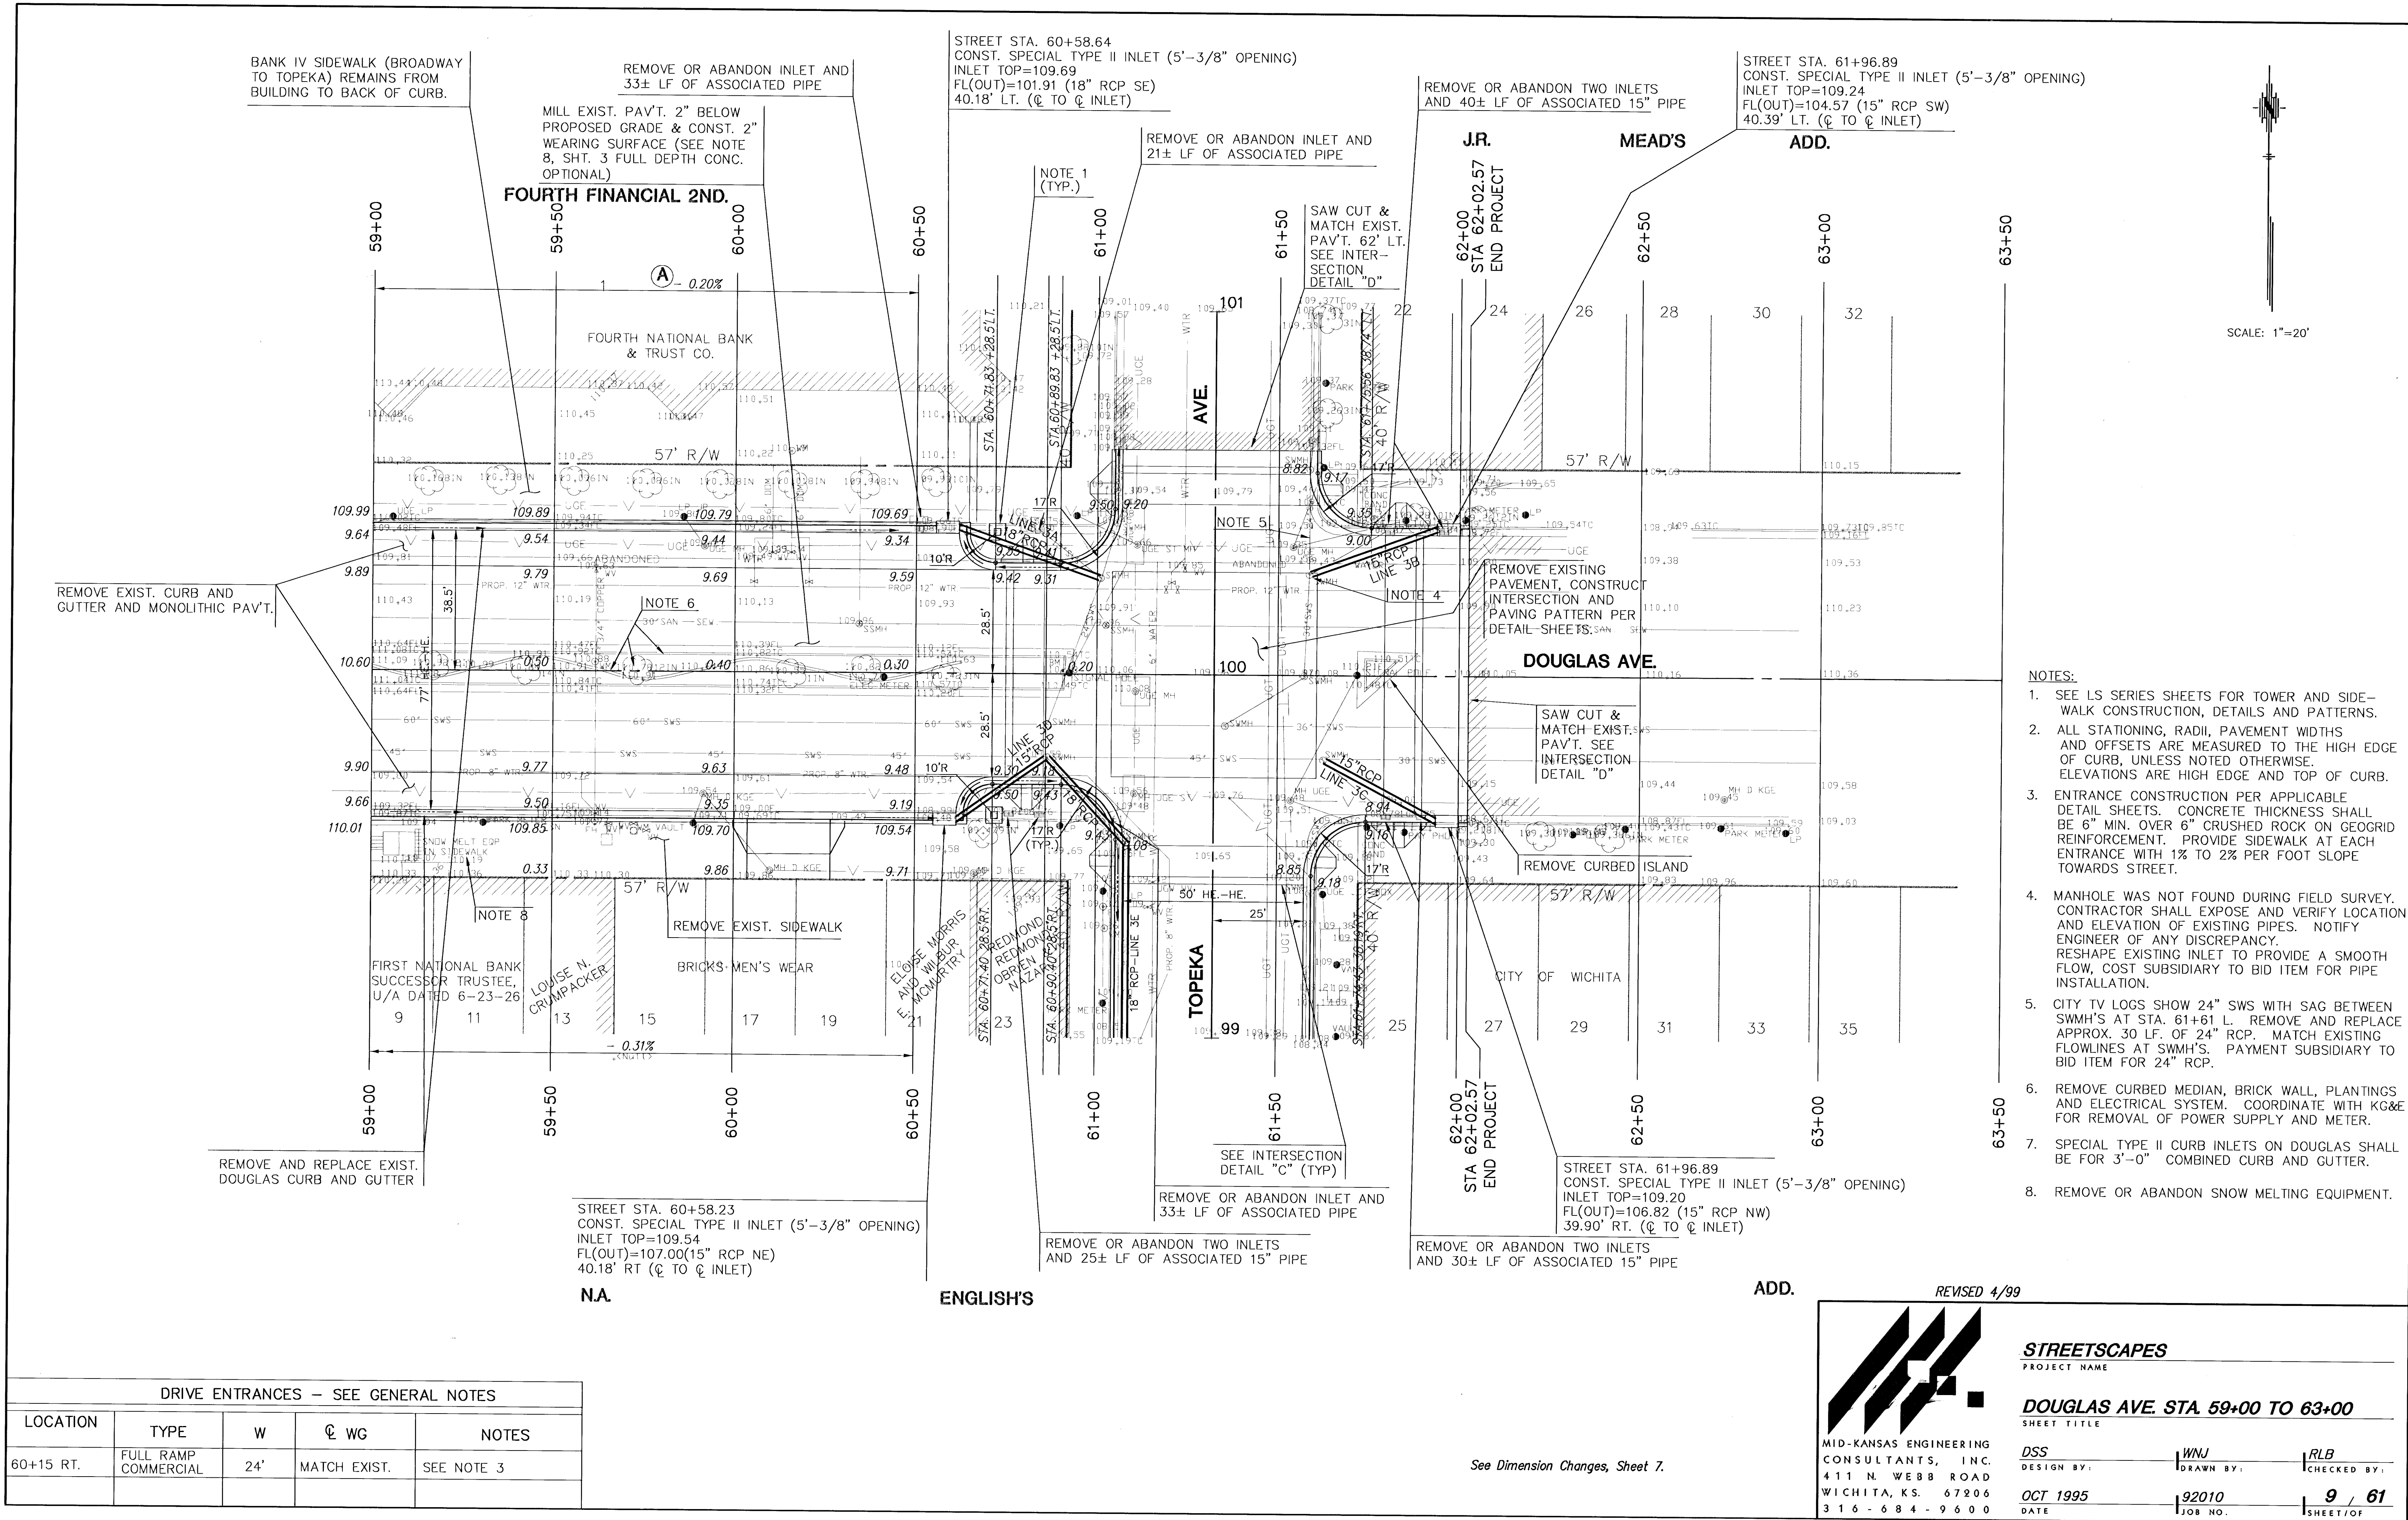

DRIVE ENTRANCES - SEE GENERAL NOTES				
LOCATION	TYPE	W	℄ WG	NOTES
60+15 RT.	FULL RAMP COMMERCIAL	24'	MATCH EXIST.	SEE NOTE 3

See Dimension Changes, Sheet 7.

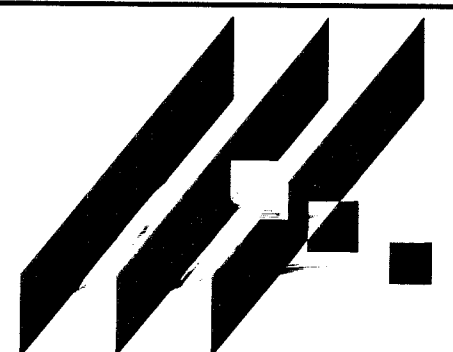

MID-KANSAS ENGINEERING
CONSULTANTS, INC.
411 N. WEBB ROAD
WICHITA, KS. 67206
316-684-9600

REVISD 4/99

STREETSCAPES
PROJECT NAME

DOUGLAS AVE. STA. 59+00 TO 63+00
SHEET TITLE

DESIGN BY:	WNJ	CHECKED BY:	RLB
OCT 1995	92010	9 / 61	SHEET/OF