
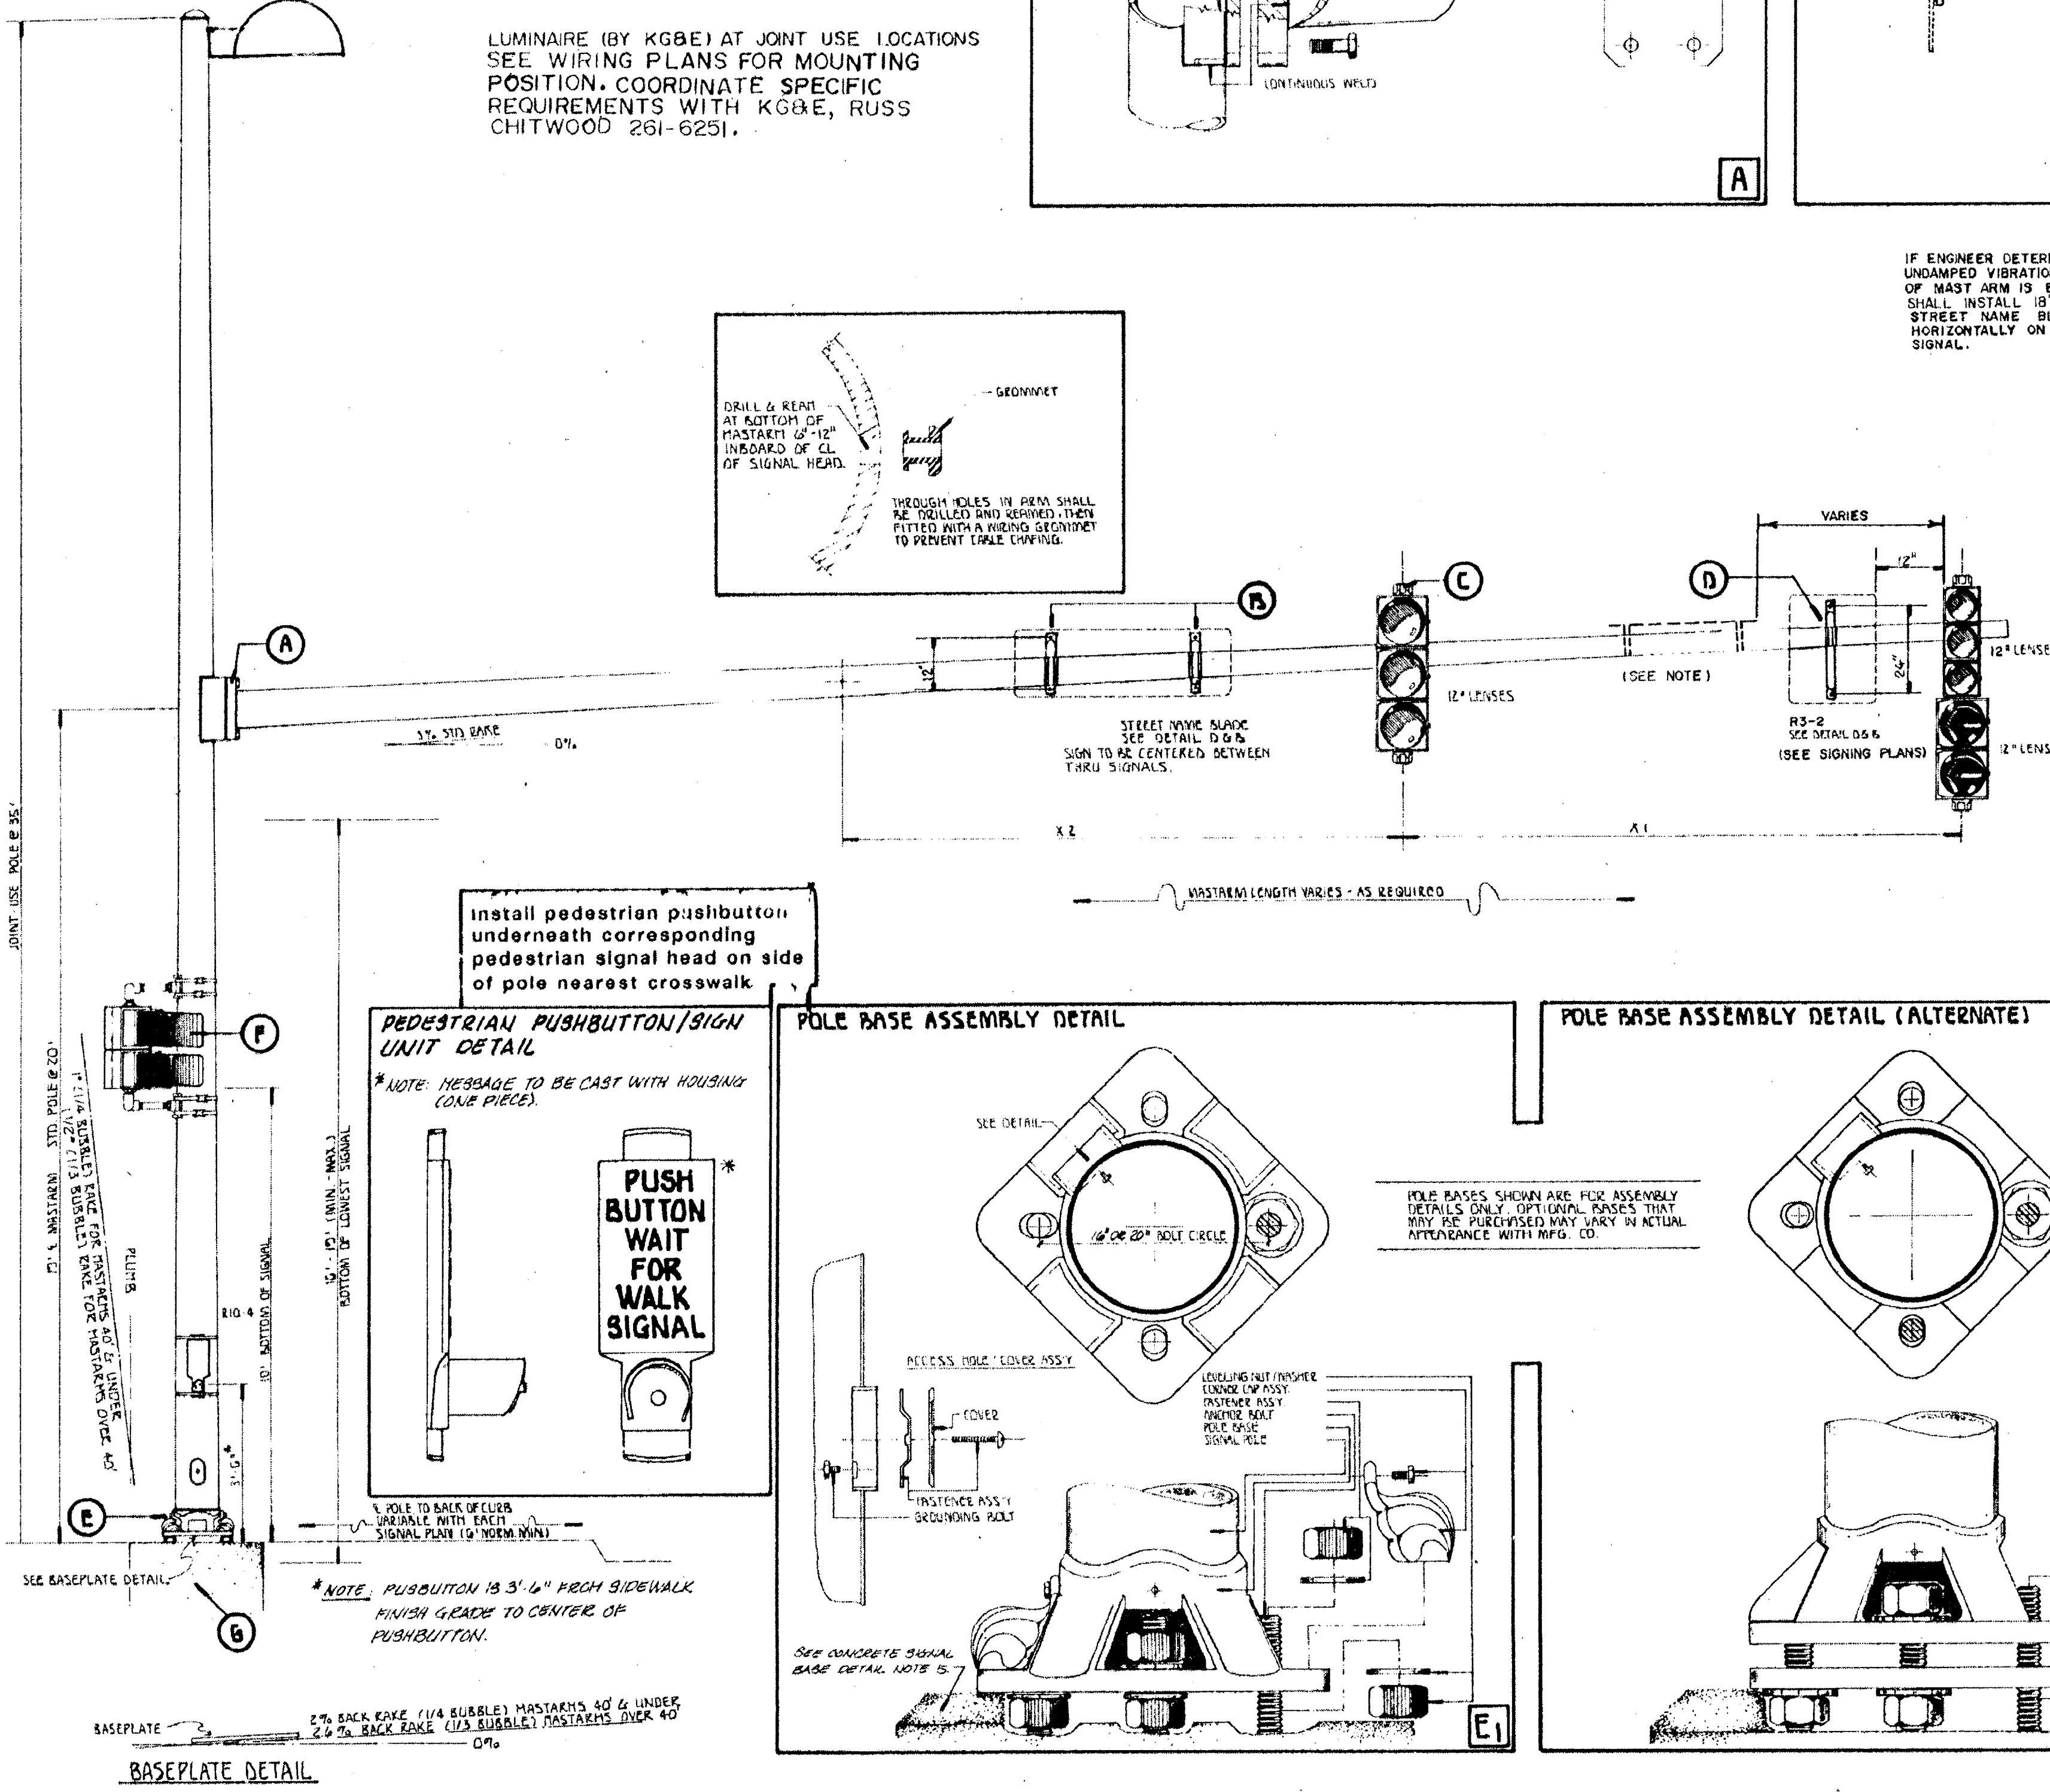
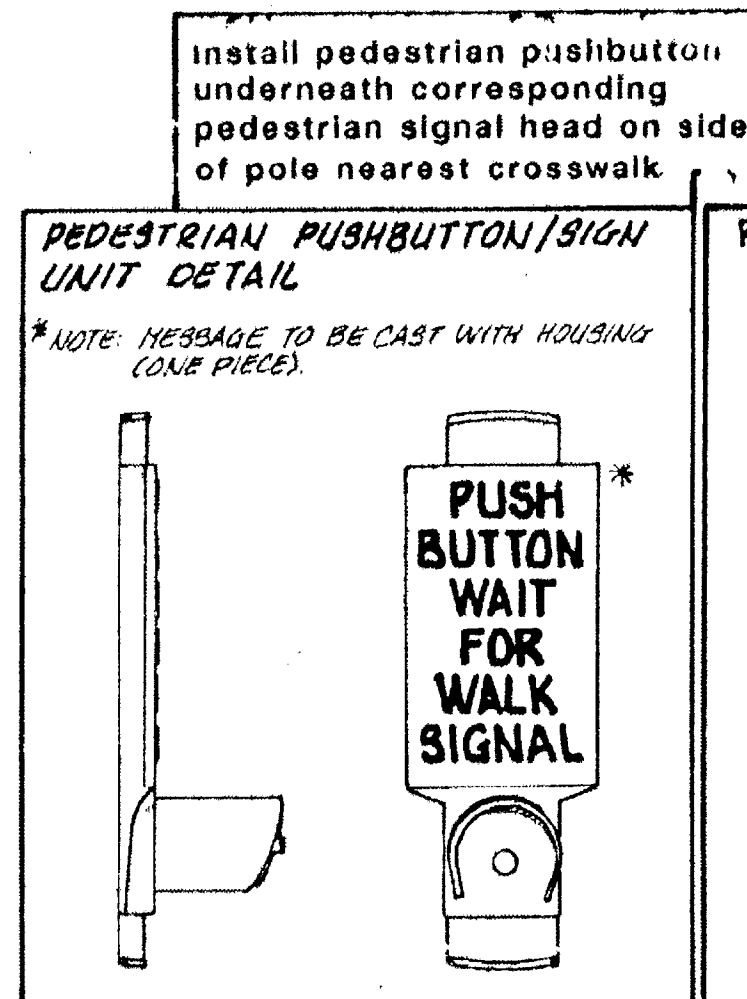
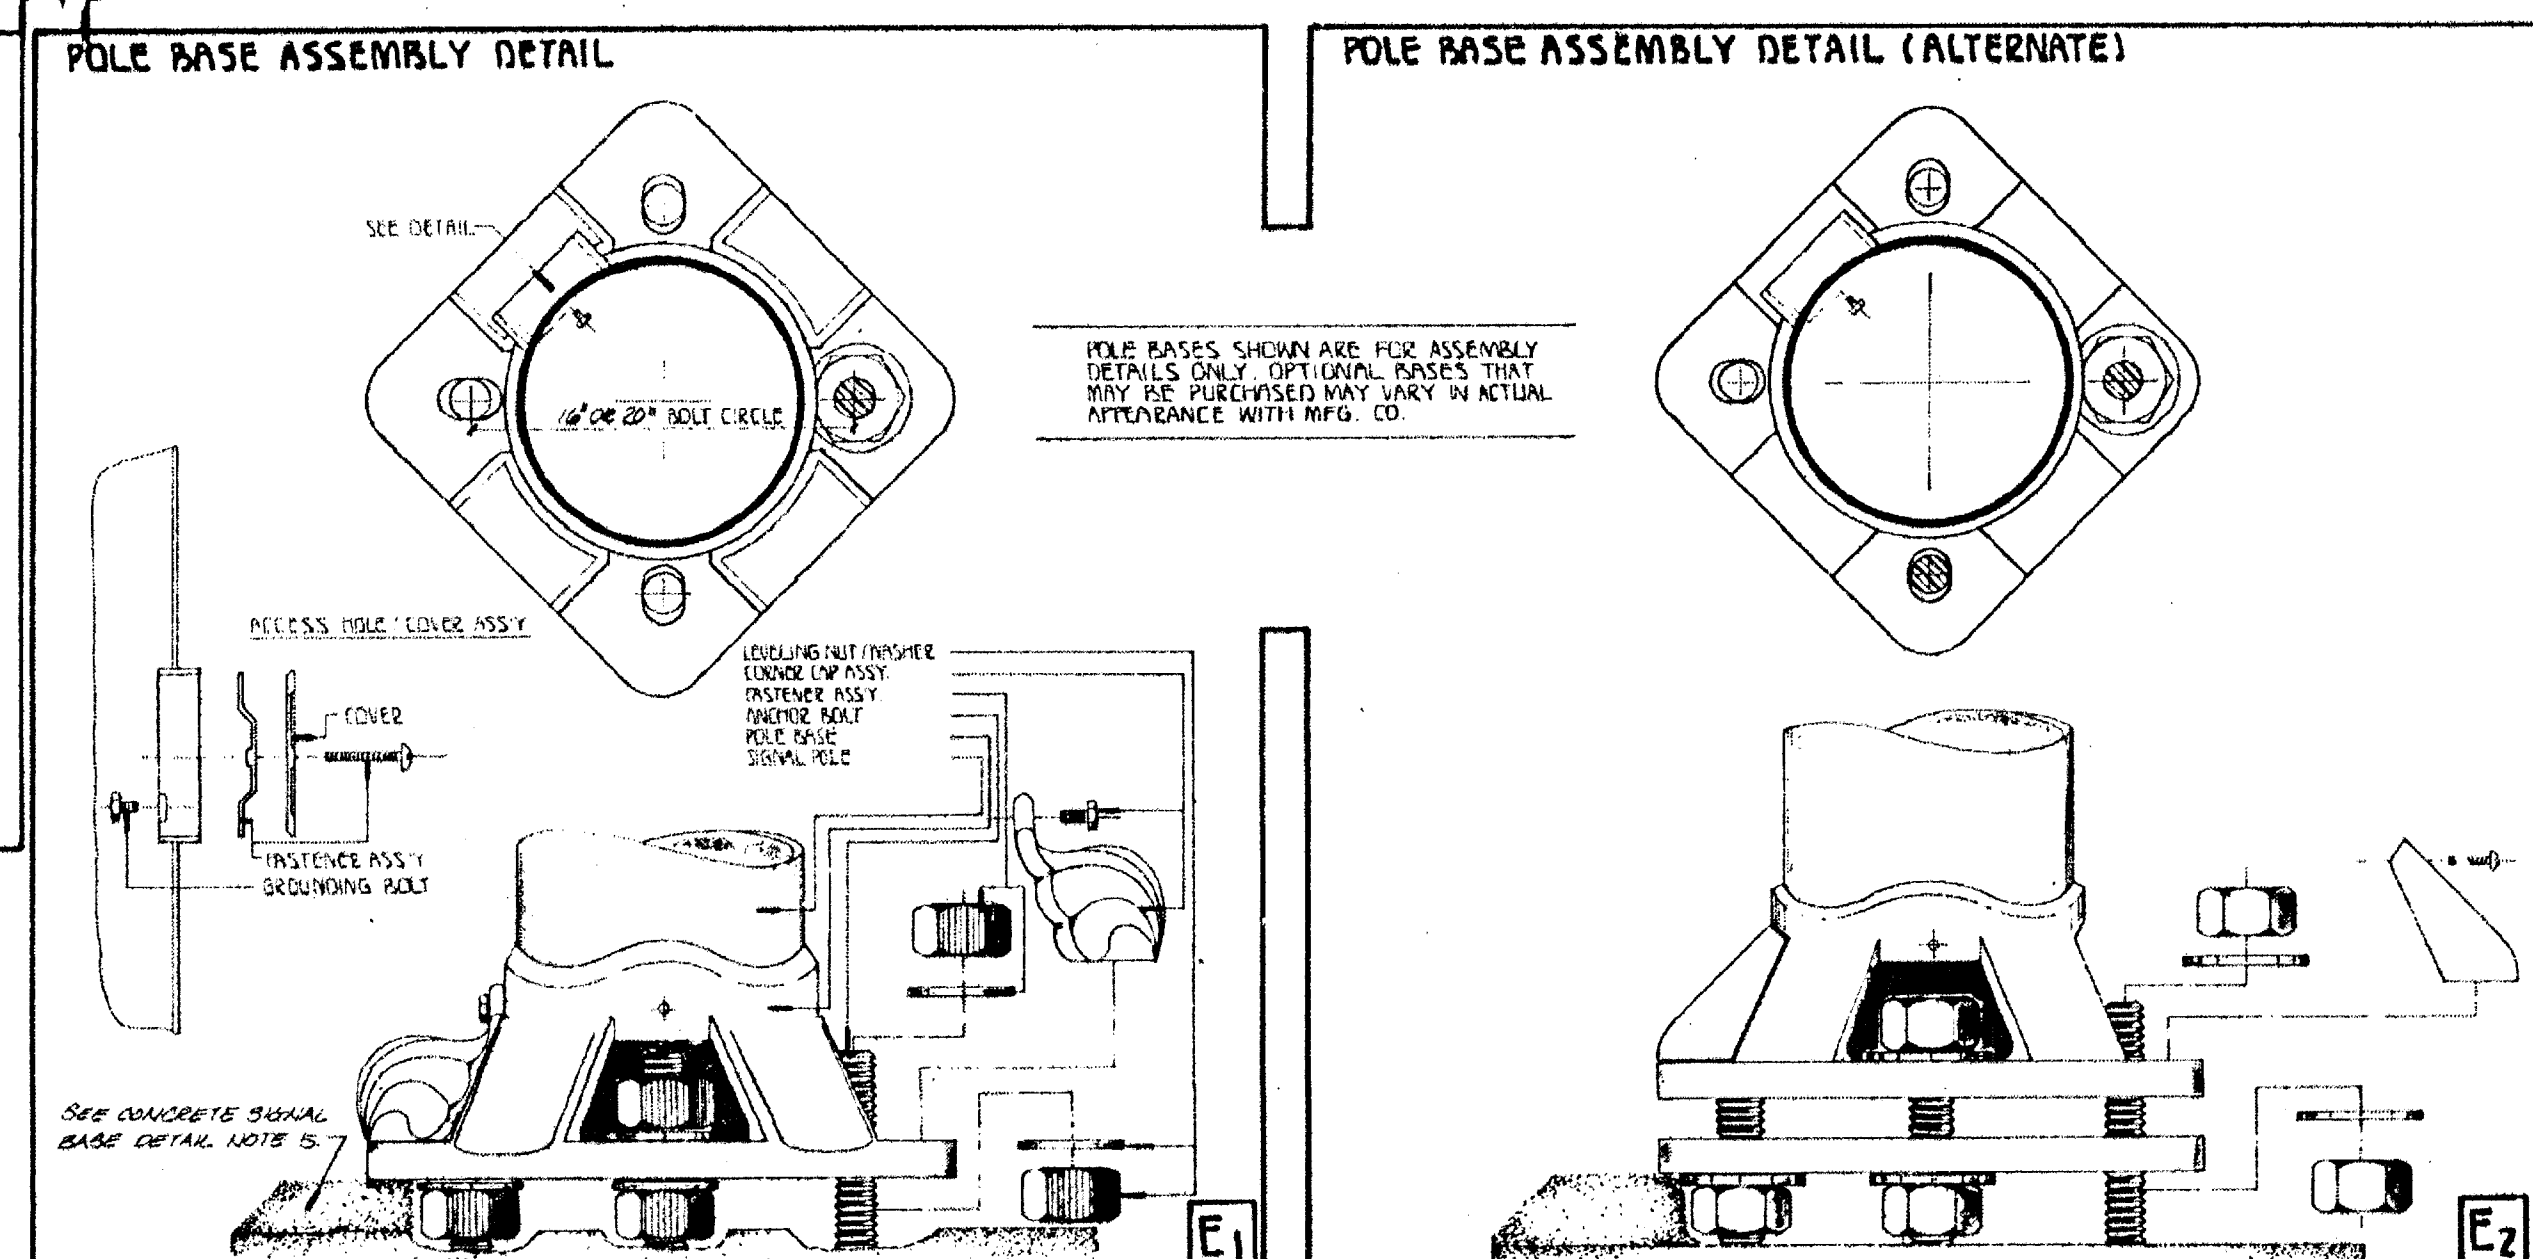
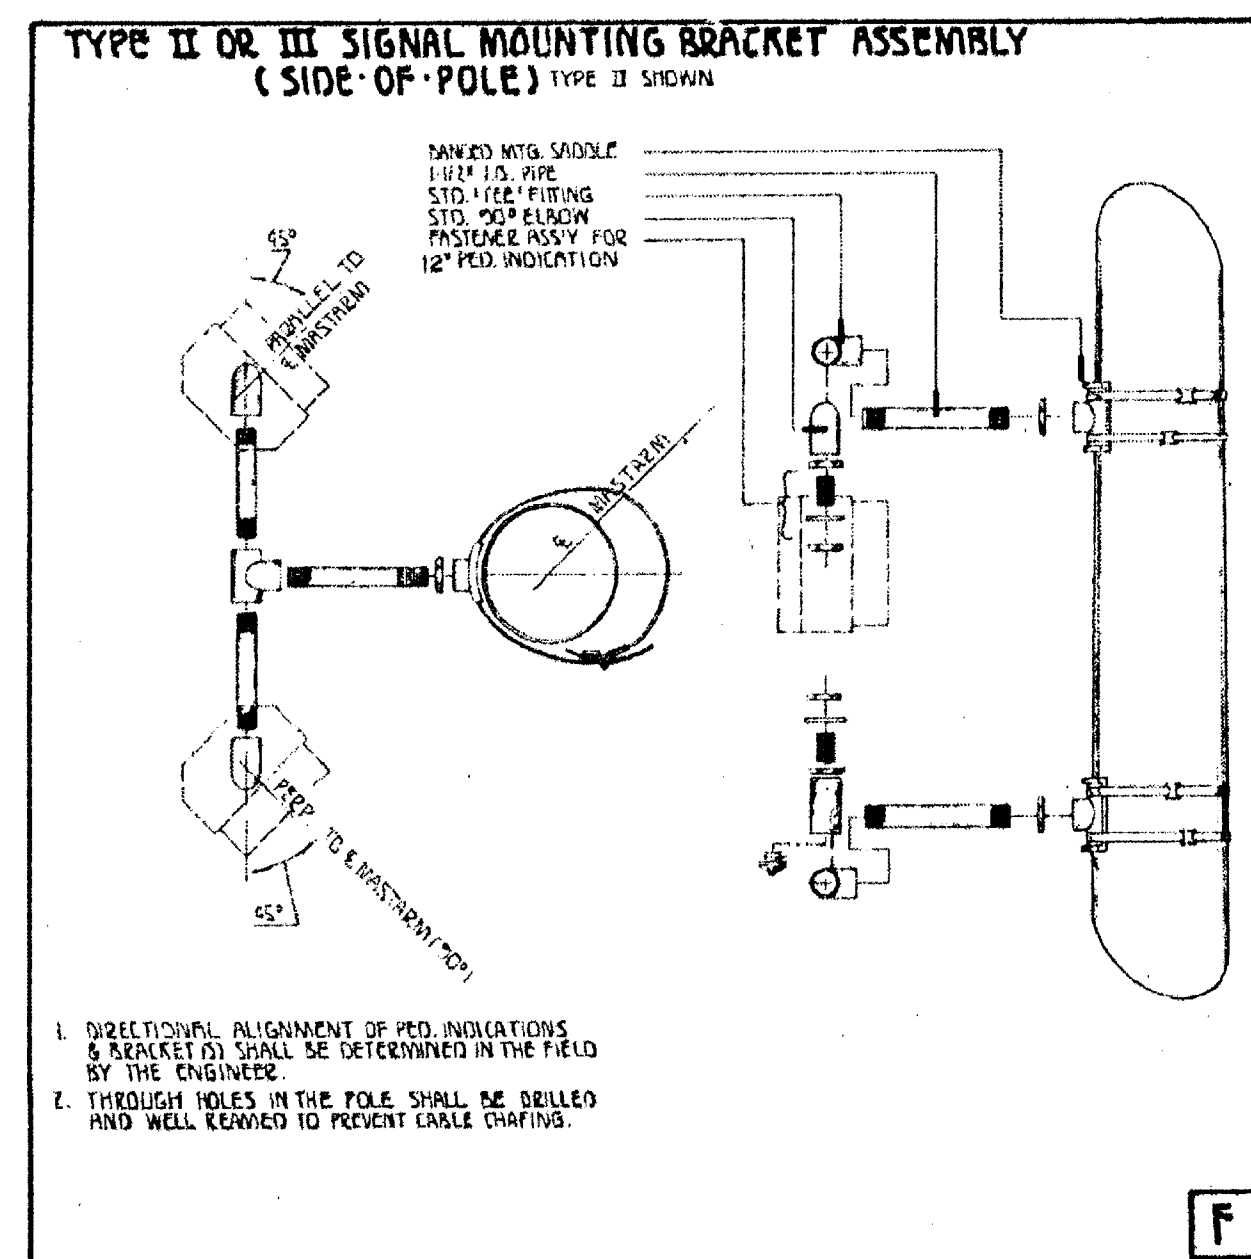
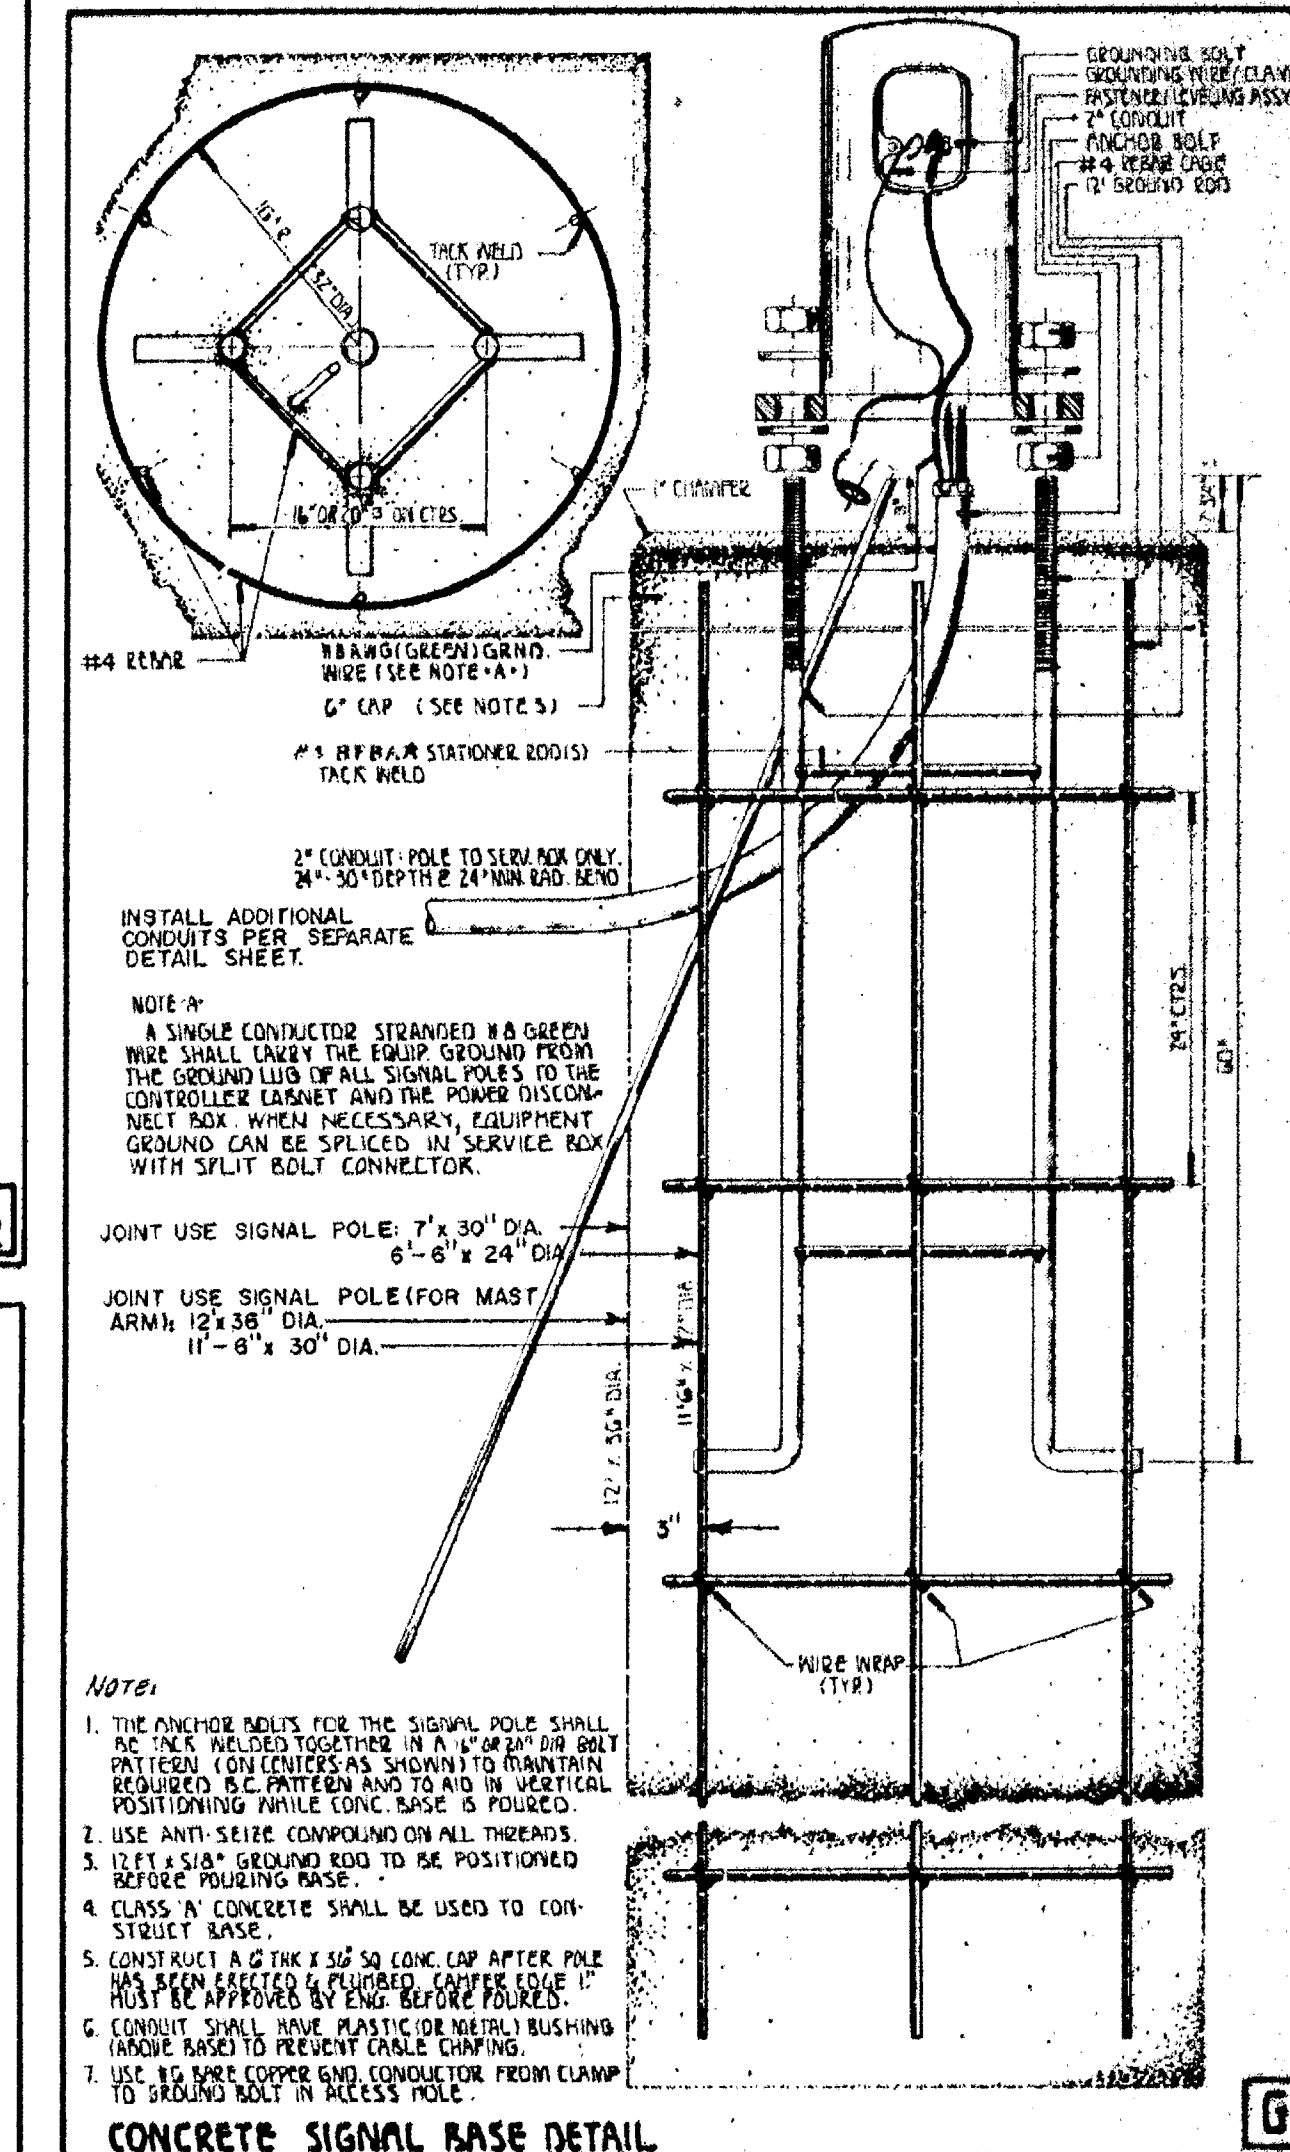
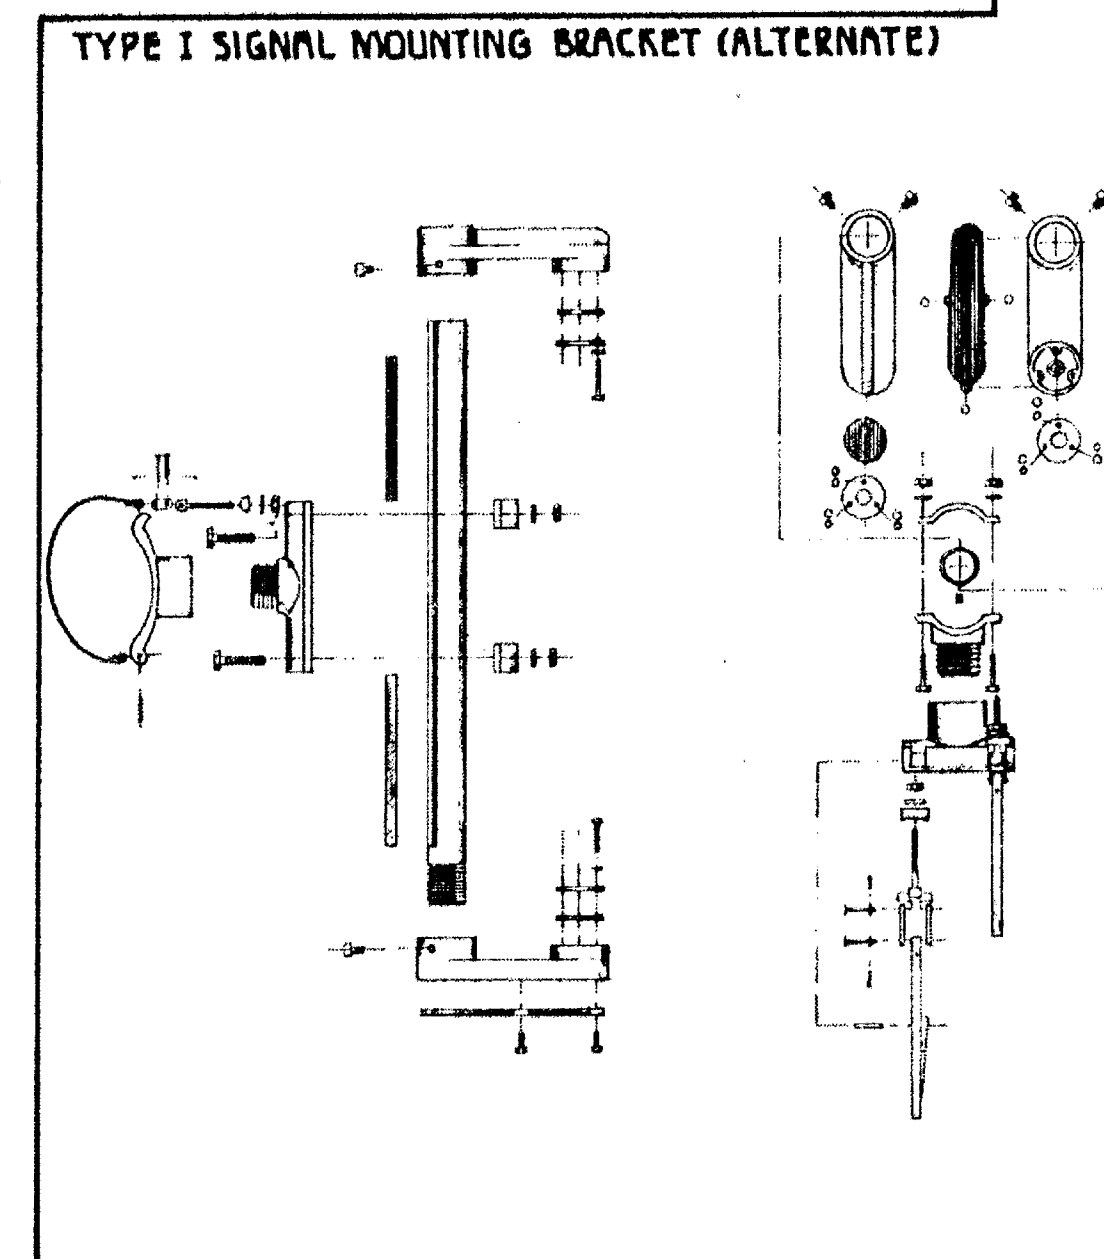
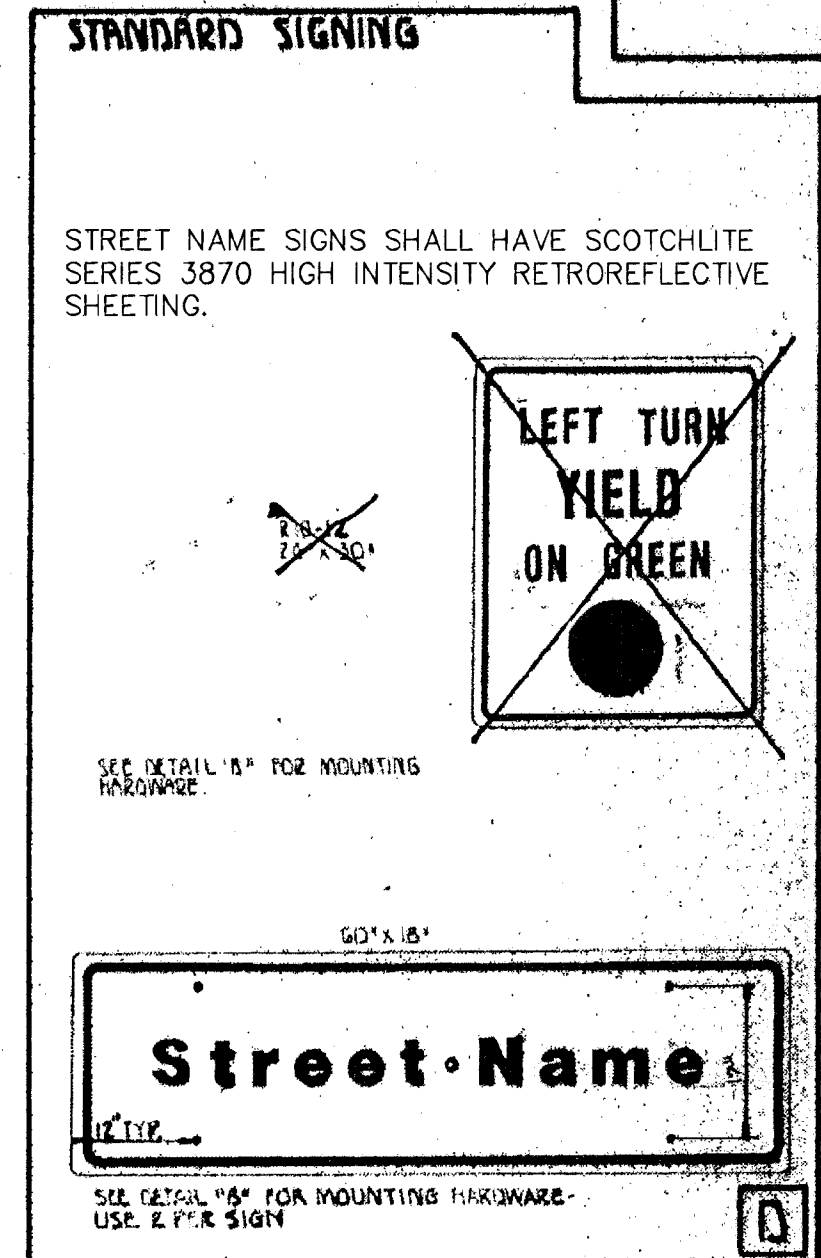
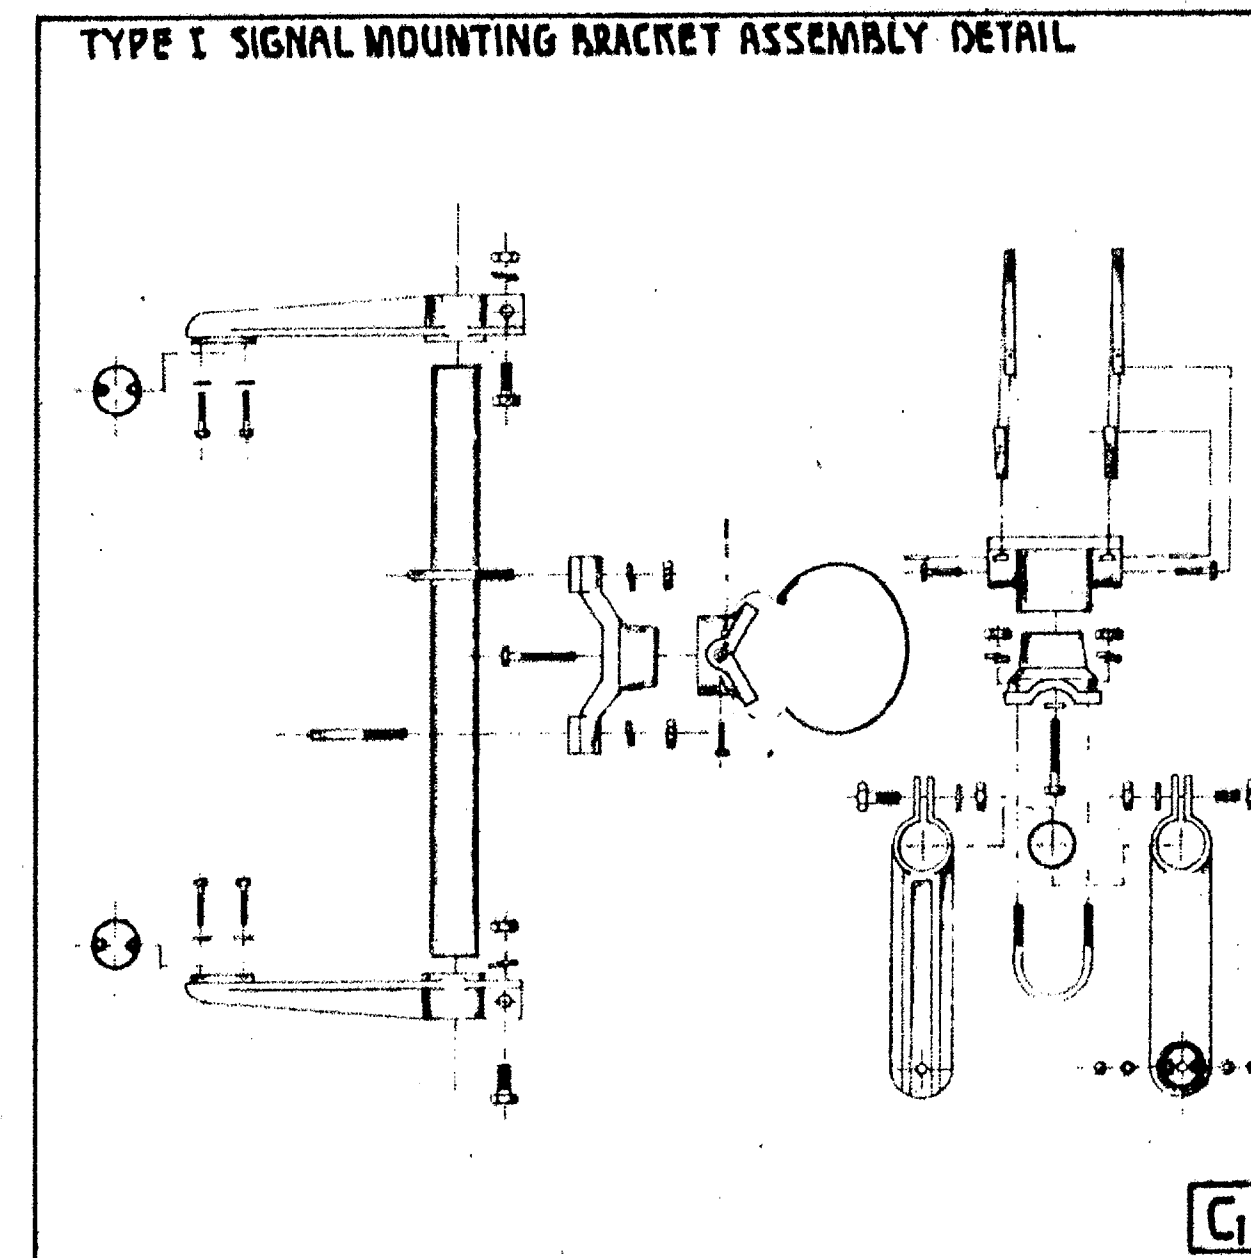
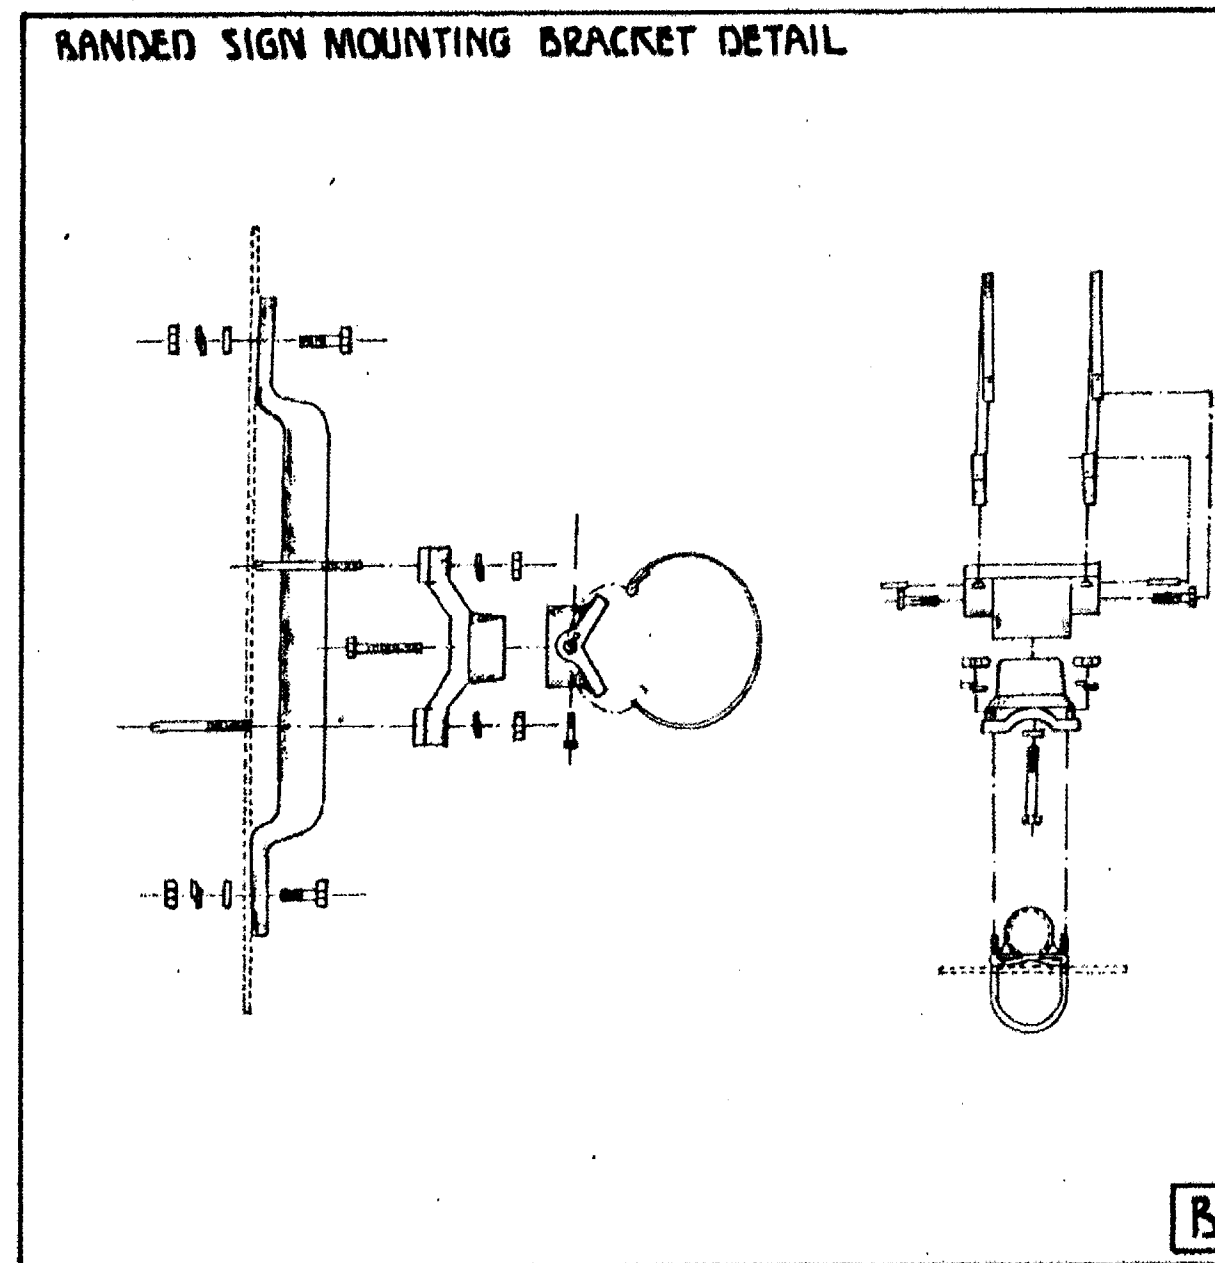


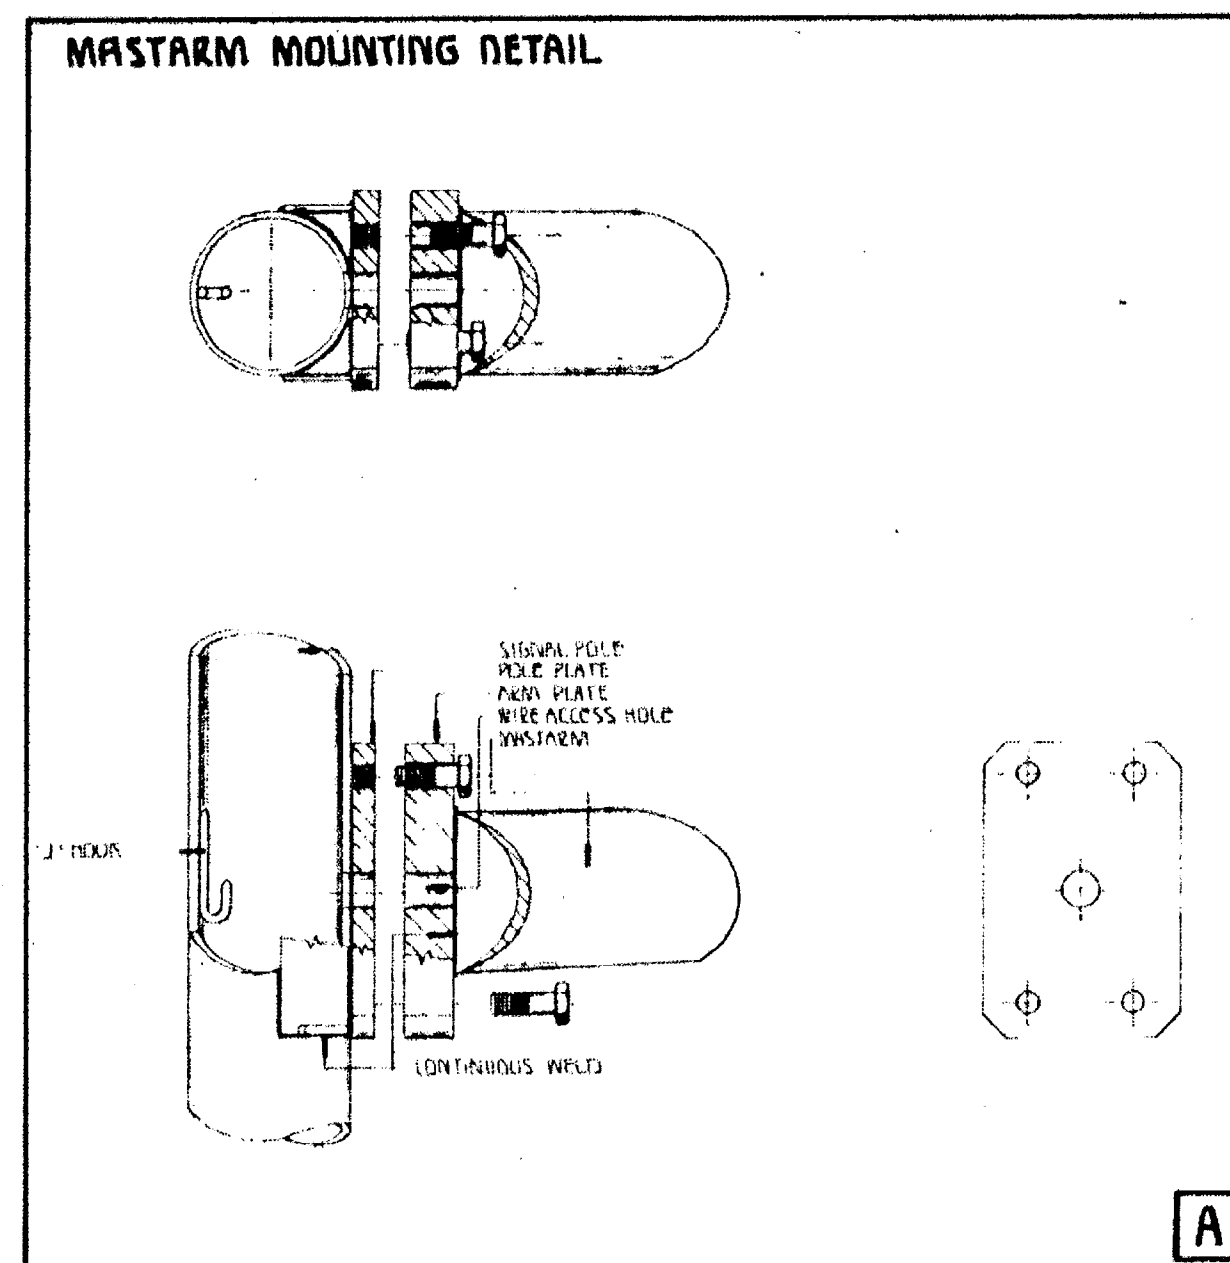

PROJECT DESCRIPTION		
STEEL SIGNAL POLE ASSEMBLY DETAILS		
PROJECT NUMBER		
ADDS NO. DRAWN BY <u>SEAL</u>	APPROVED BY 	DATE <u>AUG. 63</u> REVISED
CITY OF WICHITA DEPARTMENT OF PUBLIC WORKS		
