




6 POST PENETRATION
1" = 1'-0"

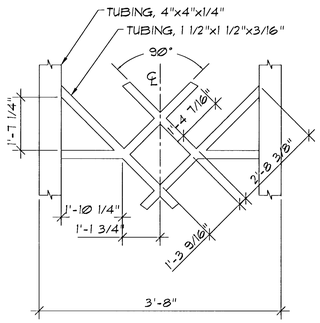


7 LATTICE PATTERN
1" = 1'-0"

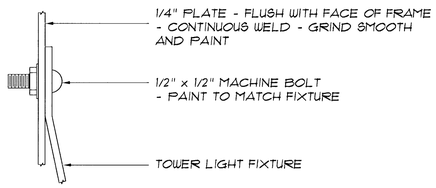


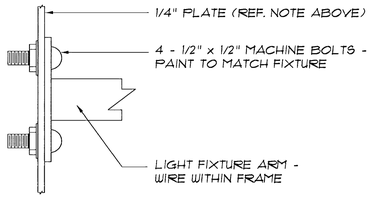


8 LIGHT FIXTURE CONNECTIONS
NTS

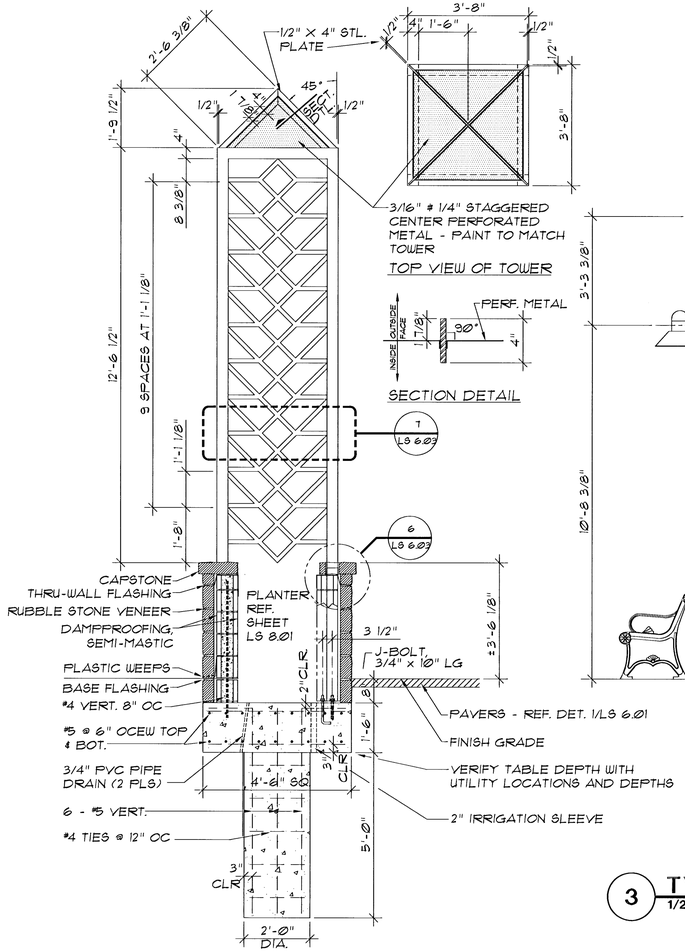


4 TYPICAL SECTION
1/2" = 1'-0"

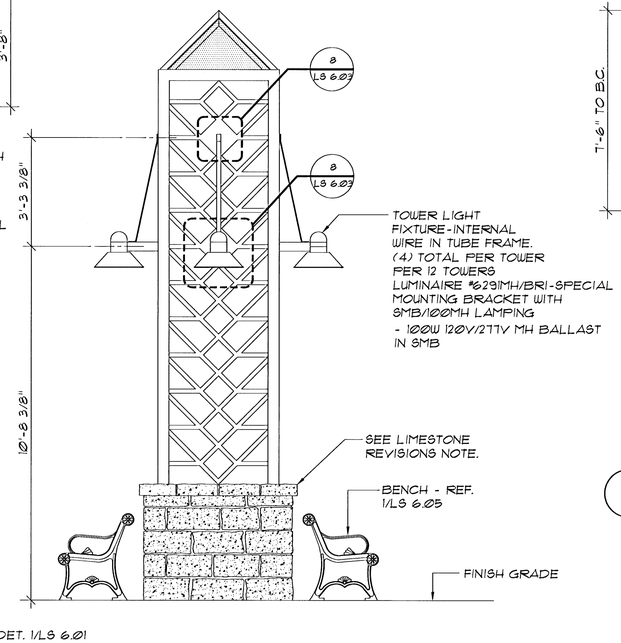


3 TYPICAL ELEVATION
1/2" = 1'-0"

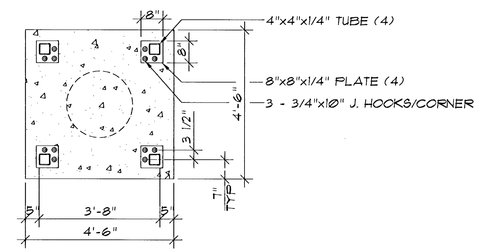

5 FOUNDATION PLAN
1/2" = 1'-0"

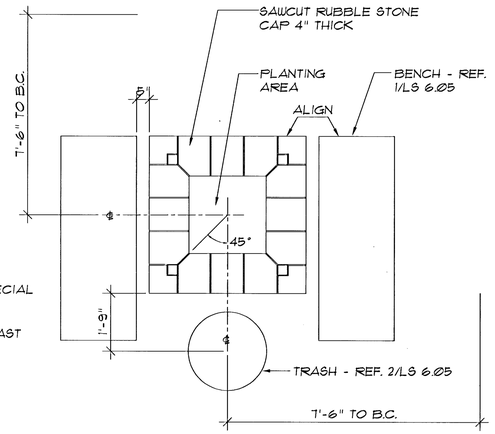

1 FURNITURE LAYOUT
1/2" = 1'-0"

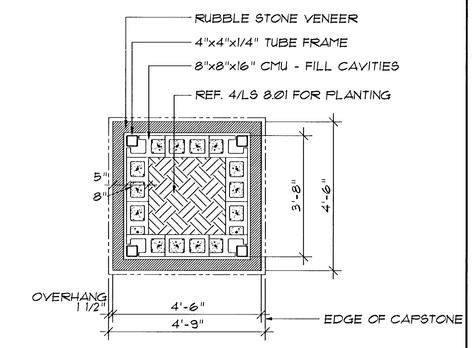

2 WALL PLAN
1/2" = 1'-0"

LIMESTONE REVISIONS NOTE:

Annotations to Specifications, Section Ø4210 Stone Masonry Work, Part 2.00 Materials, 2.01 Limestone, and Drawings Sheet LS 6.03.

In lieu of Rubble Limestone, the stone veneer pattern is to be of approximately equal 8" height horizontal courses, with random 12" to 18" ± face lengths with staggered vertical joints. Texture of face and ends where exposed shall be Natural Cleft, Pitched Face. Bed thickness to nominal 3 3/4"-4".

In lieu of the 4" height (vertical dimension) cap stone, provide 8" height cap stone, with Natural Cleft, Pitched Face, texture on face, and ends where exposed. Texture on top surface of cap stone to be Natural Cleft, Pitched Face if possiblet or Split Face is acceptable on the top surface. The face of the cap stone is to be in approximately the same plane as the stone face below versus the 1 1/2" overhang as detailed.

Submit shop drawings of the stone veneer tower bases for approval.

Samples: Submit a minimum of two sets of samples approximately 6"x6" in size. Each set is to include the full range of exposed color and texture to be expected in the completed work.

Other provisions of section Ø4210 are unchanged.

Revised 4/99

the swa group
Landscape Architecture
Site Planning
Urban Design
2211 N. Lamar, Suite 400
Dallas, TX 75202
214-954-0016

MID-KANSAS ENGINEERING CONSULTANTS, INC.
411 N. WEBB ROAD
WICHITA, KS. 67206
316-684-9600

DOUGLAS STREETSCAPES
PROJECT NAME

TOWER DETAILS
SHEET TITLE

DESIGN BY:	DRAWN BY:	CHECKED BY:
DT	PM, EM, LJ	JM

DATE	JOB NO.	SHEET/OF
OCT '95	SWA MKC-251	LS 6.03

G:\CIVIL\9210\SWA\LS603.DWG Tue May 11 15:59:40 1999