



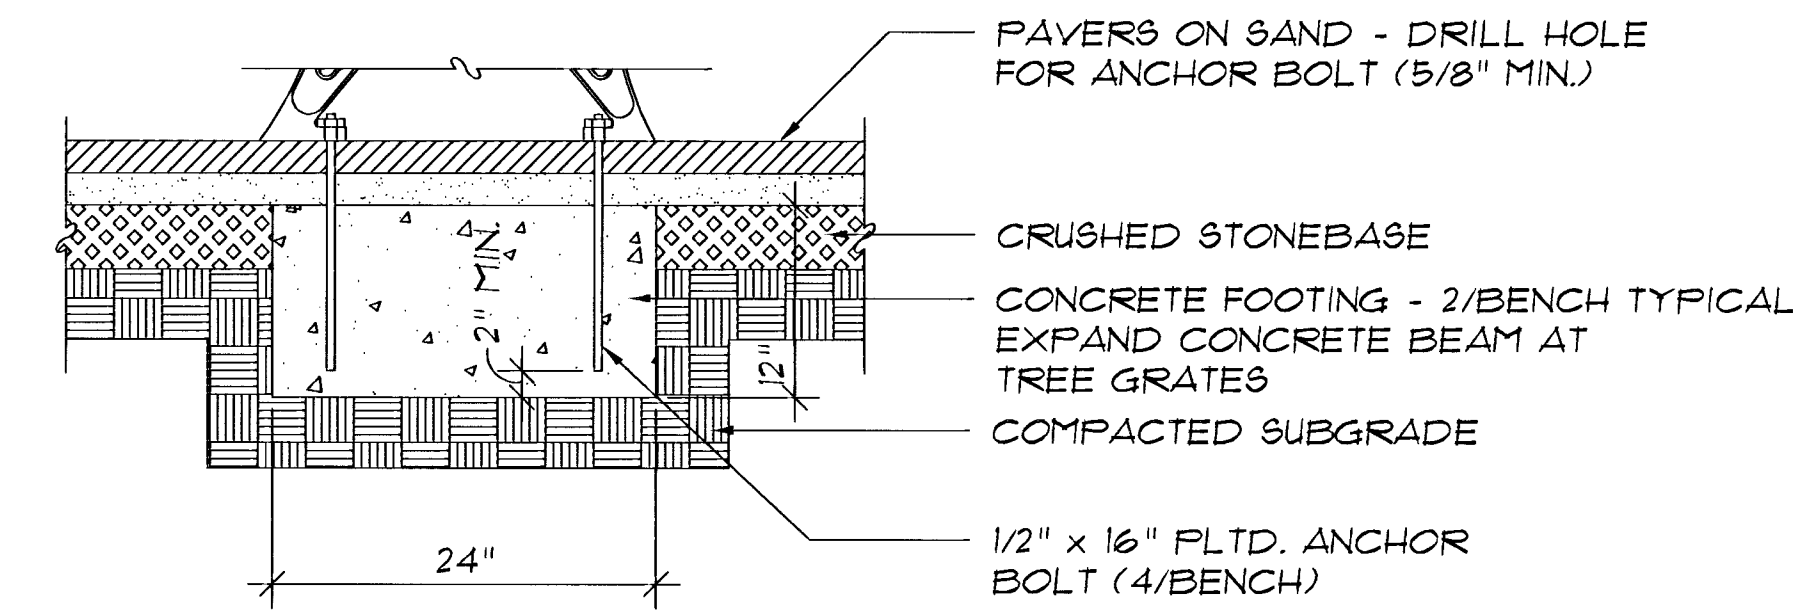

BENCH

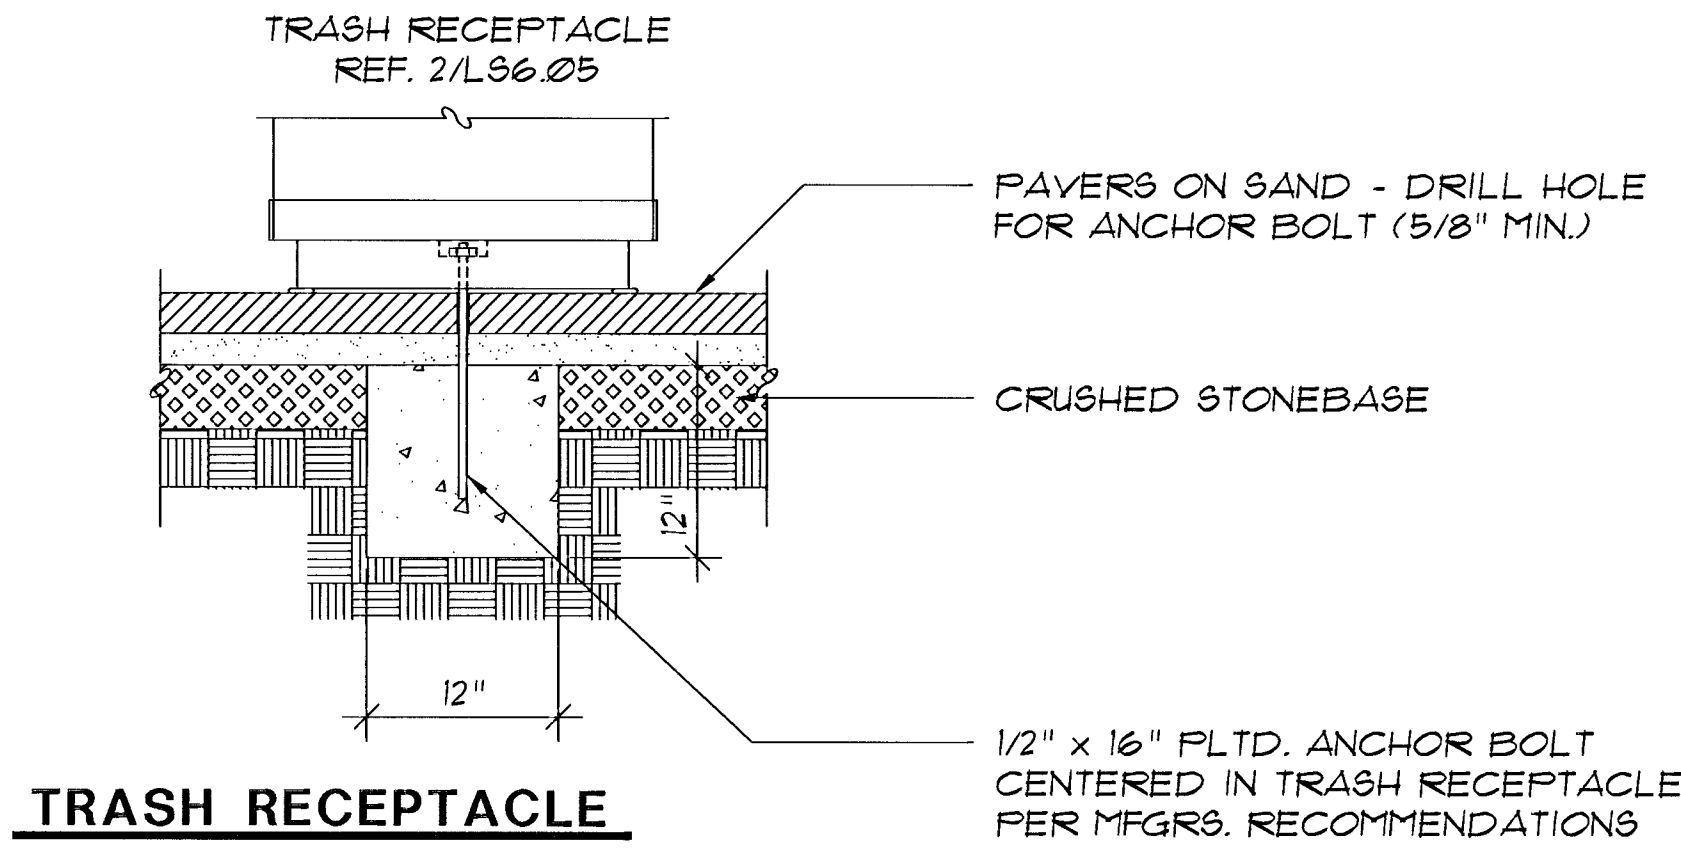

TRASH RECEPTACLE

4 MOUNTING DETAILS
1" = 1'-0"

CHANGES TO STREET FURNISHINGS LAYOUT

In lieu of Newspaper Stand Enclosure and Trash Receptacle locations and quantities shown on Sheets LS 101, 102, & 103, provide as follows:

Newspaper Stand Enclosures
Furnish and install 12 each double unit enclosures and 2 each single unit enclosures at project area locations as directed by the Engineer.

* Furnish and deliver to the City, 2 each double unit enclosures and 2 each single unit enclosures.

Trash Receptacle


* Furnish and deliver to the City, 2 each new trash enclosures.

Furnish and install 4 each new trash enclosures at project location shown below.


Remove and install 12 each existing trash enclosures at project location shown below.

LOCATION	INSTALL NEW	REINSTALL EXISTING
DOUGLAS & MAIN NE		1
DOUGLAS & MAIN SE	1	
MAIN TO MARKET MIDPOINT, LEFT		1
MAIN TO MARKET MIDPOINT, RIGHT		1
DOUGLAS & MARKET NW	1	
DOUGLAS & MARKET NE	1	
DOUGLAS & MARKET SE		1
DOUGLAS & MARKET SW		1
DOUGLAS & BROADWAY NW		1
DOUGLAS & BROADWAY NE		1
DOUGLAS & BROADWAY SE		1
DOUGLAS & BROADWAY SW		1
DOUGLAS & TOFEKA NW		1
DOUGLAS & TOFEKA NE		1
DOUGLAS & TOFEKA SE	1	
DOUGLAS & TOFEKA SW		1




* These are to be delivered assembled to the City's Central Maintenance Facility (CMF) at 1801 S. McLean. Contact Mike Hampel at 268-4079 to coordinate delivery of the items.

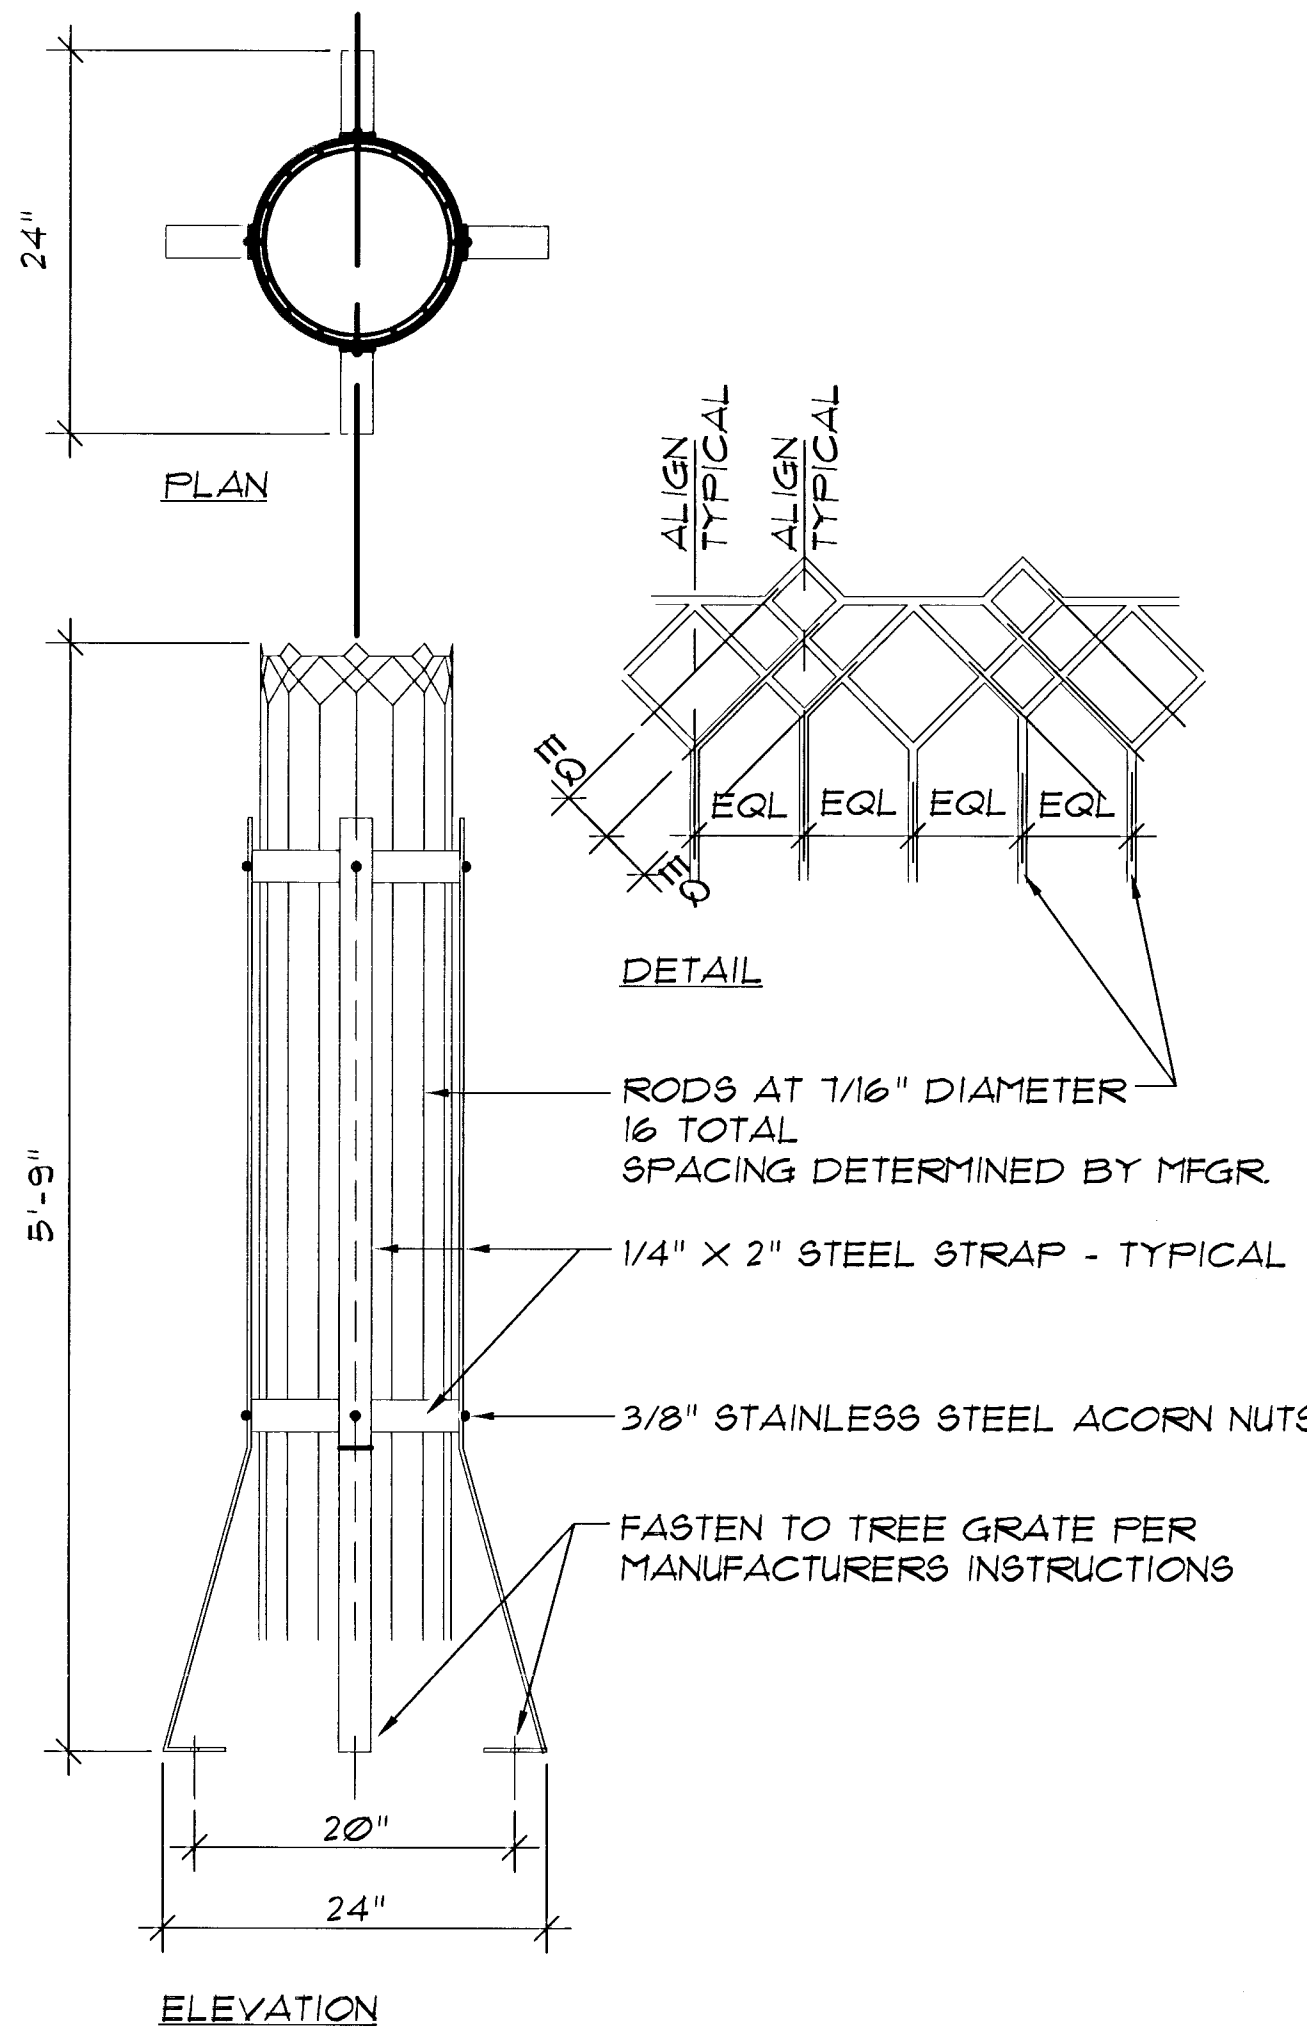

3 TREE GUARD
1" = 1'-0"

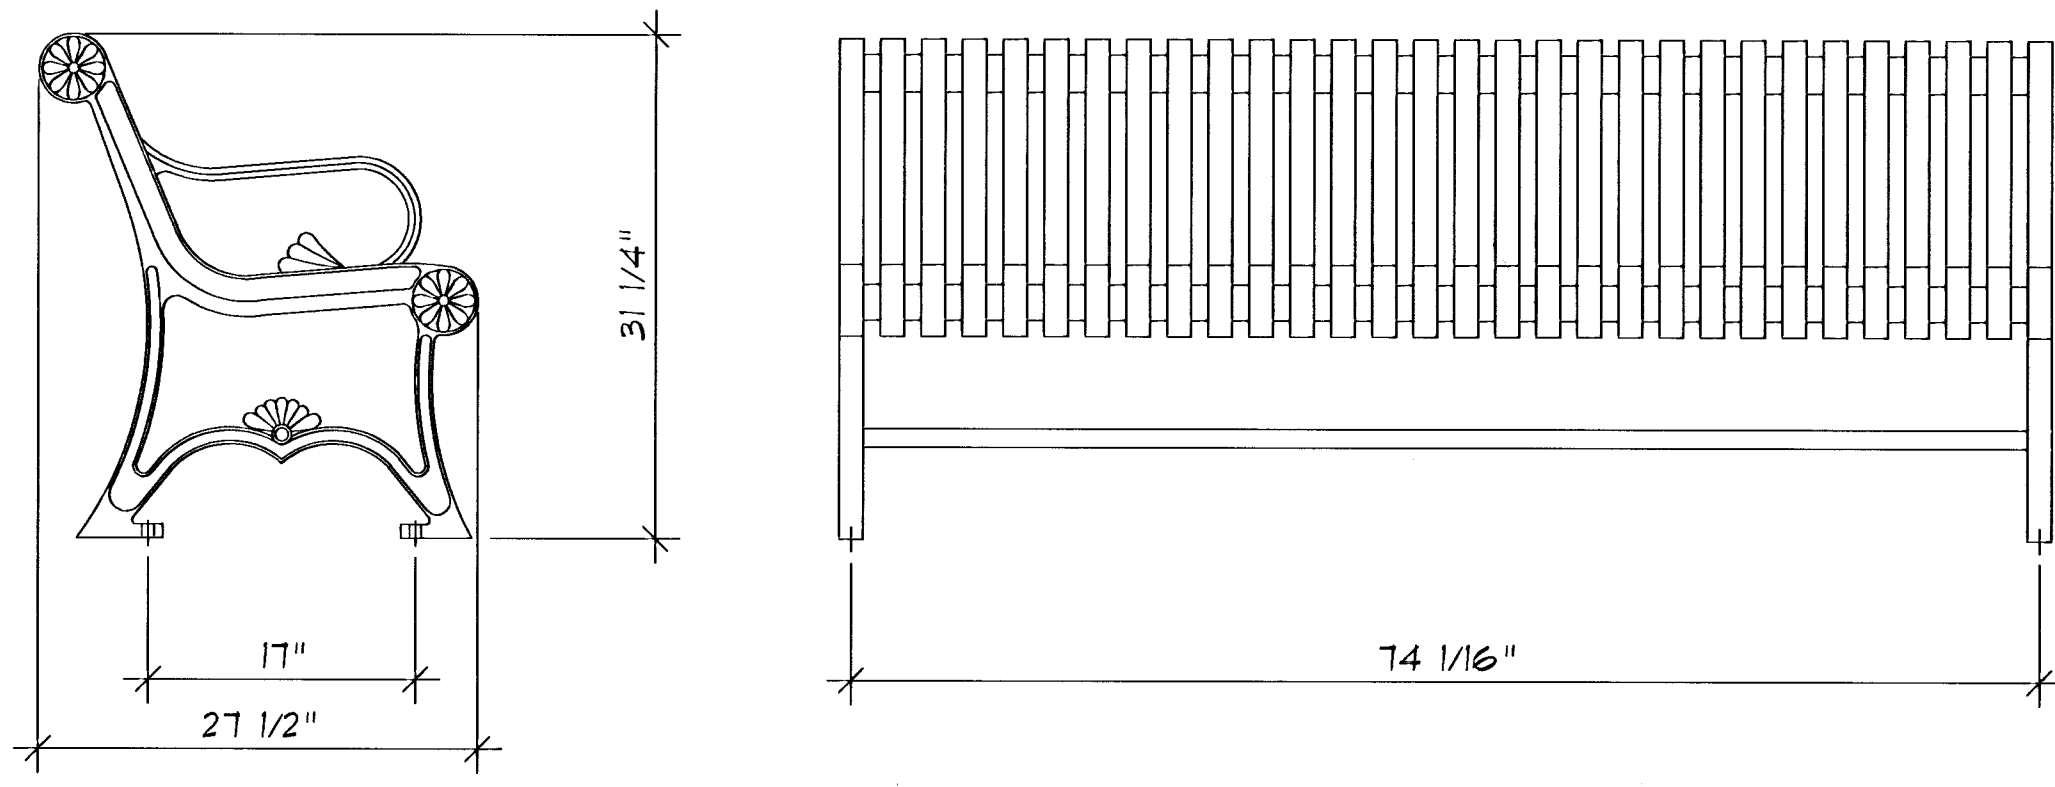

1 BENCH SECTION/ELEVATION
1" = 1'-0"

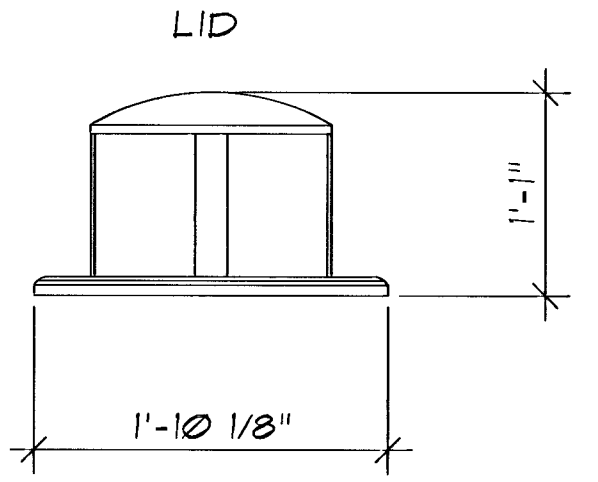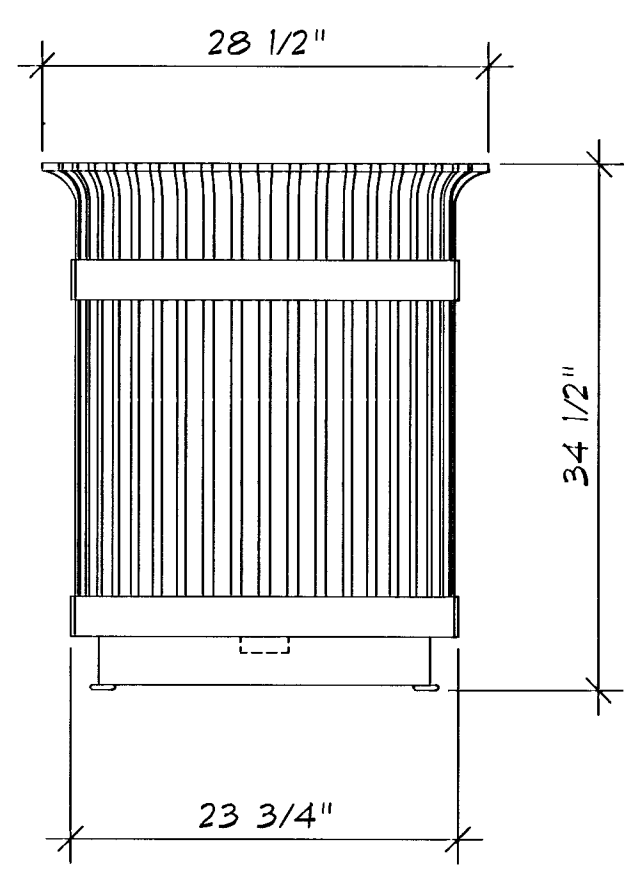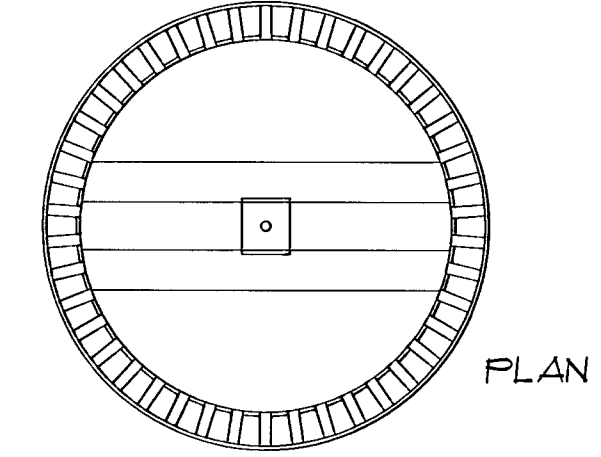


2 TRASH RECEPTACLE
1" = 1'-0"

Revised 4/99

the swa group

Landscape Architecture 2211 N. Lamar, Suite 400
Site Planning Dallas, TX 75202
Urban Design 214-954-0016

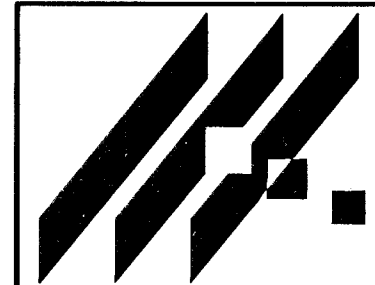

DOUGLAS STREETSCAPES

PROJECT NAME

STREET FURNISHINGS DETAILS

SHEET TITLE

MID-KANSAS ENGINEERING
CONSULTANTS, INC.
411 N. WEBB ROAD
WICHITA, KS. 67206
316-684-9600

DESIGN BY: PM, EM, LJ
OCT '95
DATE

DRAWN BY: JLM
SWA MKC-251
JOB NO.

CHECKED BY: JLM
LS 6.05
SHEET 01