

BASE BID

REMOVE EXISTING ASPH. PAVEMENT
INSIDE OF THE FENCE IN COURTS 2,3,4.
CONSTRUCT 3" ASPH. ON 4" REINFORCED CRUSHED ROCK.
INSTALL 3, 4" DIA PERFORATED PIPE.

ADD ALTERNATE #1

ADD EXTRA 1" ASPH. TO THE BASE BID. THE COST OF
EXTRA EXCAVATION FOR THIS ADDITIONAL 1" ASPH. IS
SUBSIDIARY TO THE OTHER BID ITEMS.

TYPE I FENCE
SEE ARCHITECT'S PLANS

RETAINING WALL

HANDBALL COURTS &
TENNIS PRACTICE AREA
SEE SHEET # 4

FOR DETAILS OF RETAINING
& PLANTER WALLS SEE
ARCHITECT PLANS

NOTE:

1. TOOLED JOINTS IN ALL CONCRETE WALKS
ADJACENT TO RETAINING WALLS ARE TO BE
LOCATED IN LINE WITH RUSTICATION JOINTS.
2. FOR PAINTING & MARKING OF TENNIS COURTS SEE
NOTE ON SHEET 14
3. FOR DETAILS ON CONSTRUCTION OF PATIO, BLEACHER,
RAMP, STAIRS, & WALLS SEE ARCHITECT'S PLANS.

LEGEND:

- BREAK IN SLOPE ————
- DIRECTION OF SLOPE ————
- CHAIN LINK FENCE ————
- LOAD TRANSFER JOINT ————

NORTH HALF

TENNIS COMPLEX

SOUTH RIVERSIDE PARK


INDEX # 785469

BOARD OF PARK COMMISSIONERS
WICHITA, KANSAS

5-29-75	T.S.	REMOVE WALLS & SOME WALKS
5-29-75	T.S.	RAISE COURT ELEV.
DATE	BY	REMARKS

REVISION

DATE	DRAWN	SCALE	SHEET
2-28-75	TRF & D.R.	1"=10'-0"	3 of 6

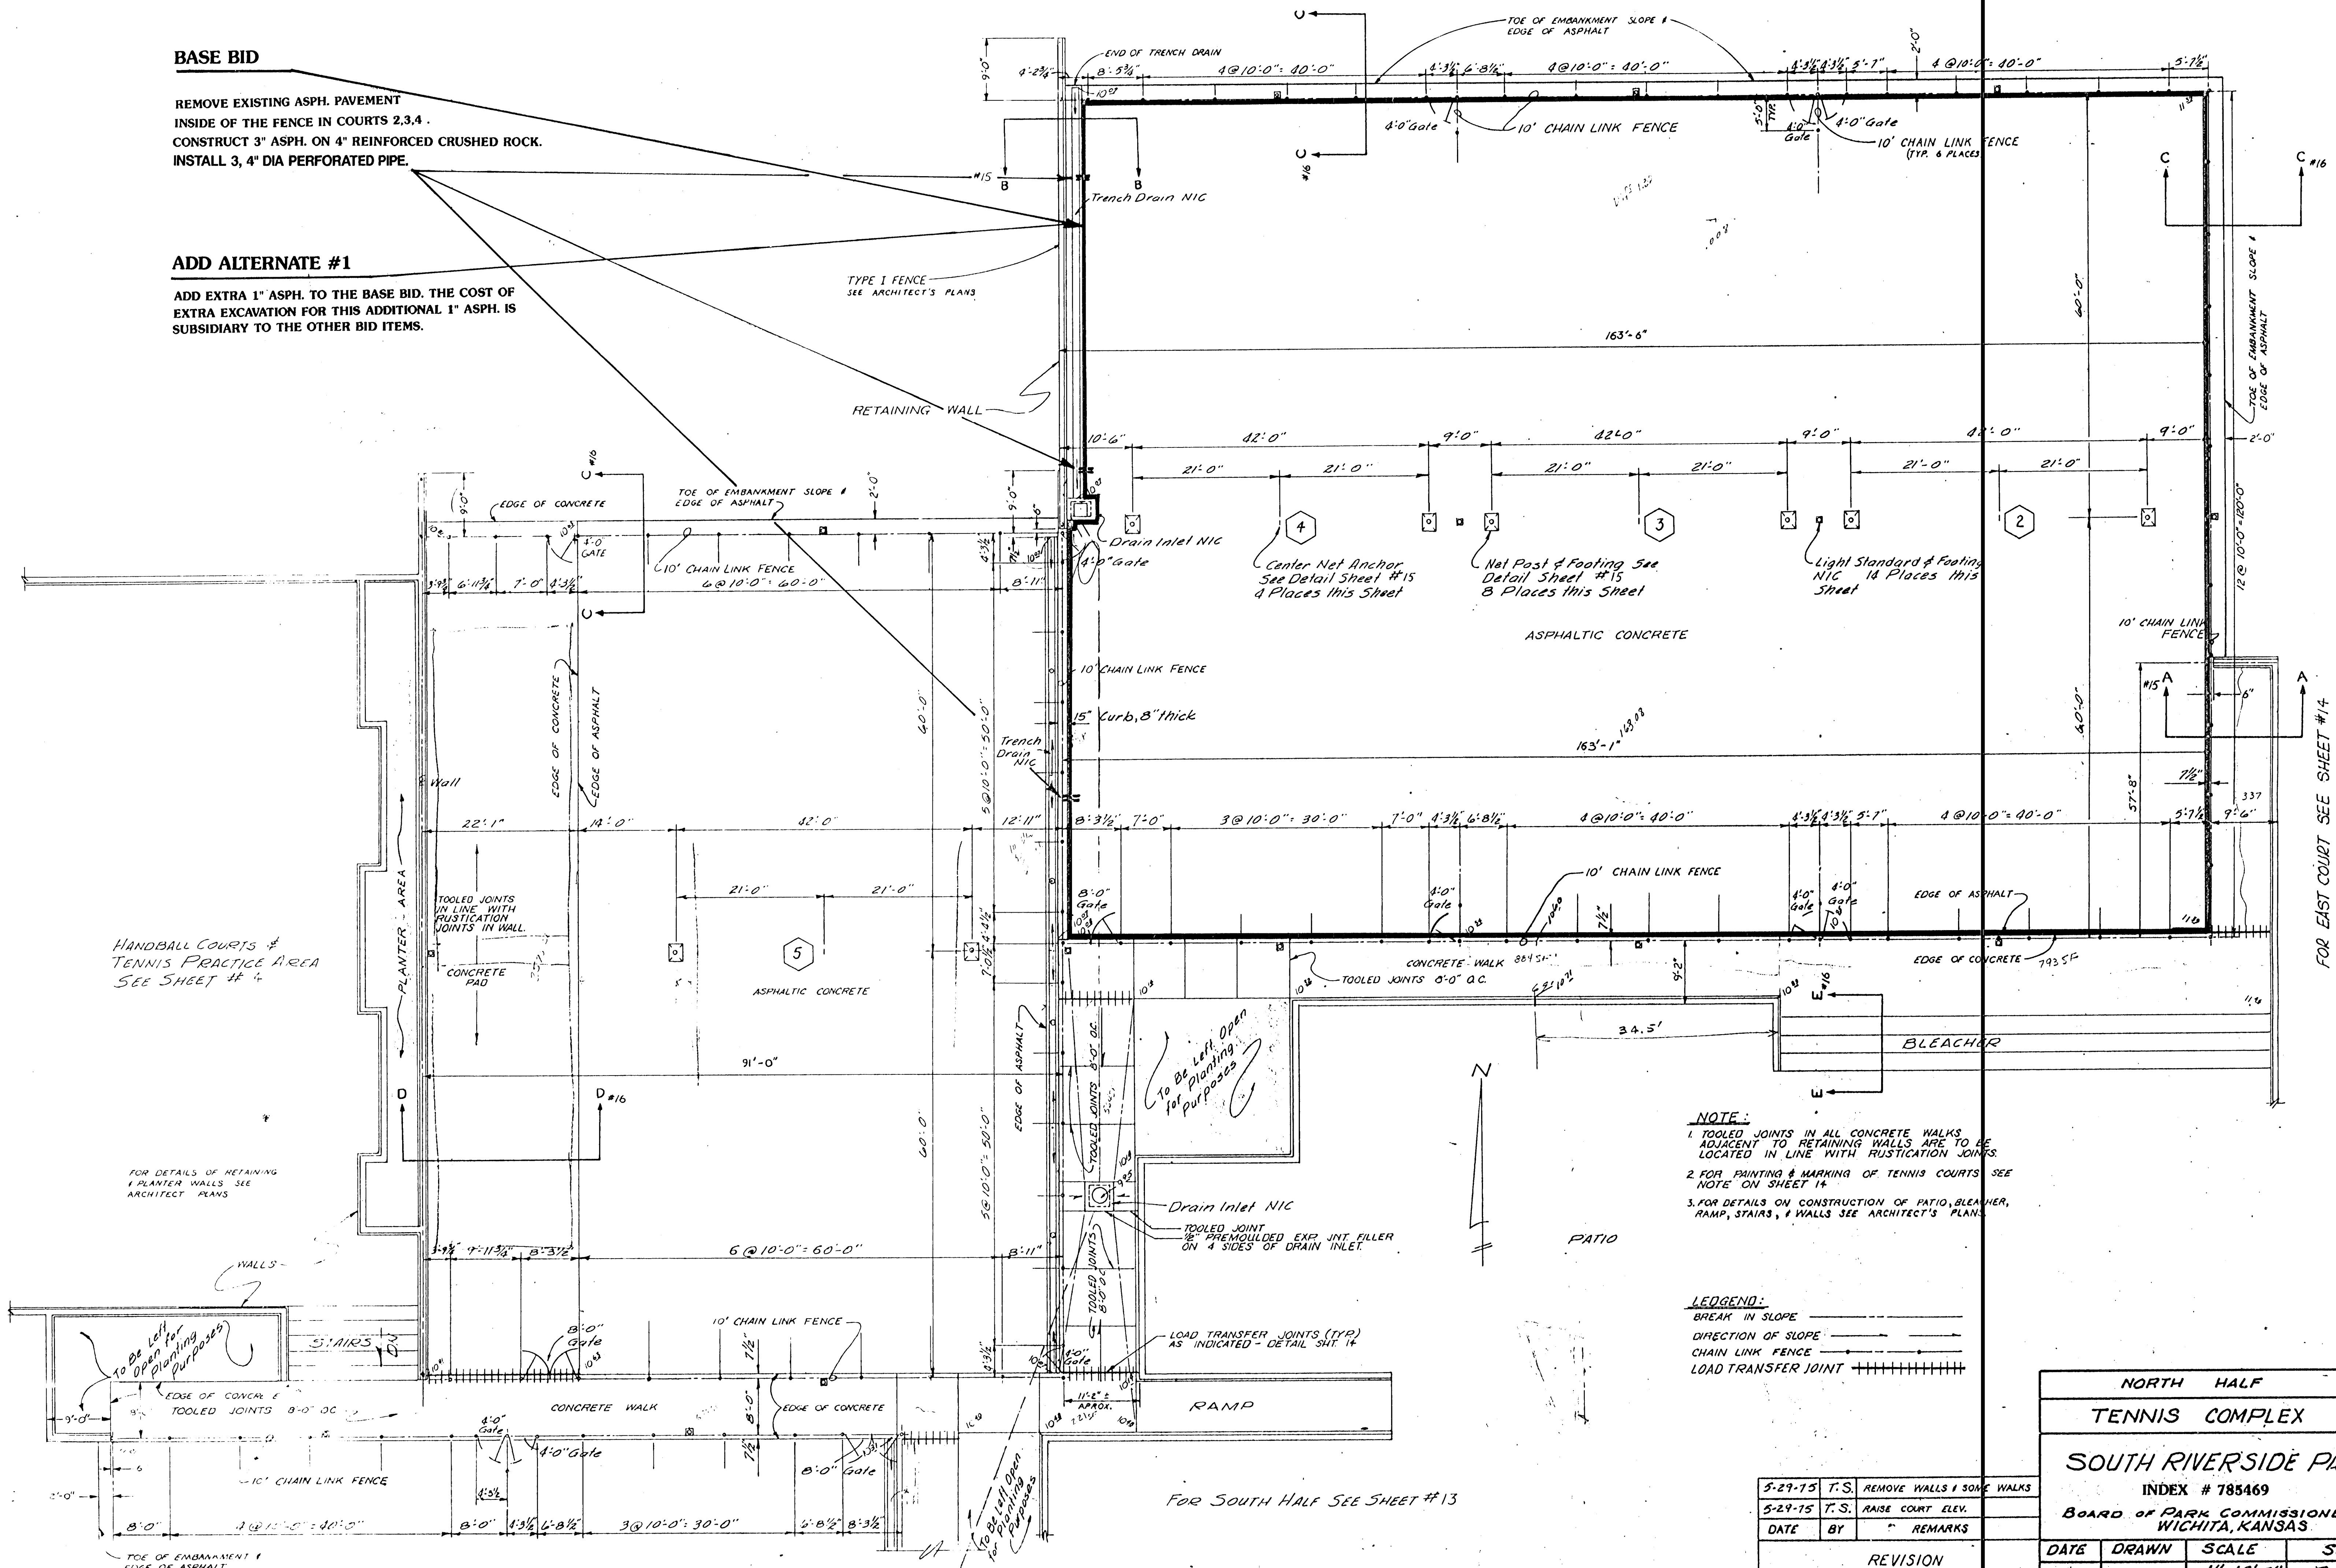

FOR SOUTH HALF SEE SHEET #13

FOR EAST COURT SEE SHEET #14