


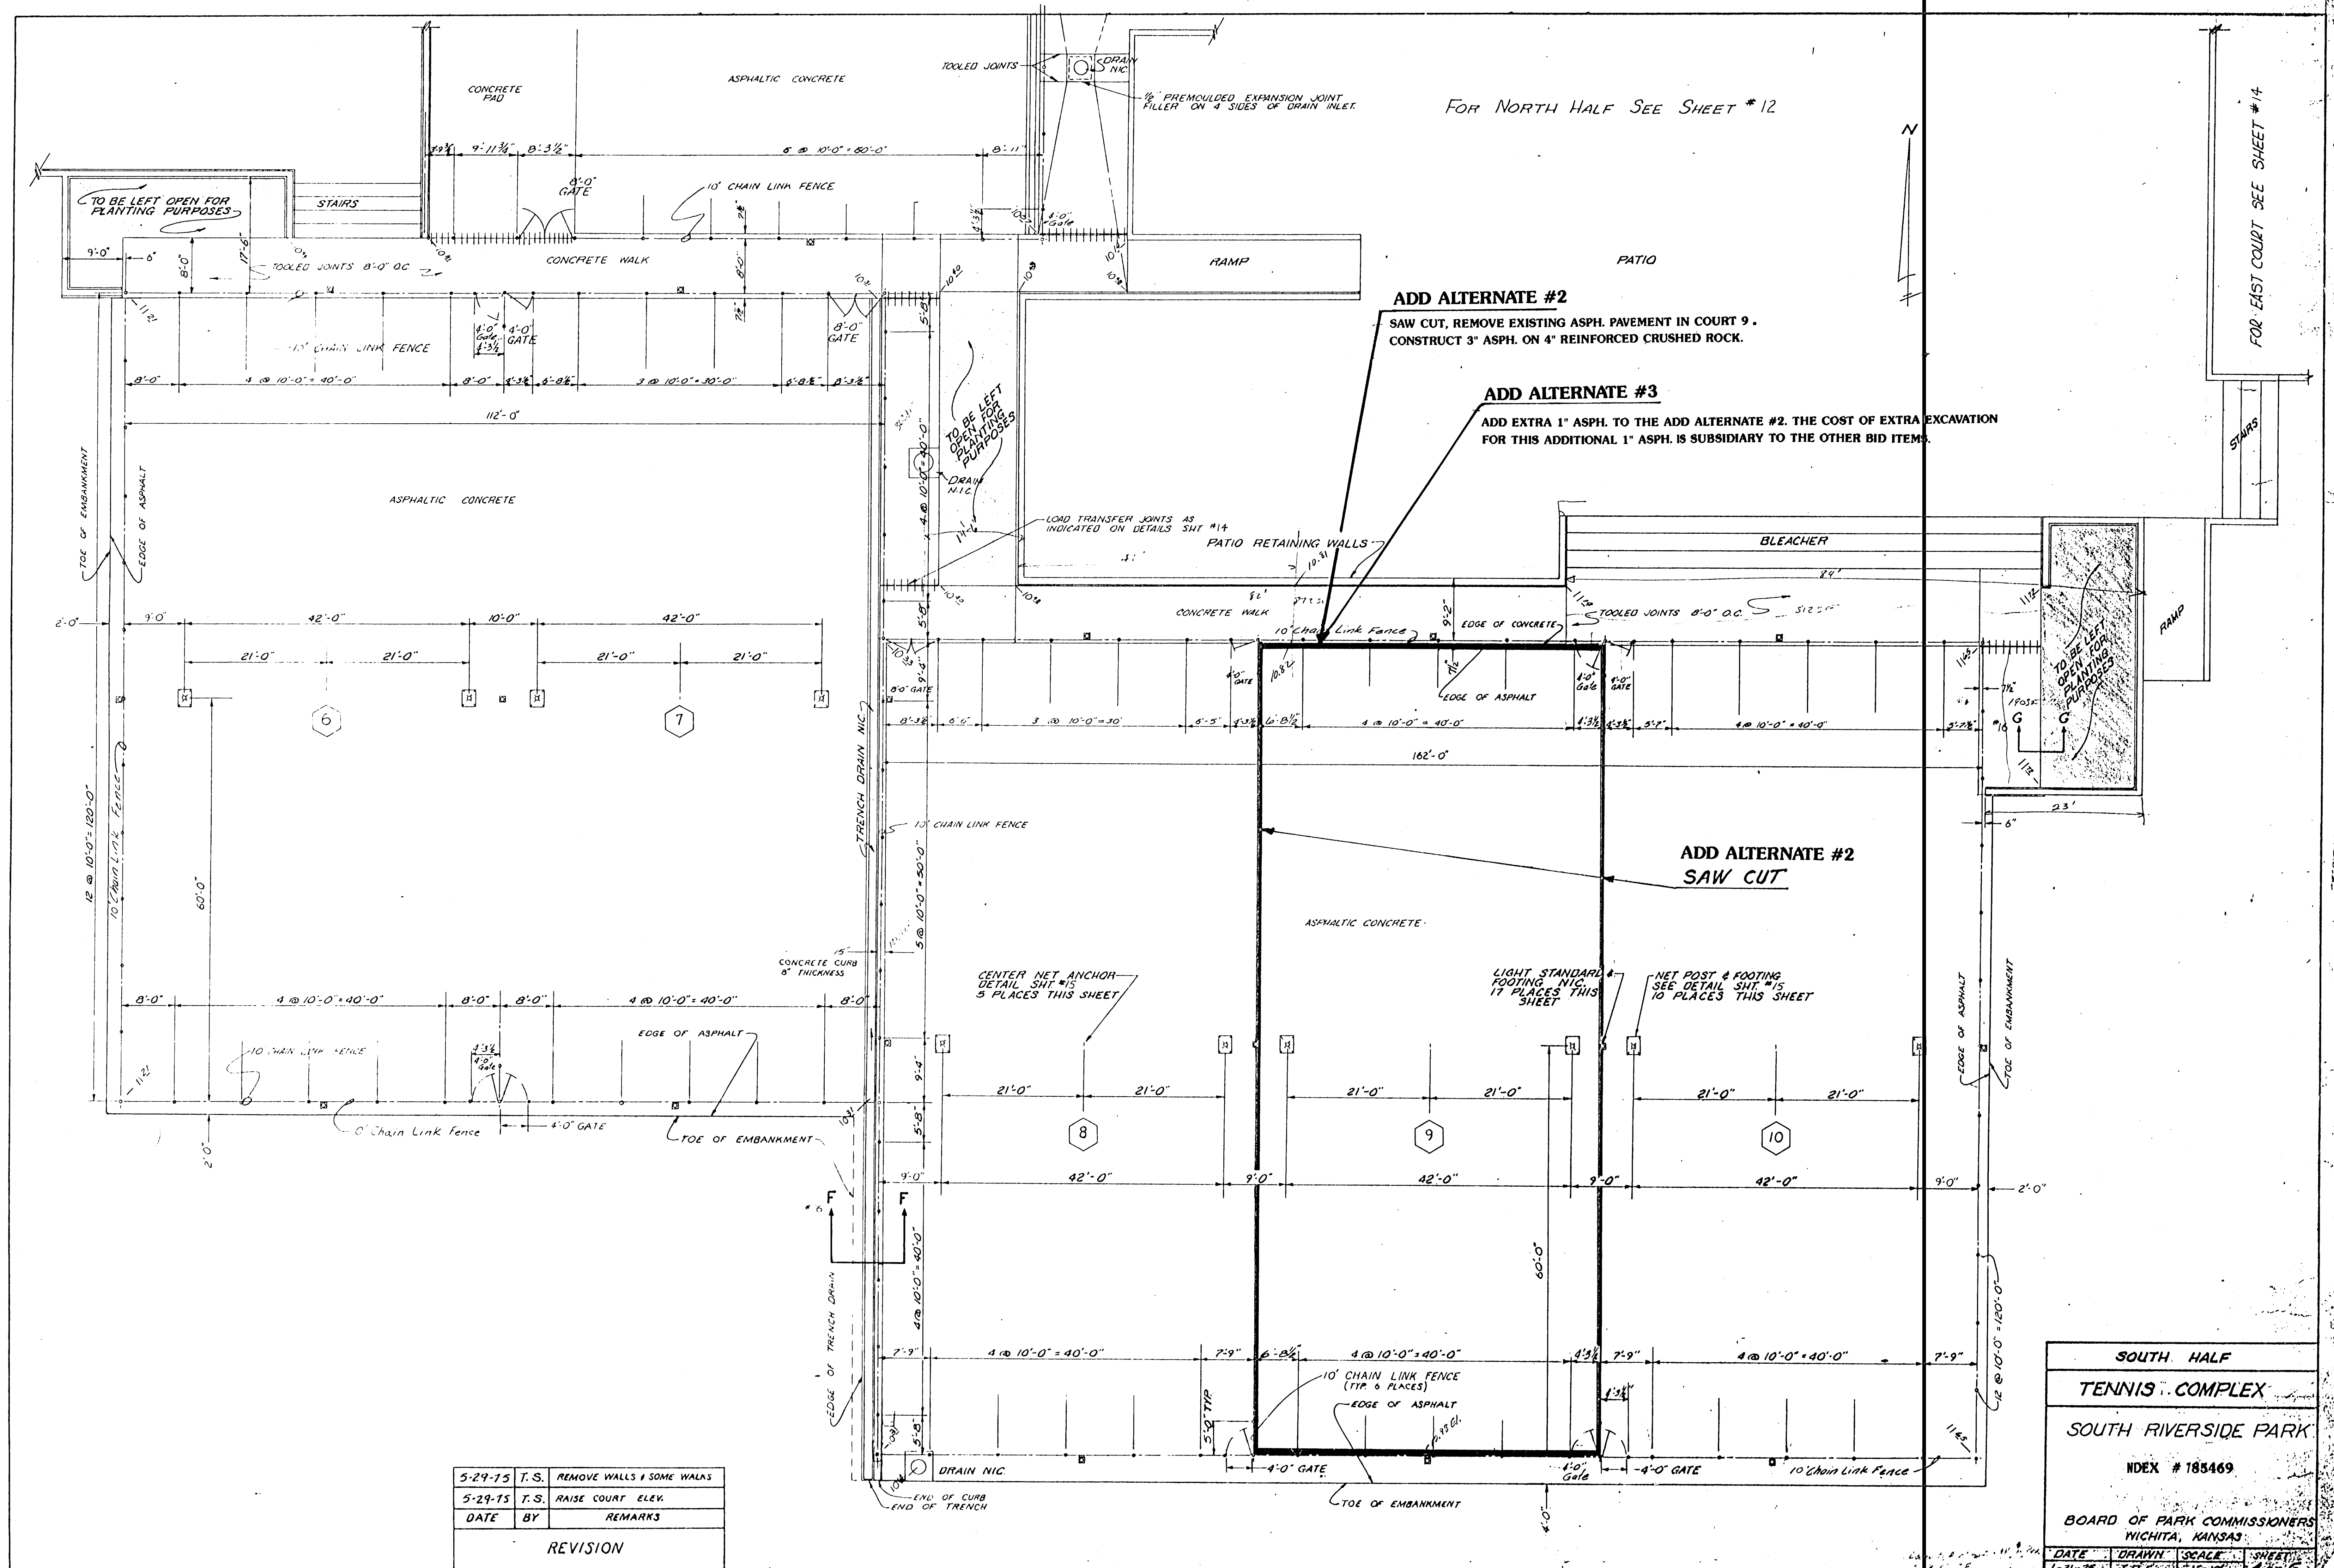

FOR NORTH HALF SEE SHEET #12

FOR EAST COURT SEE SHEET #14

ADD ALTERNATE #2

SAW CUT, REMOVE EXISTING ASPH. PAVEMENT IN COURT 9.
CONSTRUCT 3" ASPH. ON 4" REINFORCED CRUSHED ROCK.

ADD ALTERNATE #3

ADD EXTRA 1" ASPH. TO THE ADD ALTERNATE #2. THE COST OF EXTRA EXCAVATION
FOR THIS ADDITIONAL 1" ASPH. IS SUBSIDIARY TO THE OTHER BID ITEMS.

ADD ALTERNATE #2

SAW CUT

5-29-75	T.S.	REMOVE WALLS & SOME WALKS
5-29-75	T.S.	RAISE COURT ELEV.
DATE	BY	REMARKS
REVISION		

SOUTH HALF

TENNIS COMPLEX

SOUTH RIVERSIDE PARK

NDEX # 185469

BOARD OF PARK COMMISSIONERS
WICHITA, KANSAS

DATE	DRAWN	SCALE	SHEET
1-31-75	T.R.R.	1"=10'	4 OF 6