

SERVICE BOX CONSTRUCTION/INSTALLATION DETAILS



SECTION A-A

RING & COVER DETAIL



REBAR SHALL BE ASTM A615 GRADE 300 MEETING THE REQUIREMENTS OF SUBSECTION SPECIFICATIONS.

14' 27' 1 1/2' 3'

#4 REBAR

30' 30' 30' 4' 1' 2 1/2' 2 1/2'

ANCHOR BOLTS (4) (3/4' x 15' x 2')


#4 REBAR

8' LAYER OF AGGREGATE


CONDUIT AS REQ'D.

5/8' x 8' GROUND ROD

NOTE: CAST IRON RING AND COVER
SHALL BE NEENAH R1773 OR APPROVED
EQUAL.

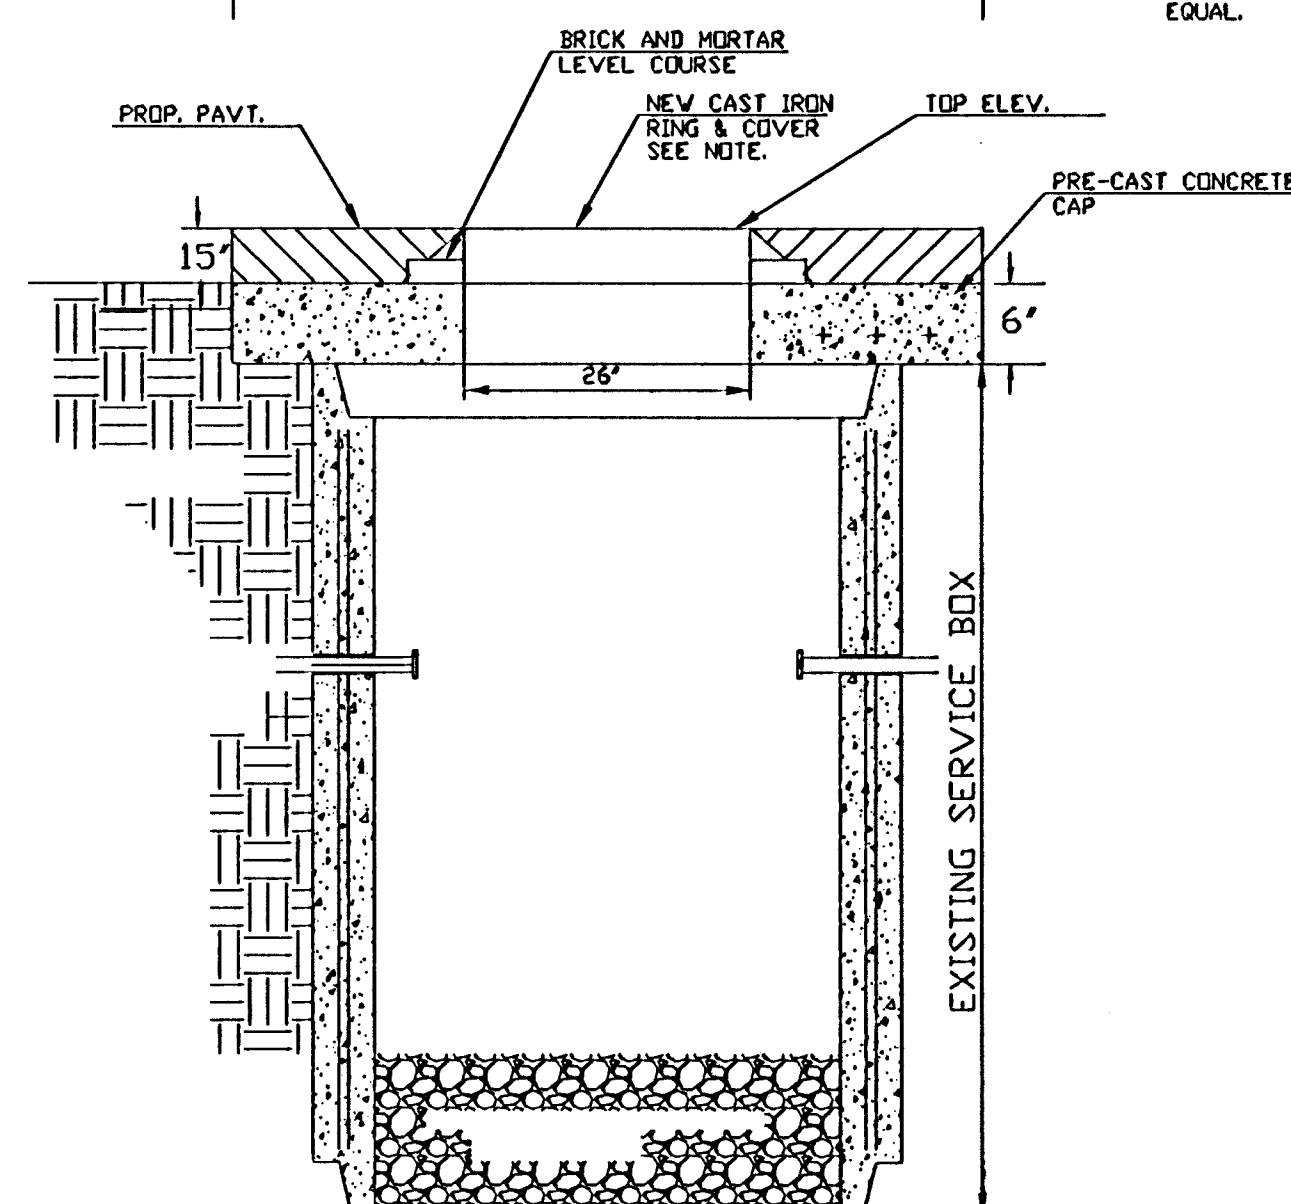

STD. CURB & GUTTER

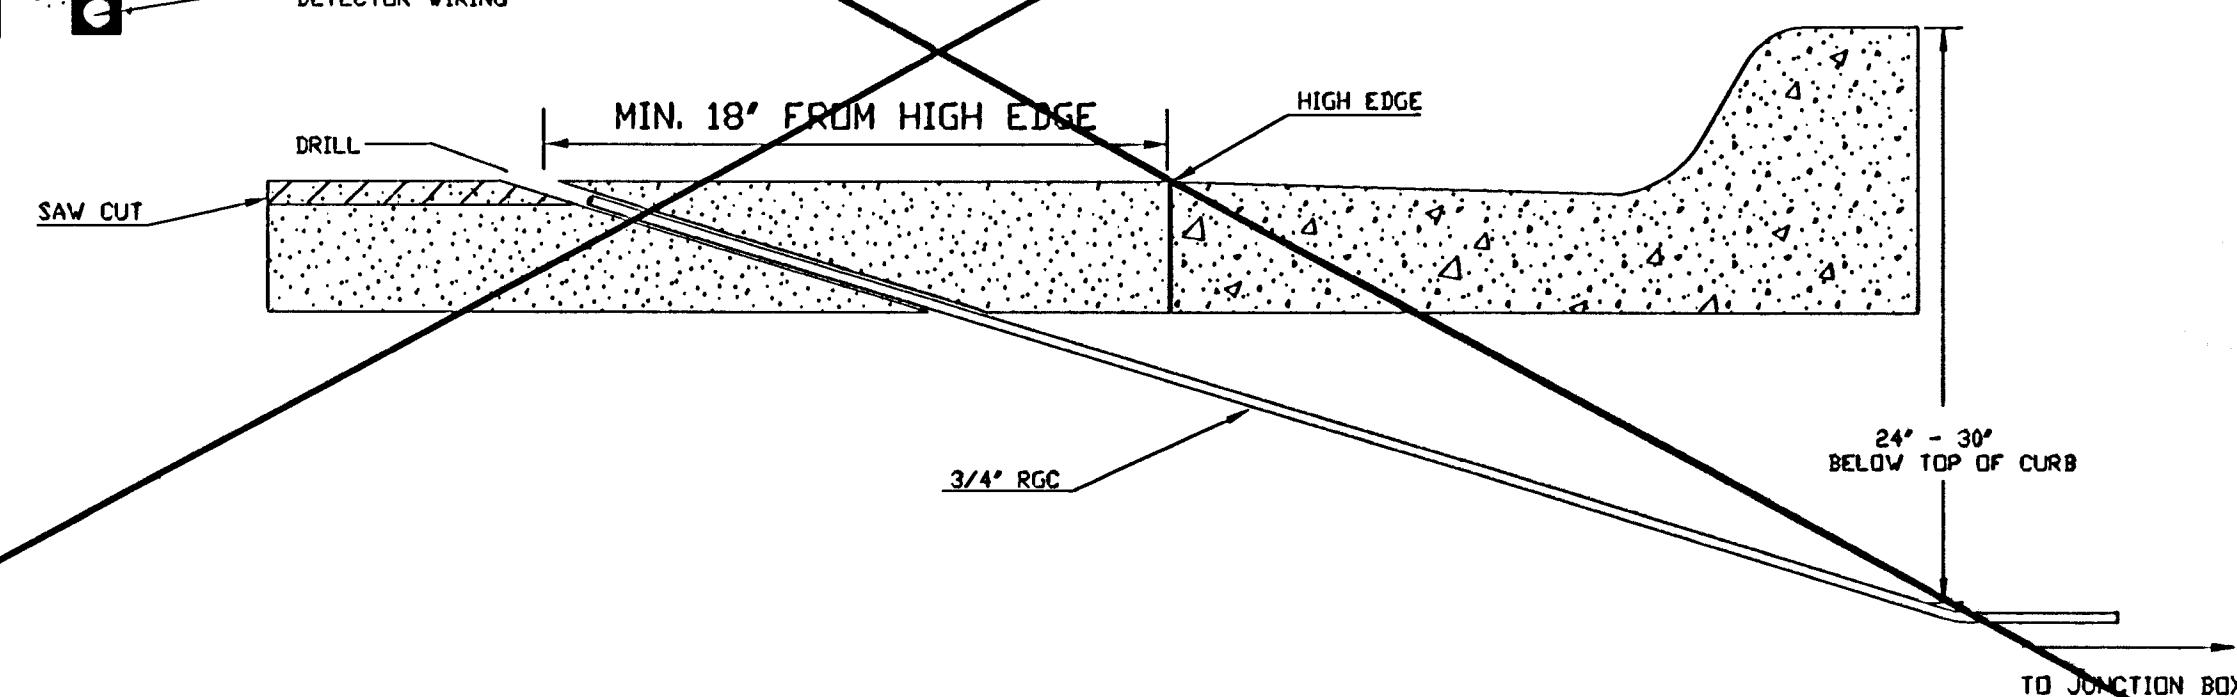

2.	3'	RIGID STEEL CONDUIT BTWN. SERVICE BOXES.	
1	1/4'	'	BTWN. SERVICE & JUNCTION BOXES.
3/4'	'	'	BTWN. JUNCTION BOXES.
3/4'	'	'	BTWN. JUNCTION BOX & DETECTOR
			LOOP SAW CUT

OAK CREEK-PHASE 1
21ST ST. N. DECEL LANE

SERVICE/JUNCTION BOX, CONTROLLER PAD
CONSTRUCTION/INSTALLATION DETAILS

	PROJECT NUMBER
	472-84208

OWN BY: T.M.	APPROVED BY	REVISED BY: T.M.
DATE: MAY 97		DATE: MAY, 97

VISION OF TRAFFIC ENGINEERING

SCALE
NO SCALE