FHWA REGION NO.	STATE	PROJECT NO.	YEAR	SHEET NO.	TOTAL SHEETS
7	KANSAS			35	46

GENERAL NOTES

1) The use of Straw or Hay Bales, Silt Fence or Biodegradable Logs is at the option of the Contractor.

2) The slope barriers shall be placed along contour lines, with a short section turned upgrade at each end of the barrier.

3) At culverts, the Straw or Hay Bales or Silt Fence shall be placed over the culvert, not through the streambed flowline.

4) Barriers damaged by Contractor's negligance, including improper maintenance or lack of maintenance, shall be repaired immediately by Contractor at no additional cost ~~to KDOT~~.

INSTALLATION NOTES

STRAW OR HAY BALES:

1. Place bales tightly together, with loose straw or hay wedged between bales to close off openings.
2. Wood stakes shall be 2" x 2" (nom.) x 4' (min.) long.
3. Refer to plans sheets to estimate the length of bales required.
4. Use only twine to bind bales. The use of wire binding is prohibited because it does not readily biodegrade.

SILT FENCE:

1. Stakes shall be 4' (min.) long and of one of the following materials:
   a. Hardwood – 1 3/16 " x 1 3/16 ";
   b. Southern Pine (No. 2) – 2 5/8 " x 2 5/8 ";
   c. Steel U, T, L, or C Section – 1.33 lbs. per 1'–0"; or
   d. Synthetic – same strength as wood stakes.
2. Attach fence fabric to stakes with staples, wire or nails.
3. Refer to plan sheets to estimate the length of Silt Fence required.

BIODEGRADABLE LOG BARRIERS

1. Place biodegradable logs tightly together.
2. Wood stakes shall be 2" x 2" (nom.) x 4' (min.) long.
3. Wire staples shall be 6" long x 1" wide (min.) and placed on 3' (max.) centers.
4. Refer to plan sheets to estimate length of biodegradable log barriers required.

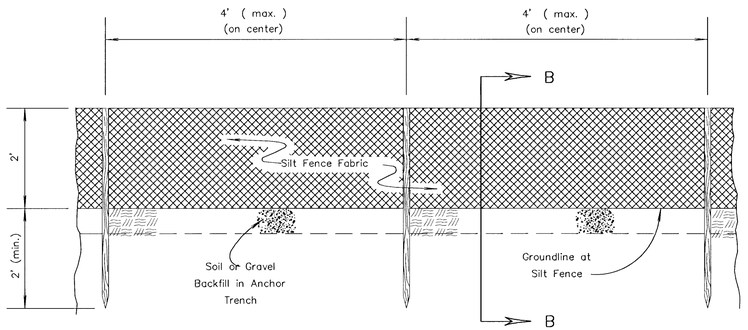

TYPICAL ELEVATION

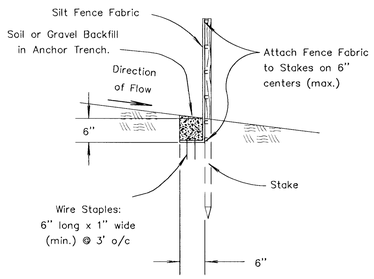

SECTION B – B

SILT FENCE SLOPE BARRIER

NO SCALE

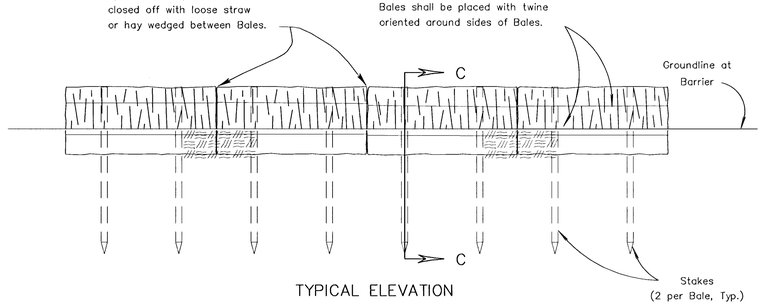

TYPICAL ELEVATION

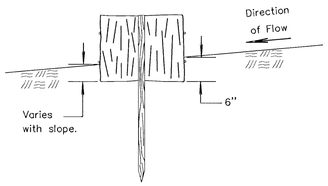

SECTION C – C

STRAW BALE SLOPE BARRIER

NO SCALE

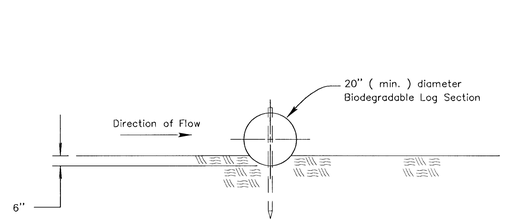

SECTION A – A

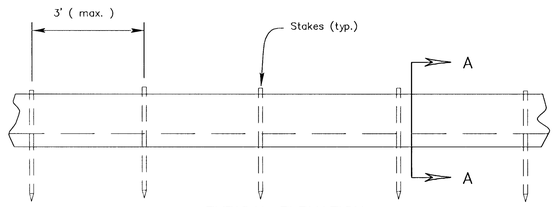

TYPICAL ELEVATION

BIODEGRADABLE LOG SLOPE BARRIER

NO SCALE

NO.	DATE	REVISIONS	BY	APP'D
3				
2				
1	5/1 0/99	Revised Standard	WCL	RDR

KANSAS DEPARTMENT OF TRANSPORTATION

TEMPORARY EROSION AND POLLUTION CONTROL

STRAW OR HAY BALE SLOPE BARRIERS

SILT FENCE SLOPE BARRIERS

BIODEGRADABLE LOG SLOPE BARRIERS

~~LA852D~~

F.H.W.A. APPROVAL			5/20/99	APP'D		Richard D. Ross	
DESIGNED	WCL	DETAILED	WCL	QUANTITIES		TRACED	WCL
DESIGN CK.	RDR	DETAIL CK.	RDR	QUAN.CK.		TRACE CK.	RDR