


83900

INDEX OF SHEETS

WB Carter Construction Co., Inc.- Contractor
Koleczek/Sholander, City- Inspectors
Released 2/11/06
Per Plan
Risers & Stubs
.pdf by JDL 5/22/06

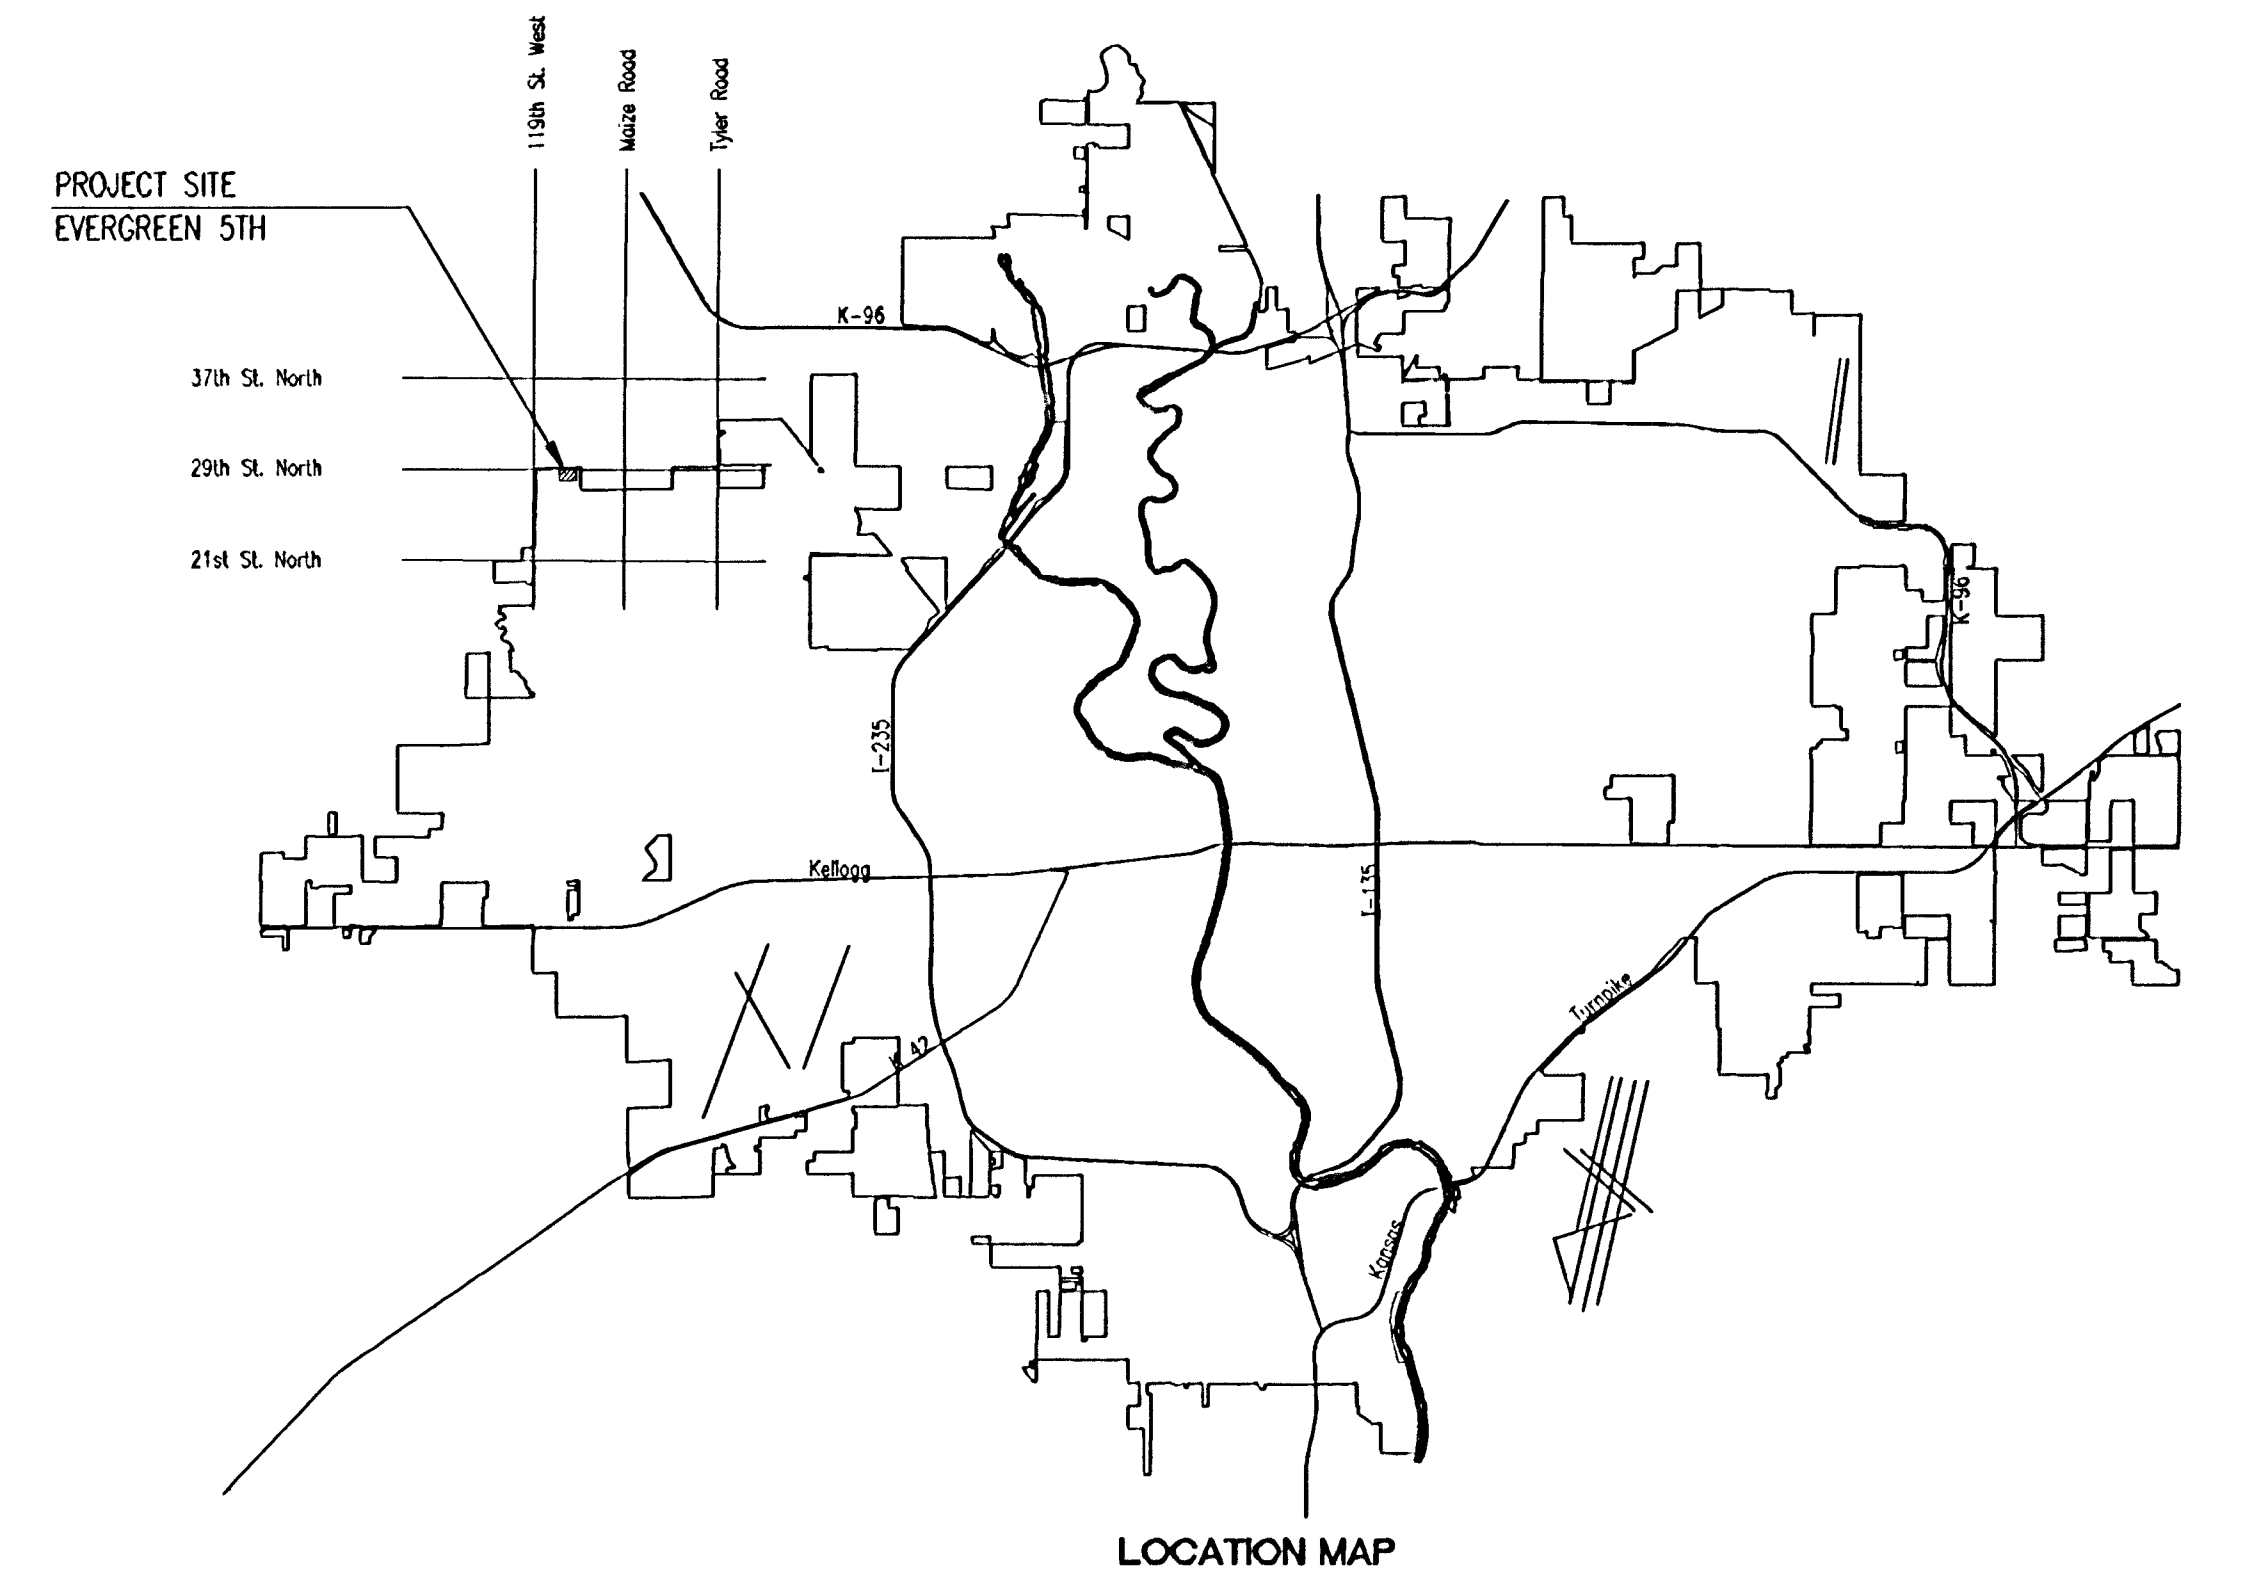

CONSTRUCTION SCHEDULE/SEQUENCE

SANITARY SEWER

WATERLINES

STREETS/DRAINAGE

OCTOBER 2005

PLANS PREPARED BY
PROFESSIONAL ENGINEERING CONSULTANTS, P.A.
ENGINEERS
WICHITA, KANSAS

