
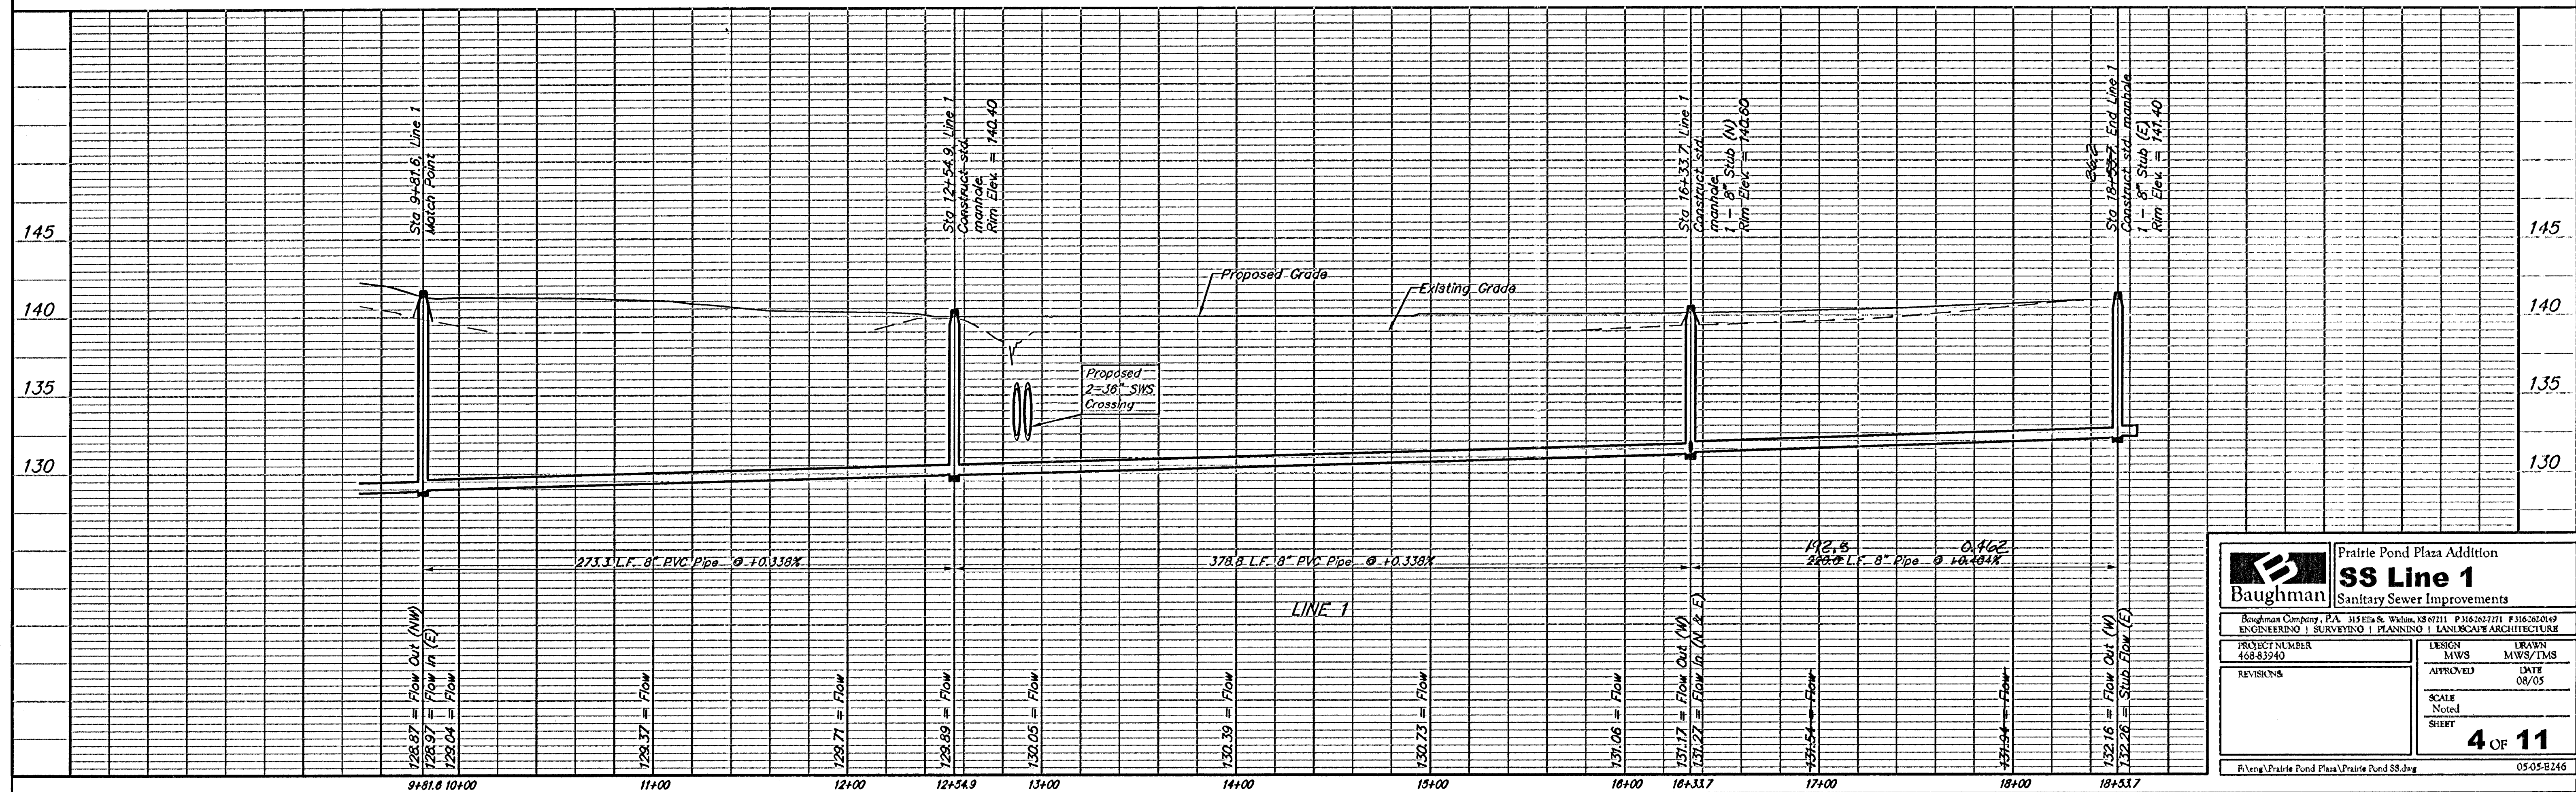


BENCHMARK:
"□" cut on traffic signal
light pole base, NW corner
of Kellogg & 143rd Street
East.
Elev. = 1318.61 NGVD
(131.21 City Datum)

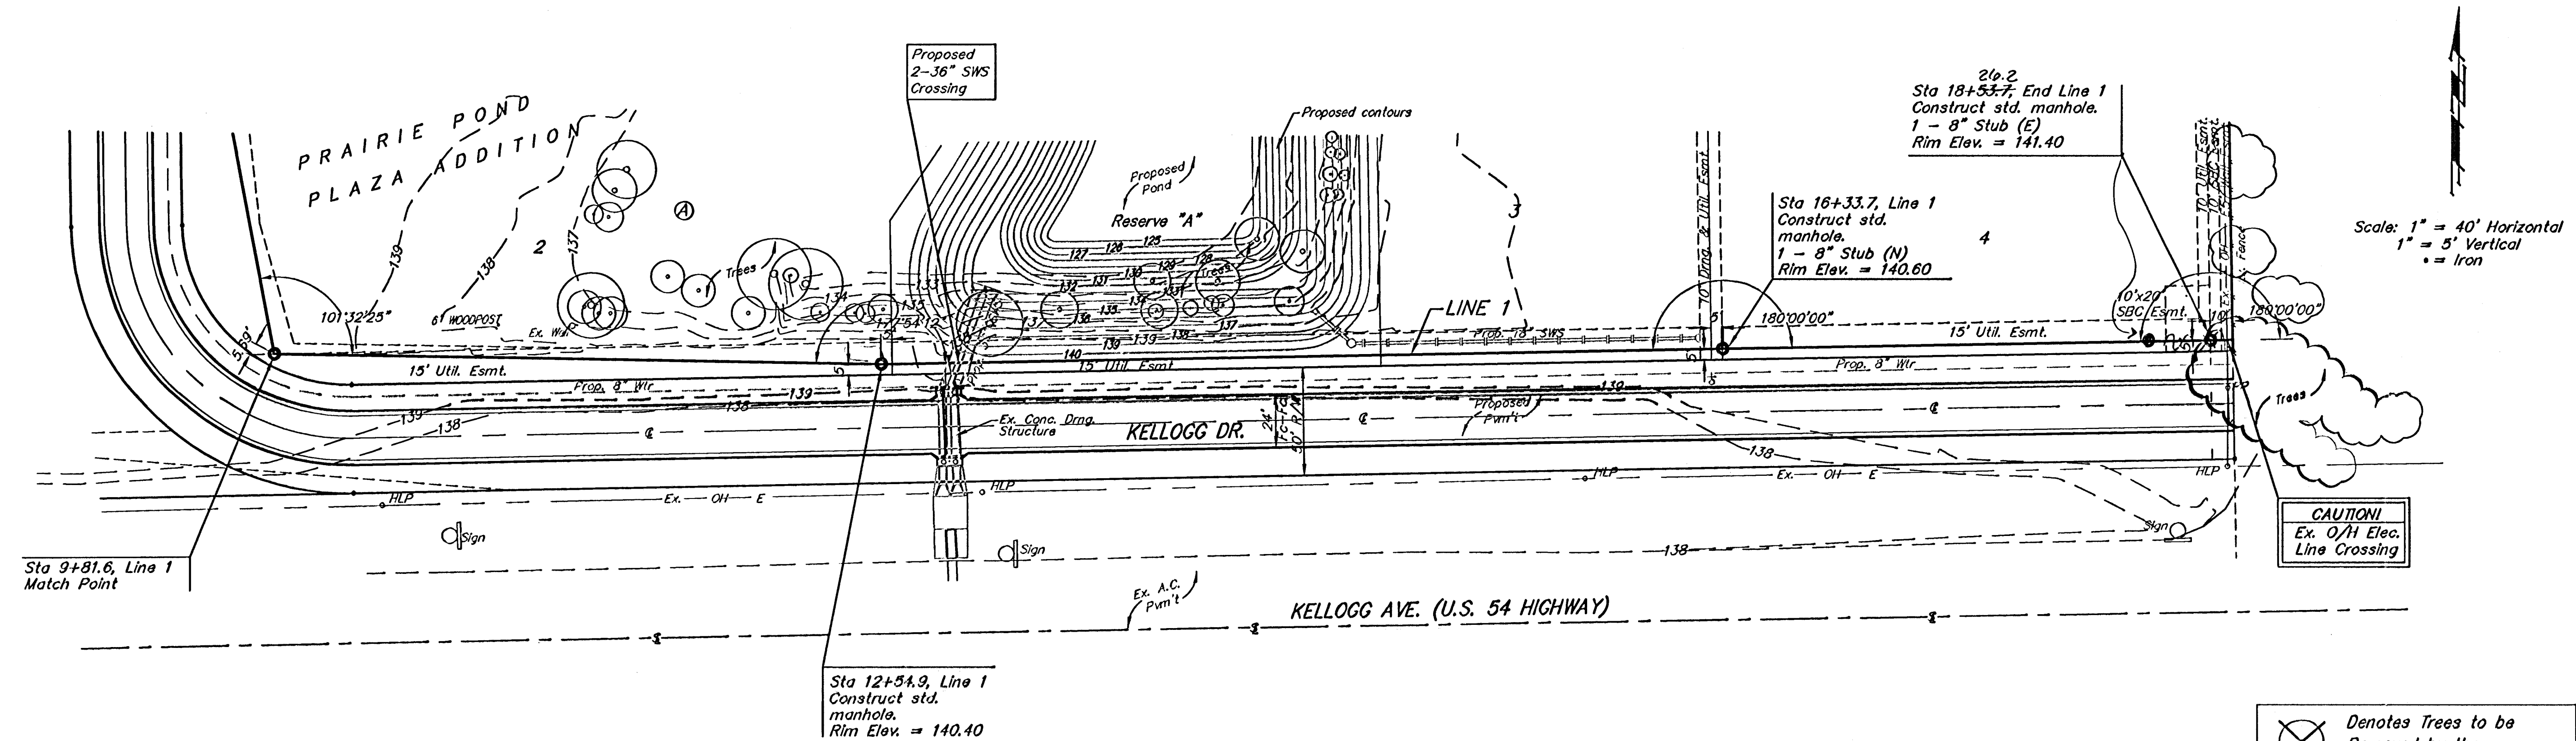

Baughman Prairie Pond Plaza Addition
SS Line 1
Sanitary Sewer Improvements

Baughman Company, P.A. 315 Elm & Widom, 130711 P316-303711 P316-303711
ENGINEERING | SURVEYING | PLANNING | LANDSCAPE ARCHITECTURE

PROJECT NUMBER
468-83240

DESIGN
MWS

APPROVED
DATE
08/05

SCALE
Noted
SHEET

4 OF 11

R:\eng\prairie pond plaza\prairie pond ss.dwg 05-05-B246