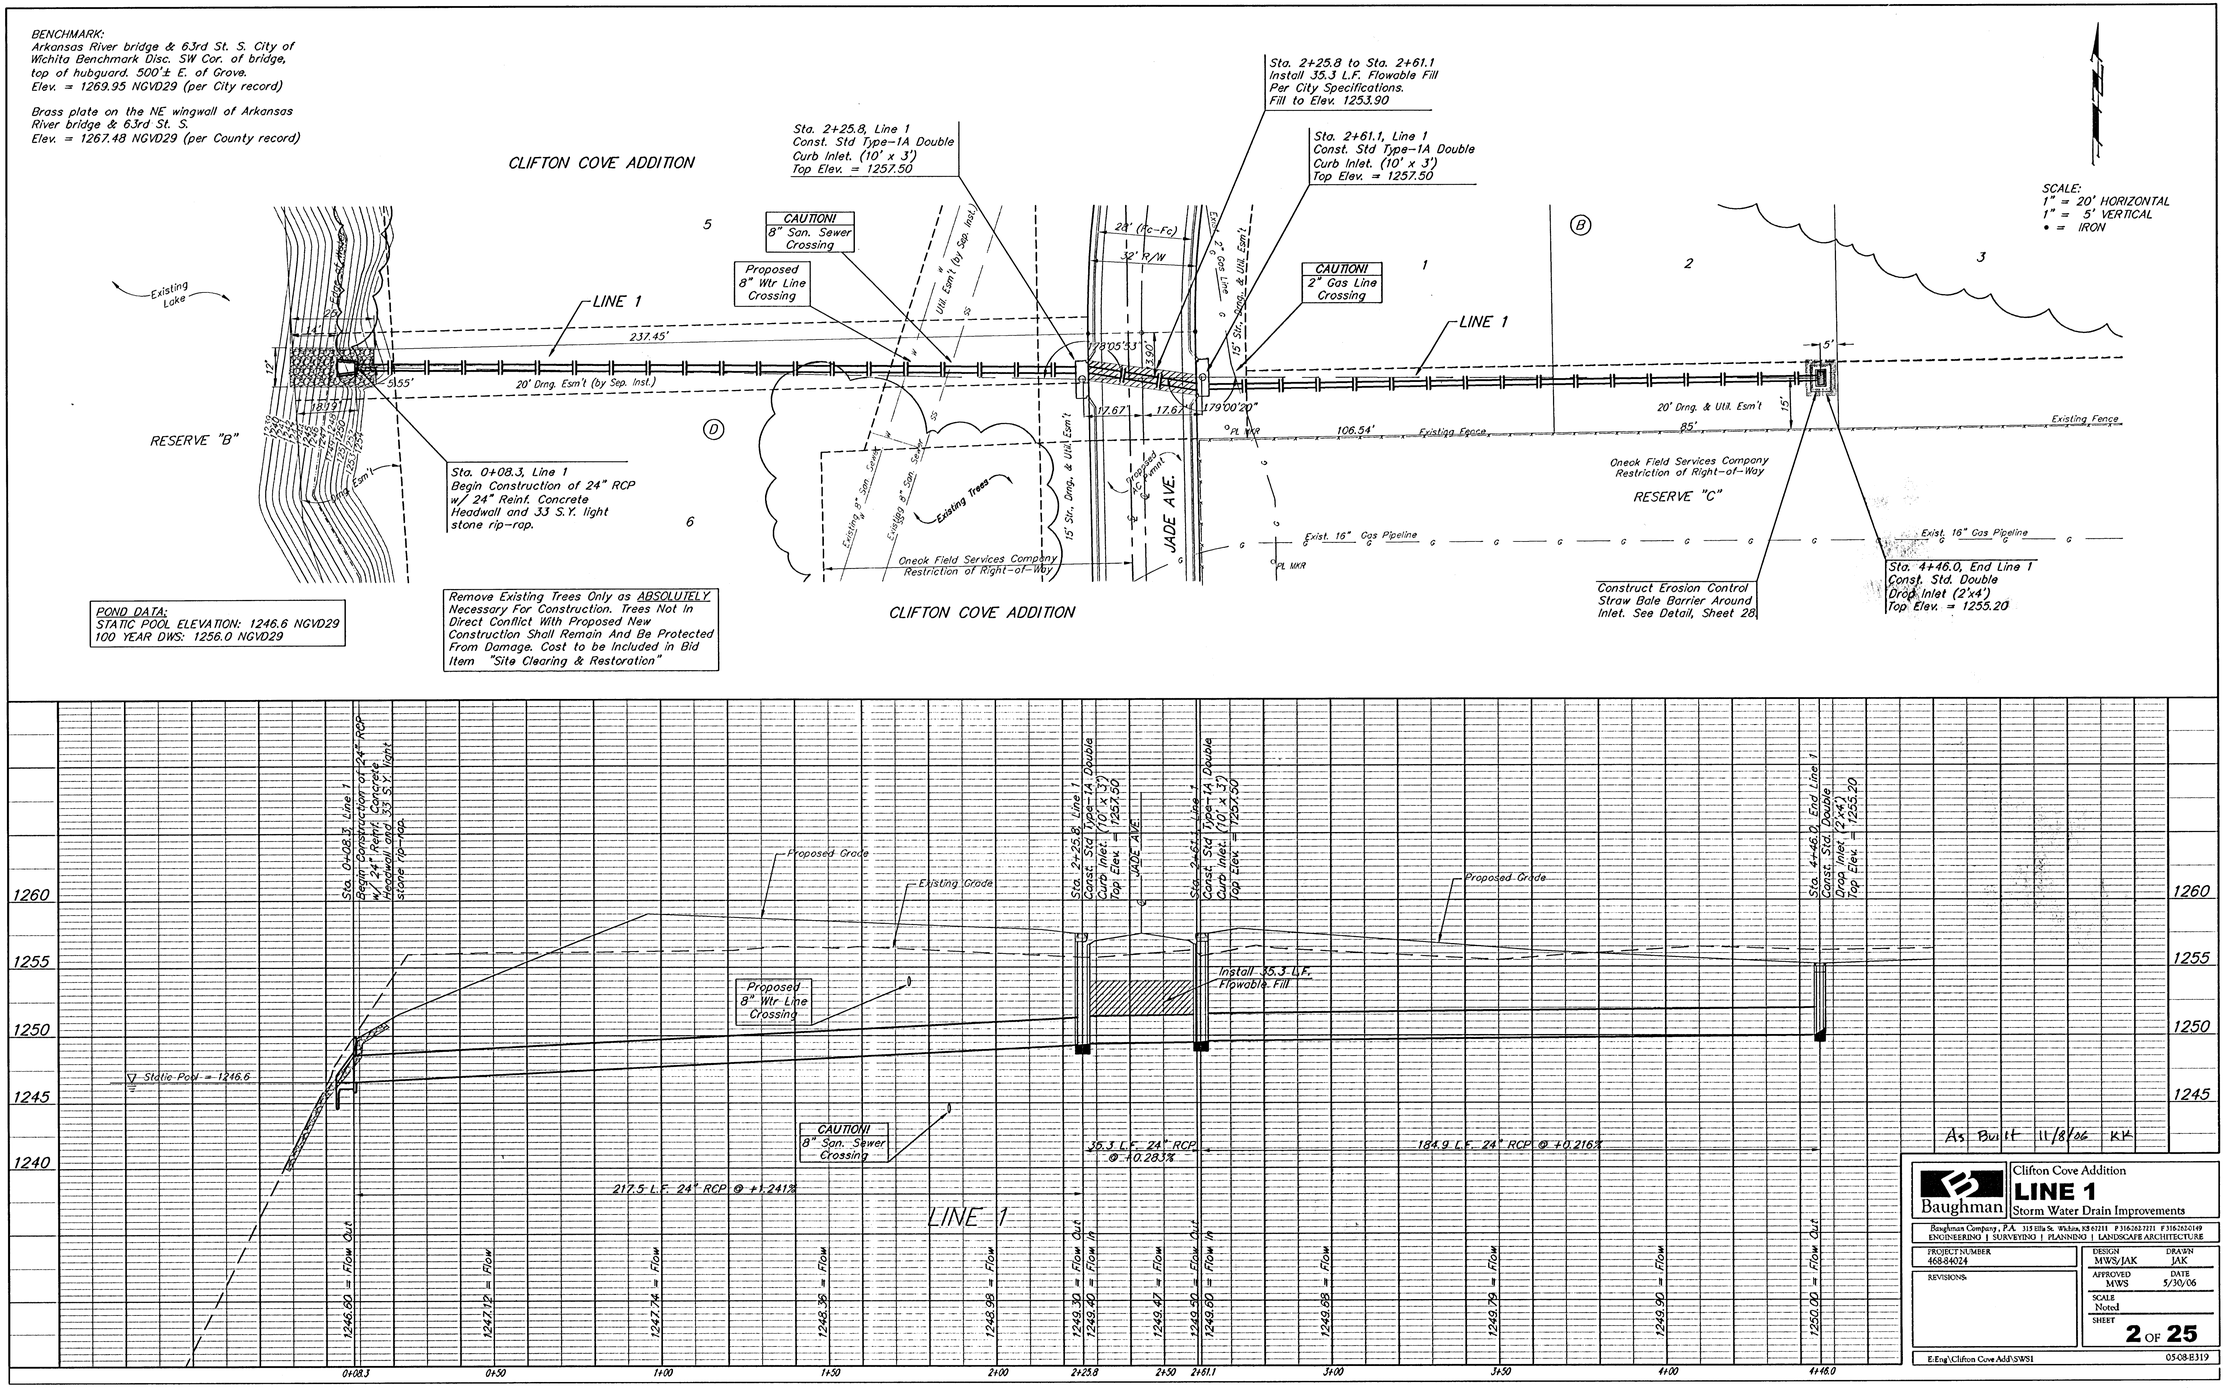

Baughman

Clifton Cove Addition
LINE 1
Storm Water Drain Improvements

Baughman Company, P.A. 315 Ellis St. Wichita, KS 67211 P 316-262-7221 F 316-262-0149
ENGINEERING | SURVEYING | PLANNING | LANDSCAPE ARCHITECTURE

PROJECT NUMBER 468-84024	DESIGN MWS/JAK — DRAWN JAK
REVISIONS:	APPROVED MWS — DATE 5/30/06
	SCALE Noted
	SHEET 2 OF 25

E:Eng\Clifton Cove Add\SWS1 05-08-E319