

BENCHMARK:
Arkansas River bridge & 63rd St. S. City of Wichita Benchmark Disc. SW Cor. of bridge, top of hubguard. 500'± E. of Grove.
Elev. = 1269.95 NGVD29 (per City record)

Brass plate on the NE wingwall of Arkansas River bridge & 63rd St. S.
Elev. = 1267.48 NGVD29 (per County record)

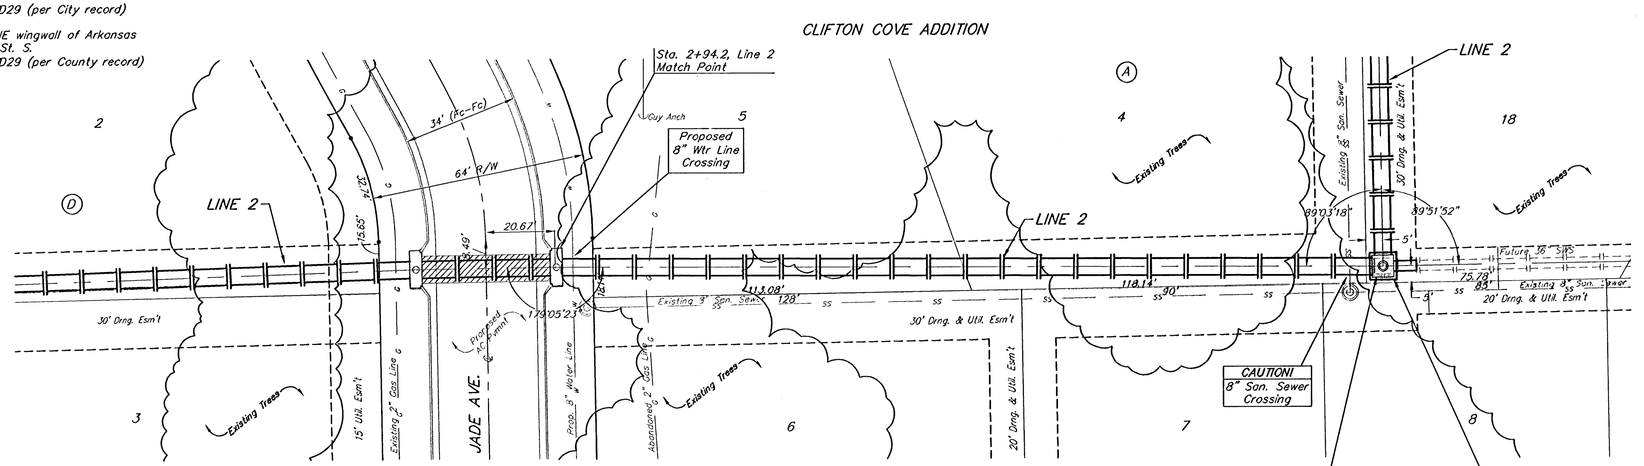

SCALE:
1" = 20' HORIZONTAL
1" = 5' VERTICAL
• = IRON

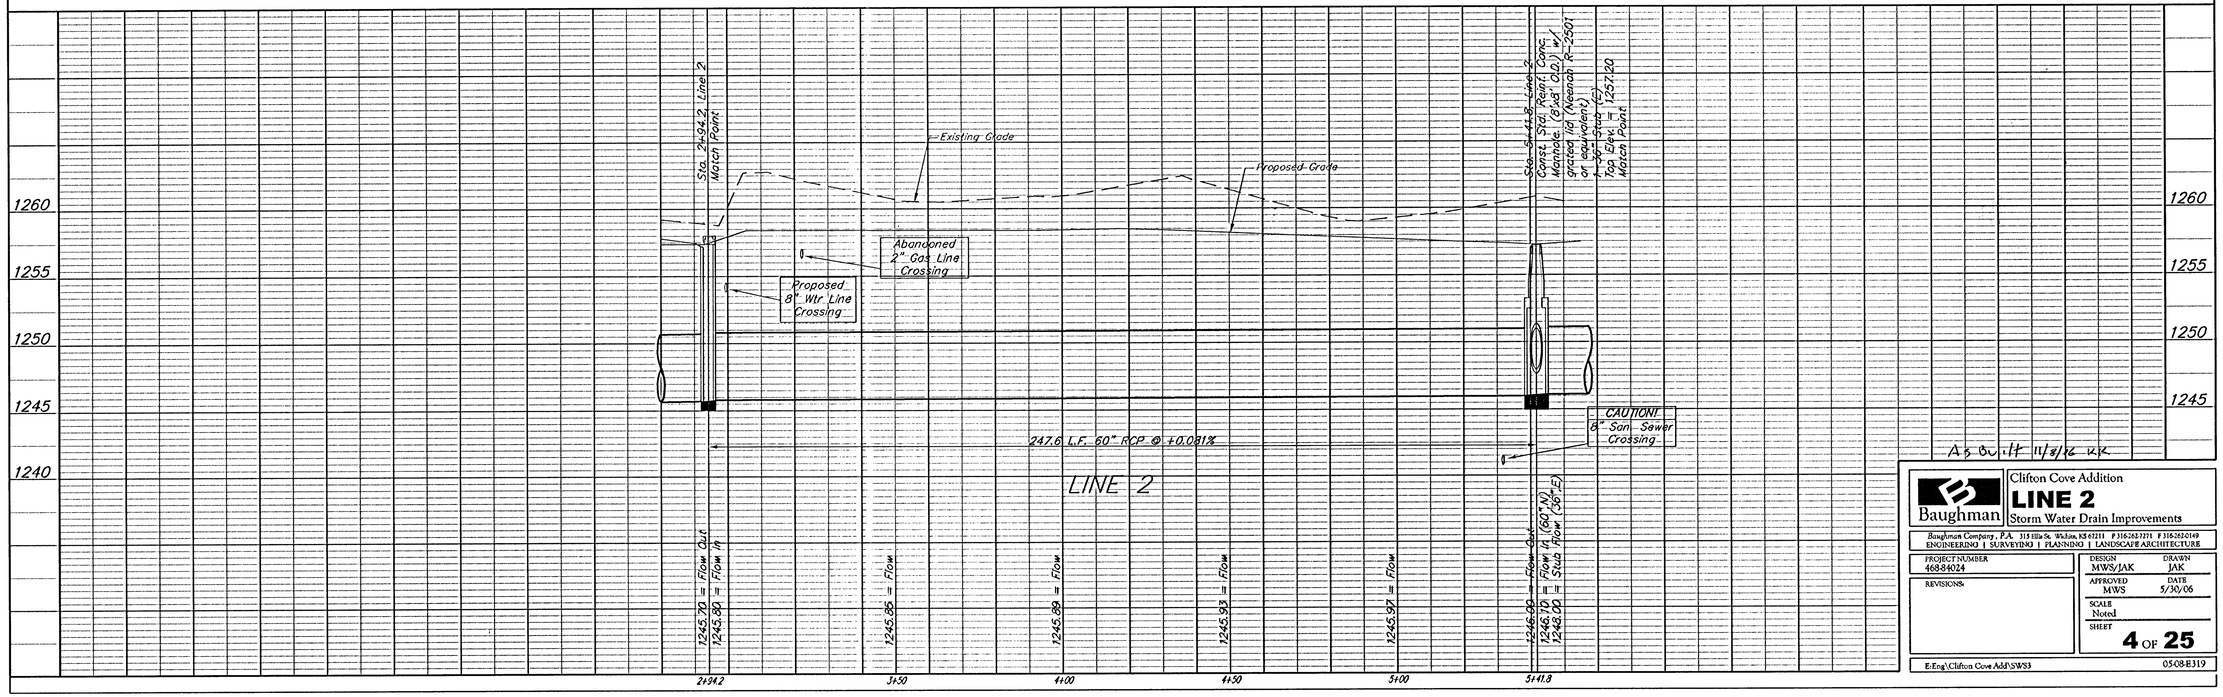

As Built 11/3/06 VK

Baughman

Clifton Cove Addition
LINE 2
Storm Water Drain Improvements

Baughman Company, P.A. 315 Ella St. Wichita, KS 67211 P 316.262.2221 F 316.262.0149
ENGINEERING | SURVEYING | PLANNING | LANDSCAPE ARCHITECTURE

PROJECT NUMBER 468.84024
REVISIONS:
DESIGN MWS/JAK
DRAWN JAK
APPROVED MWS
DATE 5/30/06
SCALE Noted
SHEET **4** OF **25**

E:\Eng\Clifton Cove Add\SWS3 05-08-E319