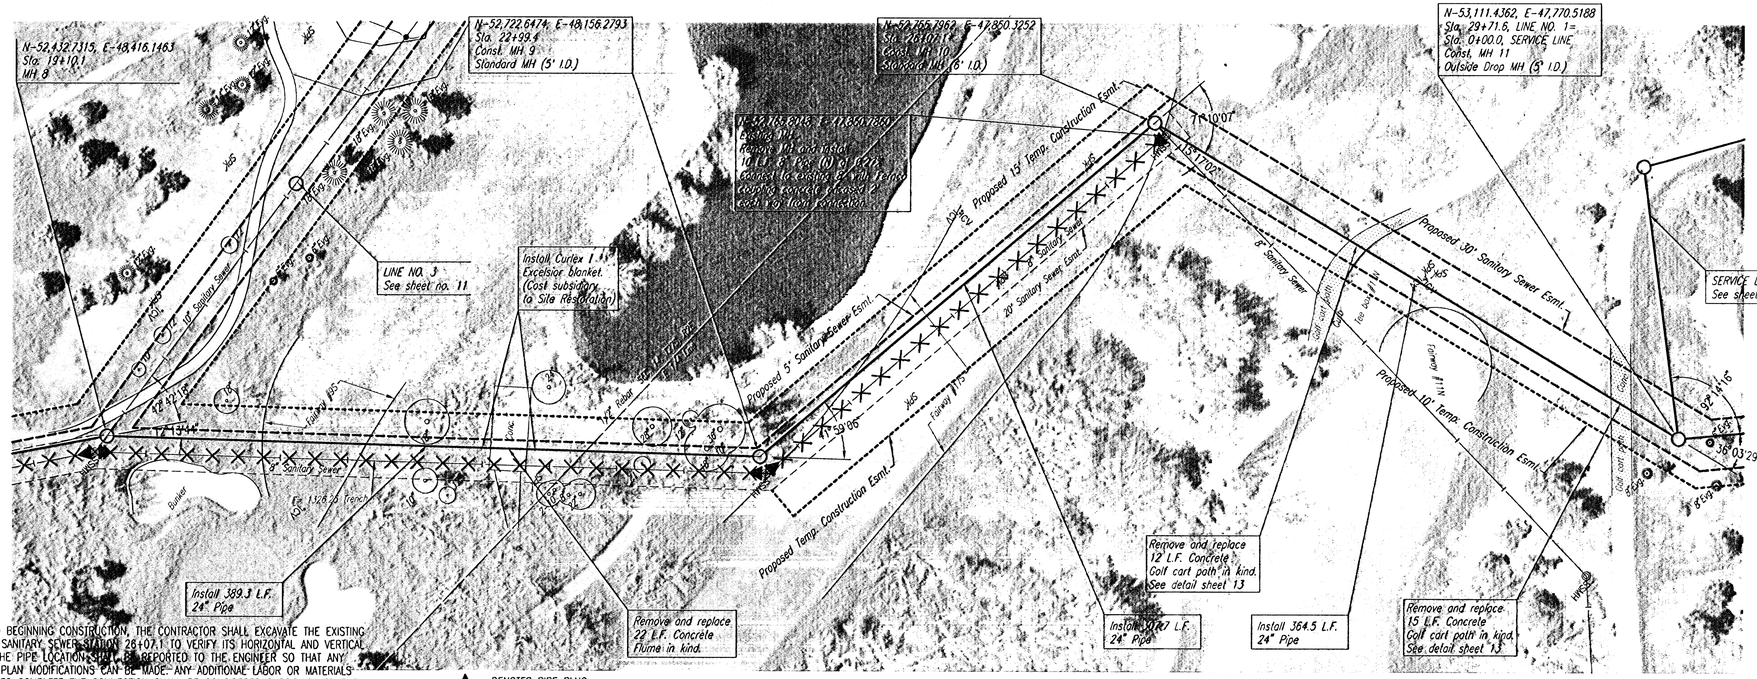


SCALE:
0 40 80
PLAN: LAT. & LONG.
PROFILE: HORIZ. SAME AS ABOVE
VERT.


PLAN	CHECKED	BY	DATE
	CHECKED		

* PRIOR TO BEGINNING CONSTRUCTION, THE CONTRACTOR SHALL EXCAVATE THE EXISTING 8" PIPE AT SANITARY SEWER STATION 26+07.1 TO VERIFY ITS HORIZONTAL AND VERTICAL LOCATION. THE PIPE LOCATIONS SHALL BE REPORTED TO THE ENGINEER SO THAT ANY NECESSARY PLAN MODIFICATIONS CAN BE MADE. ANY ADDITIONAL LABOR OR MATERIALS NECESSARY TO COMPLETE THE CONNECTION SHALL BE CONSIDERED SUBSIDIARY TO THE PROJECT.

▲ = DENOTES PIPE PLUG
X = DENOTES SANITARY SEWER/MANHOLE ABANDONMENT

SANITARY SEWER LINE NO. 1

PROFILE	CHECKED	BY	DATE
	CHECKED		

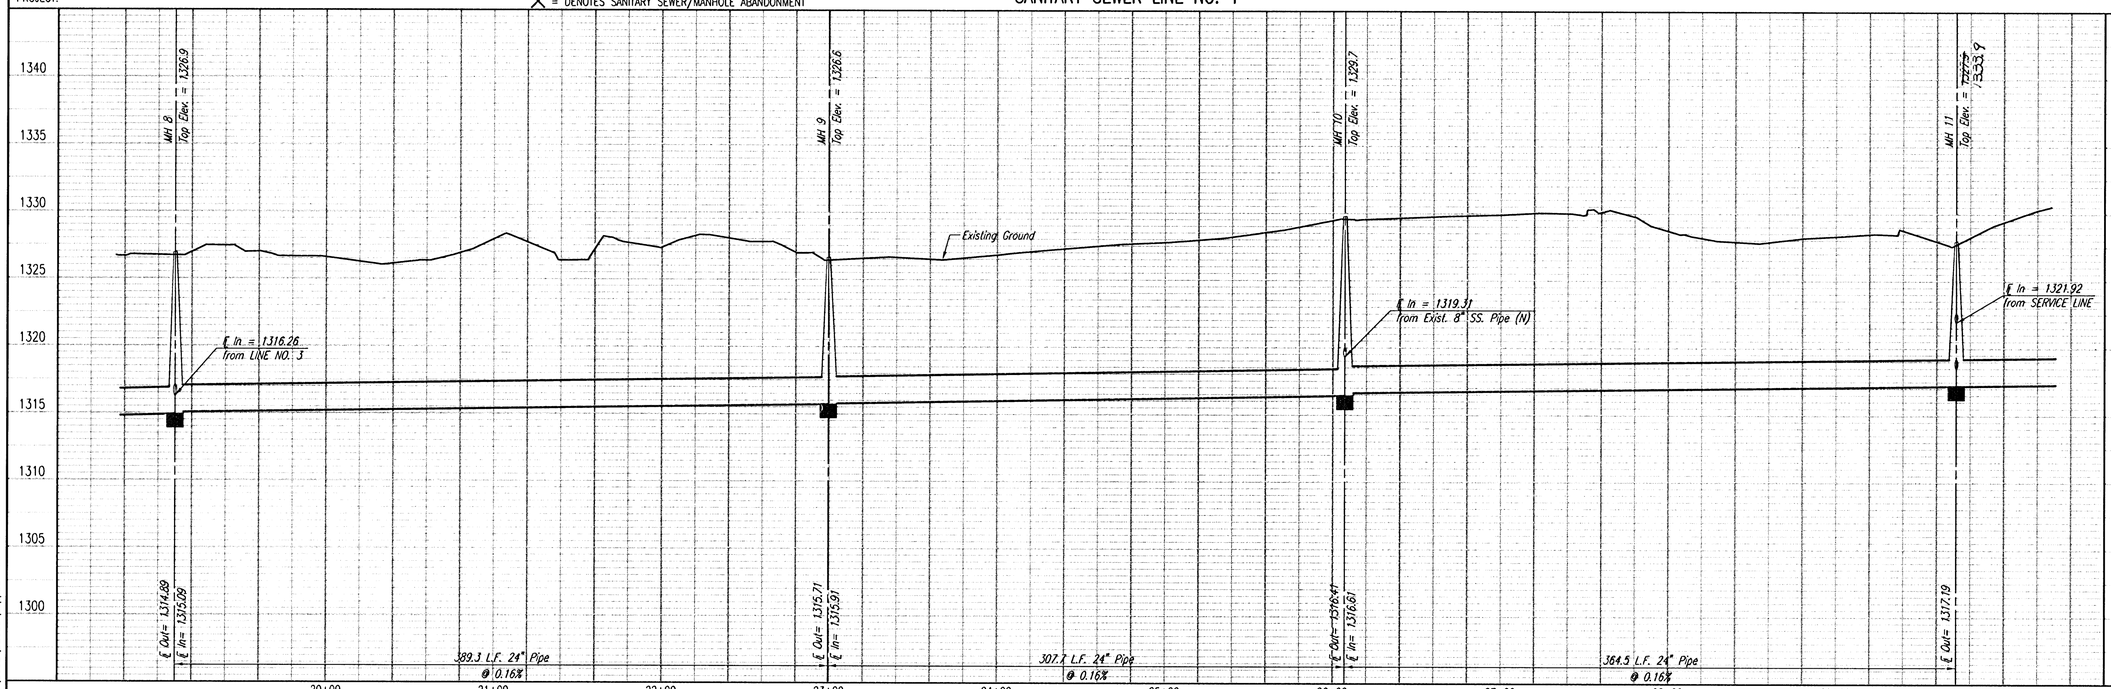

DSNR: OPER: JGA SCALE: 1=40.00
O:\2002\02633\ssbp03 09-24-2004 11:26:05 am

MAIN 17, FOUR MILE CREEK
CRESTVIEW SEWER - PHASE 1

SANITARY SEWER LINE NO. 1

JAMES L. ARMOUR, P.E. - ACTING CITY ENGINEER
CITY OF WICHITA PROJECT NO. 468-83601

Professional Engineering Consultants, P.A.
303 S. TOPEKA • WICHITA, KANSAS 67202
316-262-2691 • FAX 316-262-3003

Designed By	MDK	Job No.	35-02633-3697
Drawn By	JGA	Date	JULY 2004

Sheet 6 of 23