

BENCHMARK:
"□" CUT ON TOP OF CURB
AT WEST LINE OF LOT 7,
BLOCK A, AUBURN HILLS 5TH
ADD.
ELEV. = 1395.13 NGVD29

DISC IN BACK OF CURB,
NORTH OF FRONT CORNER
COMMON TO LOTS 23 AND 24,
BLOCK D, AUBURN HILLS 12TH
ADD.
ELEV. = 1379.24 NGVD29

"□" CUT ON CENTER OF
CATCH BASIN, NORTH OF LOT
CORNER COMMON TO LOTS 1
AND 15, BLOCK B, AUBURN
HILLS 14TH ADD.
ELEV. = 1381.05 NGVD29

Contractor to Adjust Existing
Manhole from Top Elev. = 192.60
to Top Elev. = 191.60


Sta. 0+56.0, End Line 11
End construction of 15"
RCP with end section
7 S.Y. heavy stone rip-rap

Pond #1 Data:
Static WS elev. = 190.0
100-yr WS elev. = 192.4

Sta 0+00, Begin Line 11
Begin construction of 15"
RCP with end Section
7 S.Y. heavy stone rip-rap

Contractor shall remove and
dispose of existing 4 - 24"
RCP. Cost to be included in
"Site Clearing and Restoration"
(Approx. 250 L.F. 24" RCP)

Scale: 1" = 20' Horizontal
1" = 5' Vertical
• = Iron

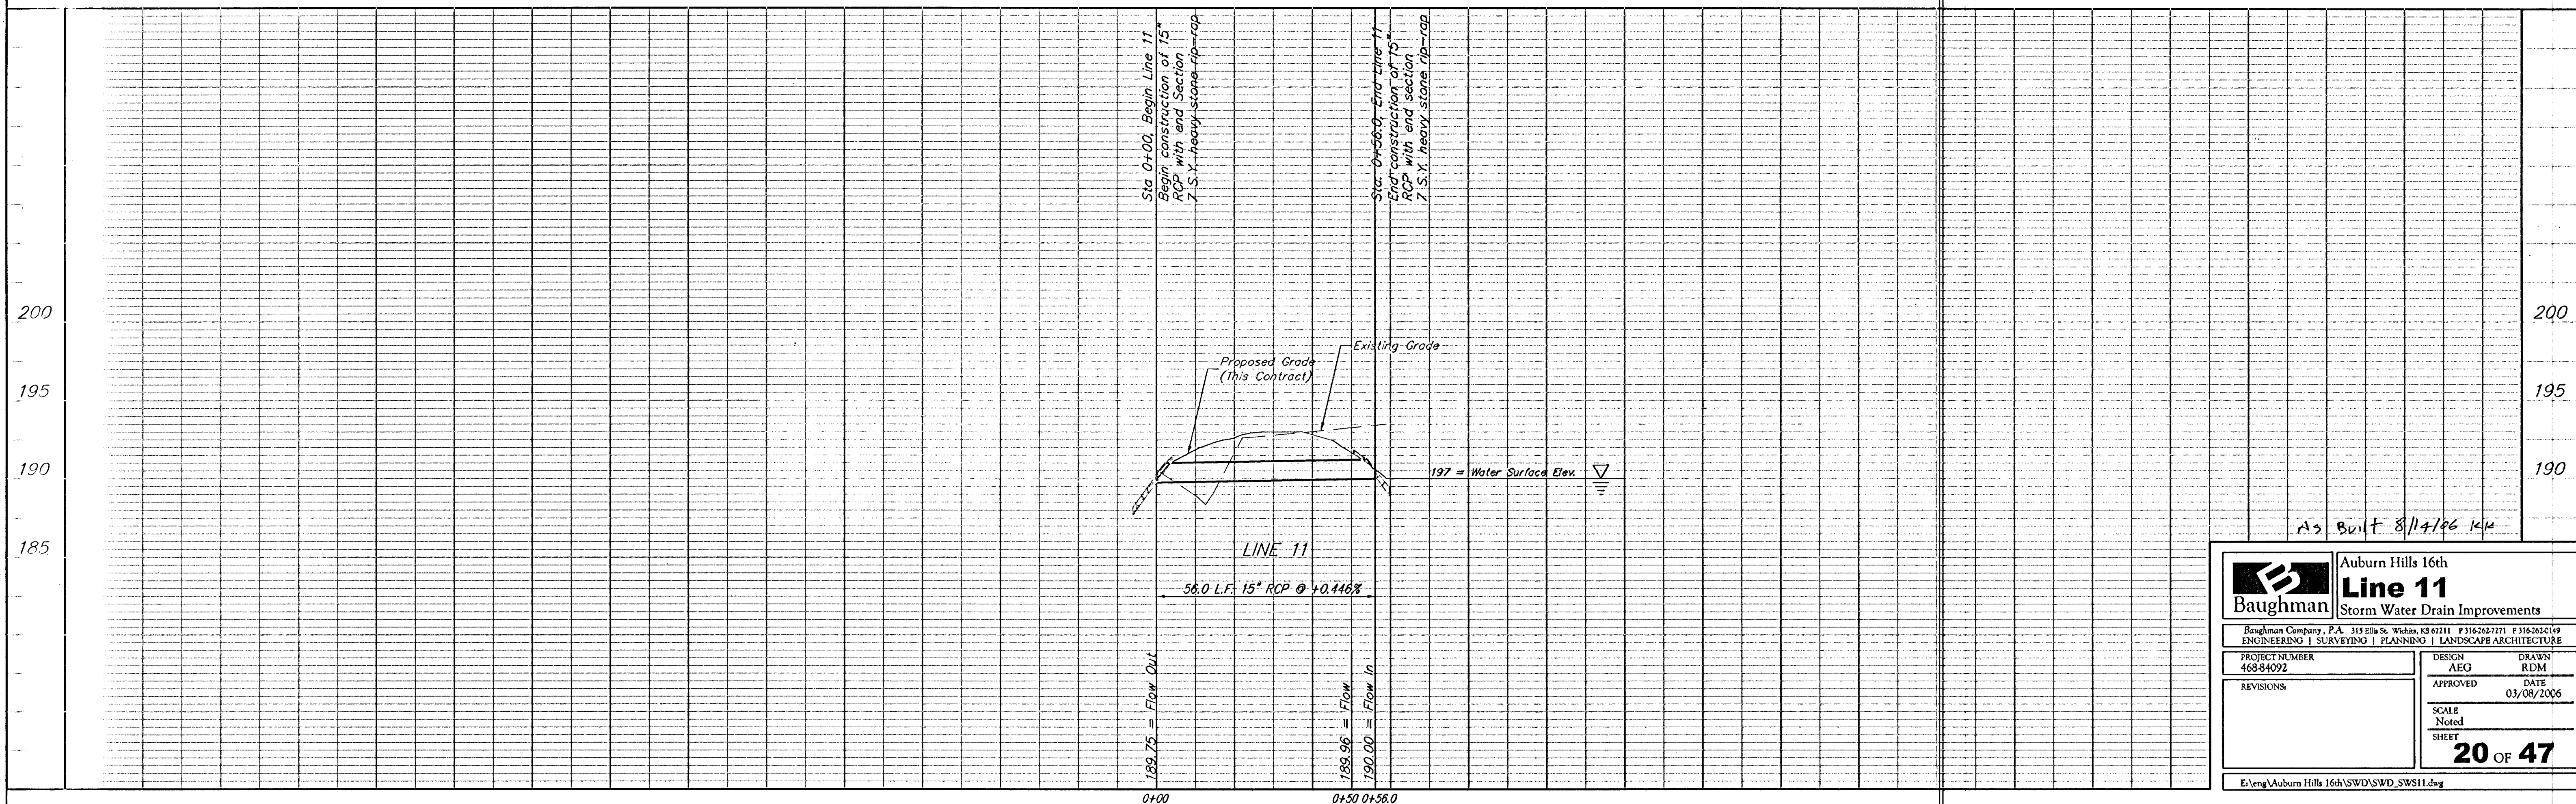

Baughman		Auburn Hills 16th Line 11 Storm Water Drain Improvements	
Baughman Company, P.A. 315 Ella St. Wichita, KS 67211 P 316-262-7271 F 316-262-0149 ENGINEERING SURVEYING PLANNING LANDSCAPE ARCHITECTURE			
PROJECT NUMBER 468-84022		DESIGN AEG	DRAWN RDM
REVISIONS		APPROVED	DATE 03/08/2006
SCALE Noted		SHEET 20 OF 47	
E:\eng\Auburn Hills 16th\SWD\SWD_SWS11.dwg			